
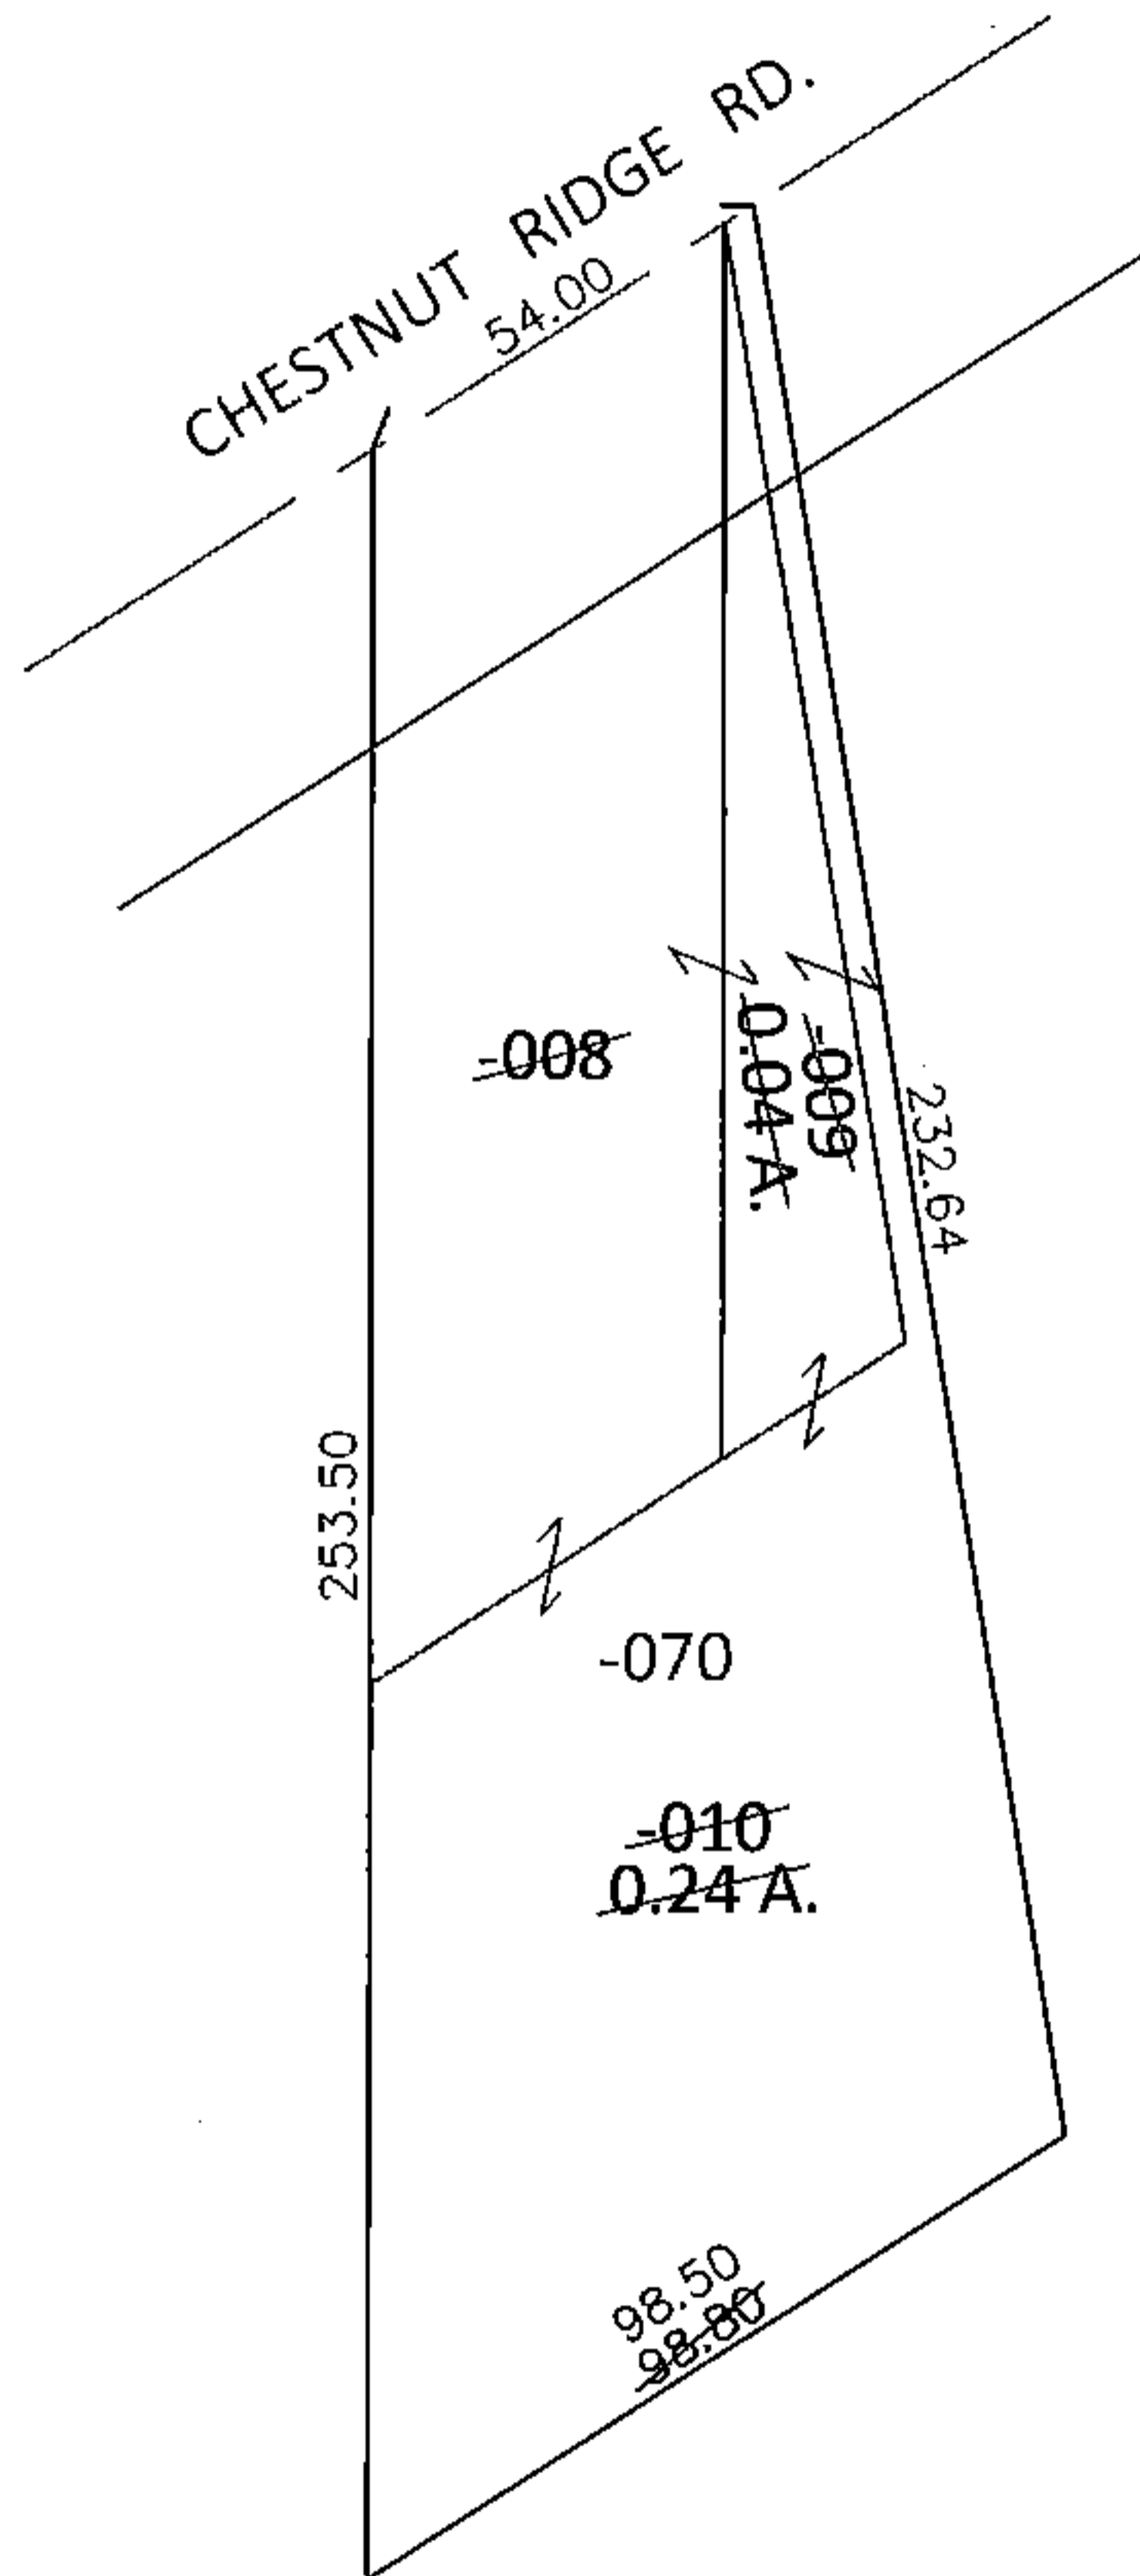


PARENT PARCEL: 07-00-023-102-008 THRU -010

CHILD PARCEL: 07-00-023-102-070

STARTING POINT: NORTHEAST CORNER OF LAND CONVEYED TO DIEDERICK & MYRTLE L. VON KAMP (DV 162/226)

15-03242-C

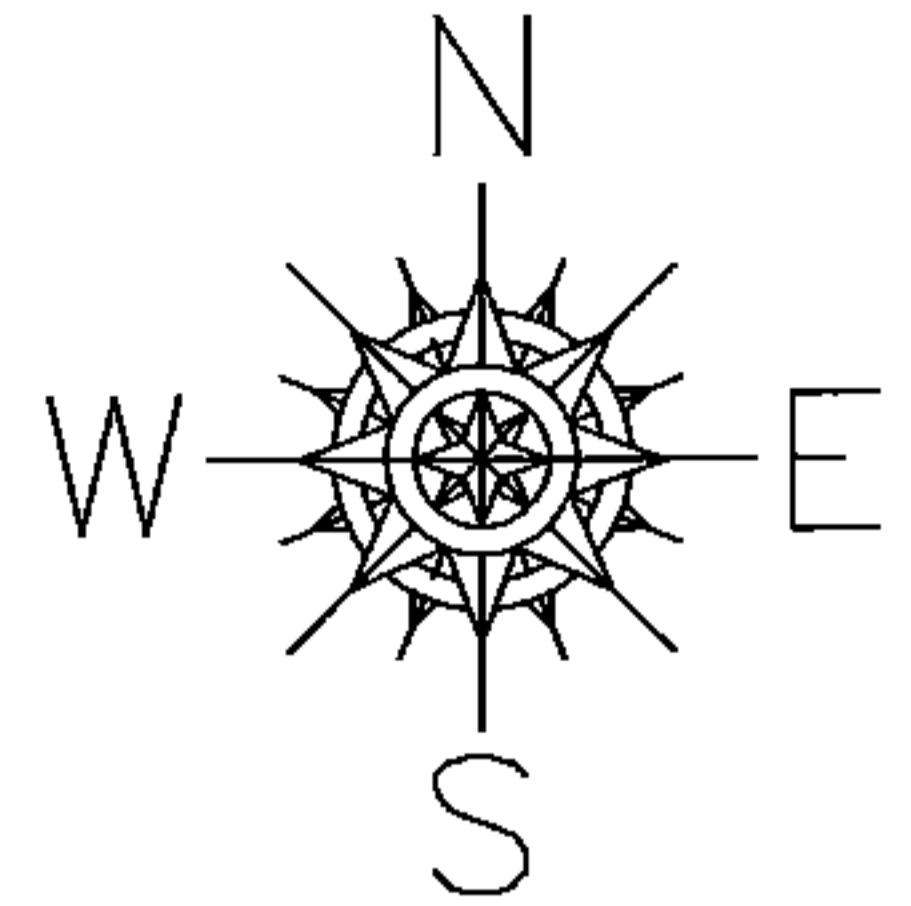


COMBINATION CORRECTION

~~07-00-023-102-008~~
~~50 X 147~~

~~07-00-023-102-009~~
~~0.04 A.~~

~~07-00-023-102-010~~
~~0.24 A.~~

07-00-023-102-070
54 X 253.50

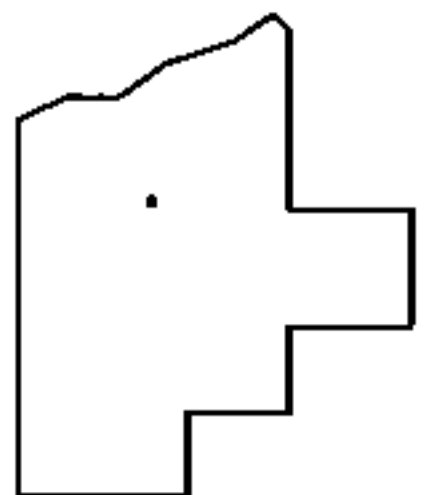

SPLITS/DEEDS PROCESSED

LORAIN COUNTY TAX MAP DEPARTMENT
226 MIDDLE AVE. ELYRIA, OHIO

SURVEYED BY: N/A

CLOSURE: N/A

MAP PAGE(S): 7-00-023-D

APPROVED BY: RRM DATE: 6-26-15

SCALE: 1"= 50' PRIOR INST.: 20150548379