

PARENT PARCEL: 03-00-034-101-001, 03-00-035-101-021 & 03-00-035-102-029

CHILD PARCEL: 03-00-035-102-030

STARTING POINT: CL OF LAKE RD. & EAST LINE OF O.L. 35

14-03242

COMBINATION

AC. CORR

~~03-00-035-101-021~~

03-00-034-101-001

~~75 X 15~~

~~1.22 A.~~

~~03-00-035-102-029~~



0.99 A.

~~414.47 X 550~~

CORR. PER SURV.
EDWARD DUDLEY III

03-00-035-102-030

5.04 A.

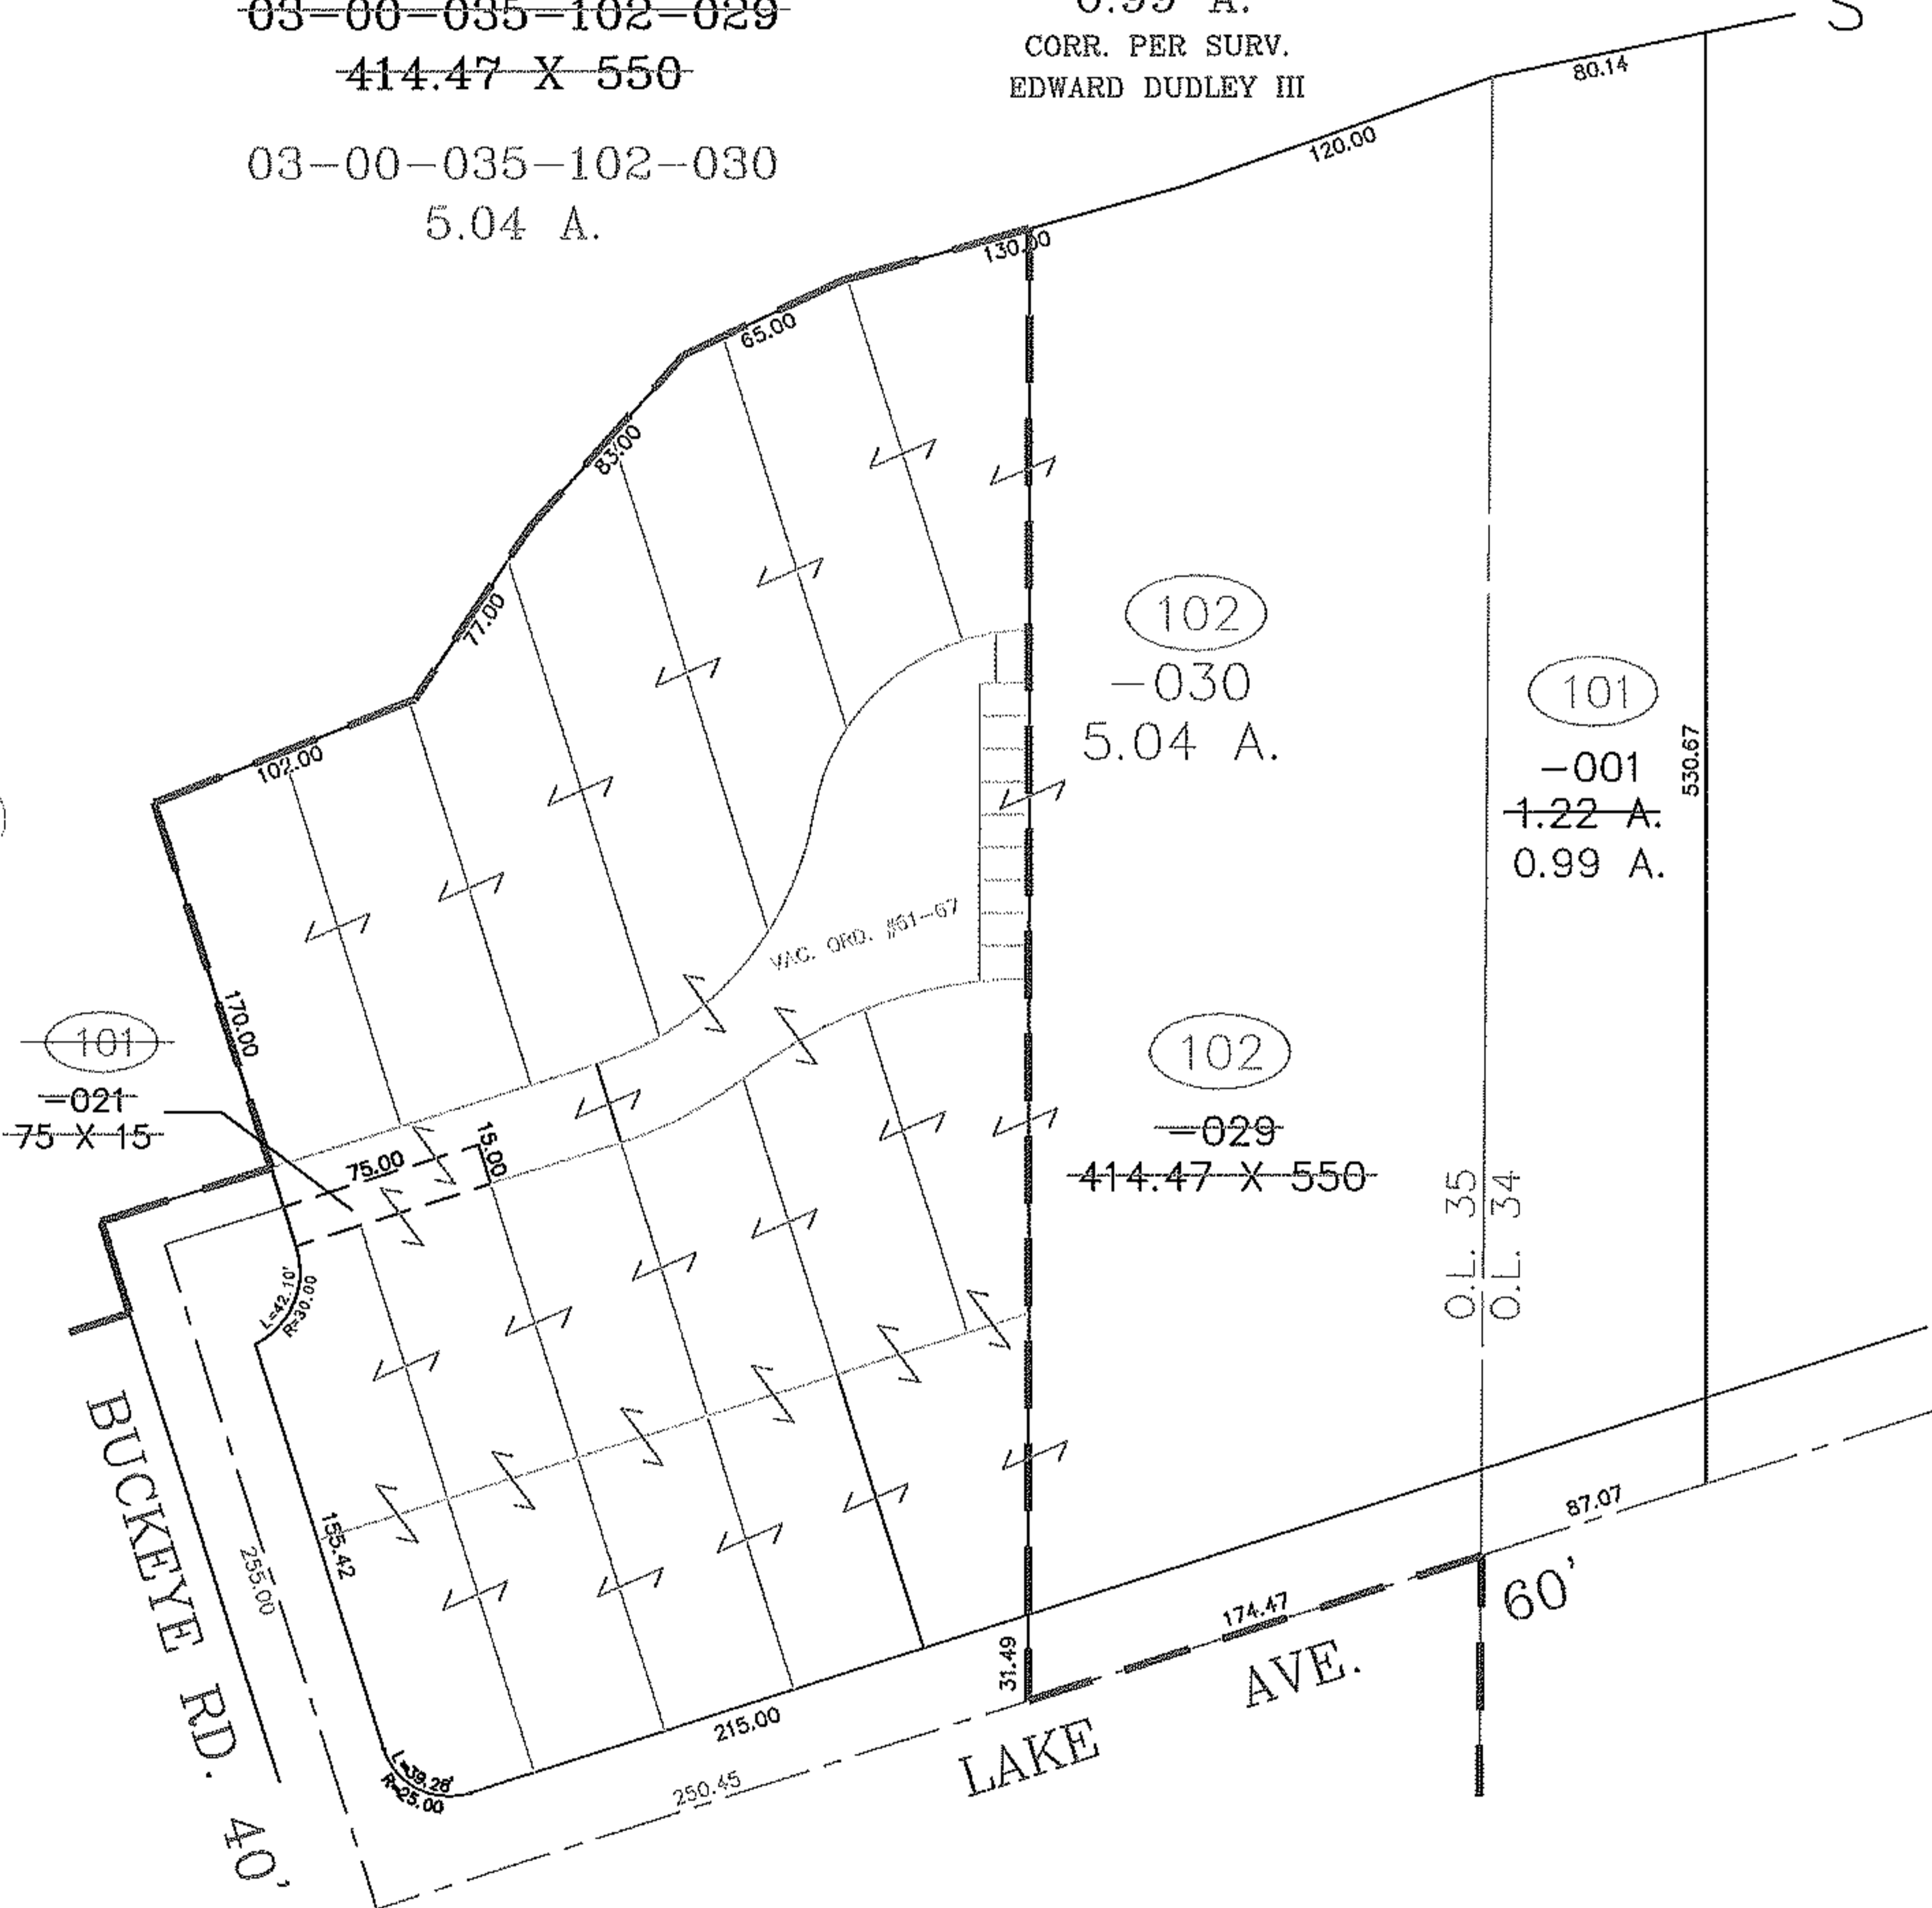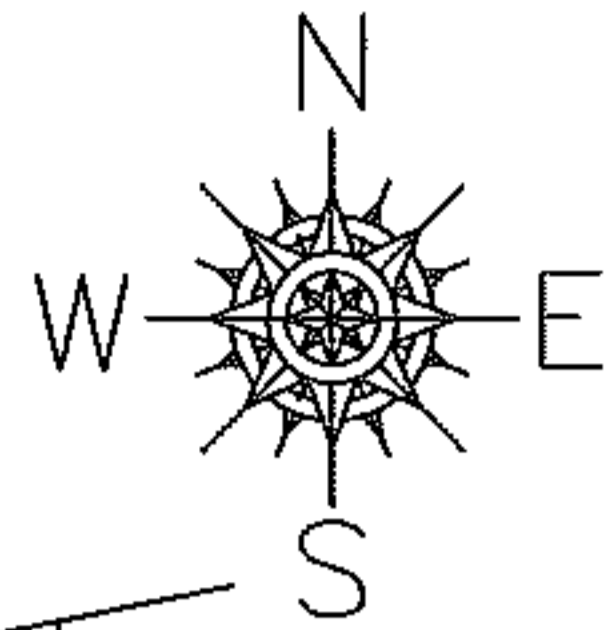

SPLITS/DEEDS PROCESSED

LORAIN COUNTY TAX MAP DEPARTMENT
226 MIDDLE AVE. ELYRIA, OHIO

SURVEYED BY: EDWARD B. DUDLEY III

CLOSURE: 0.01 : 10,000

MAP PAGE(S): 3-00-034 & -035

APPROVED BY: TJS DATE: 4/10/14

SCALE: 1" = 100 PRIOR INSTRUMENT: 19980540077