
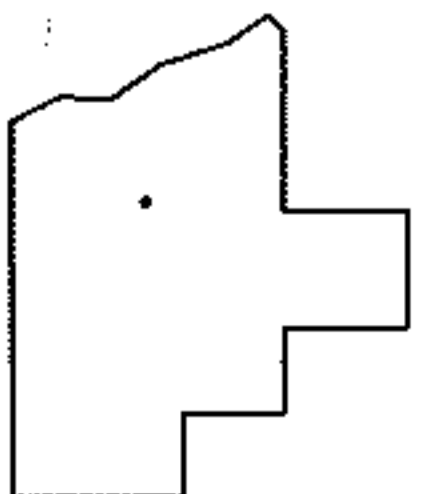
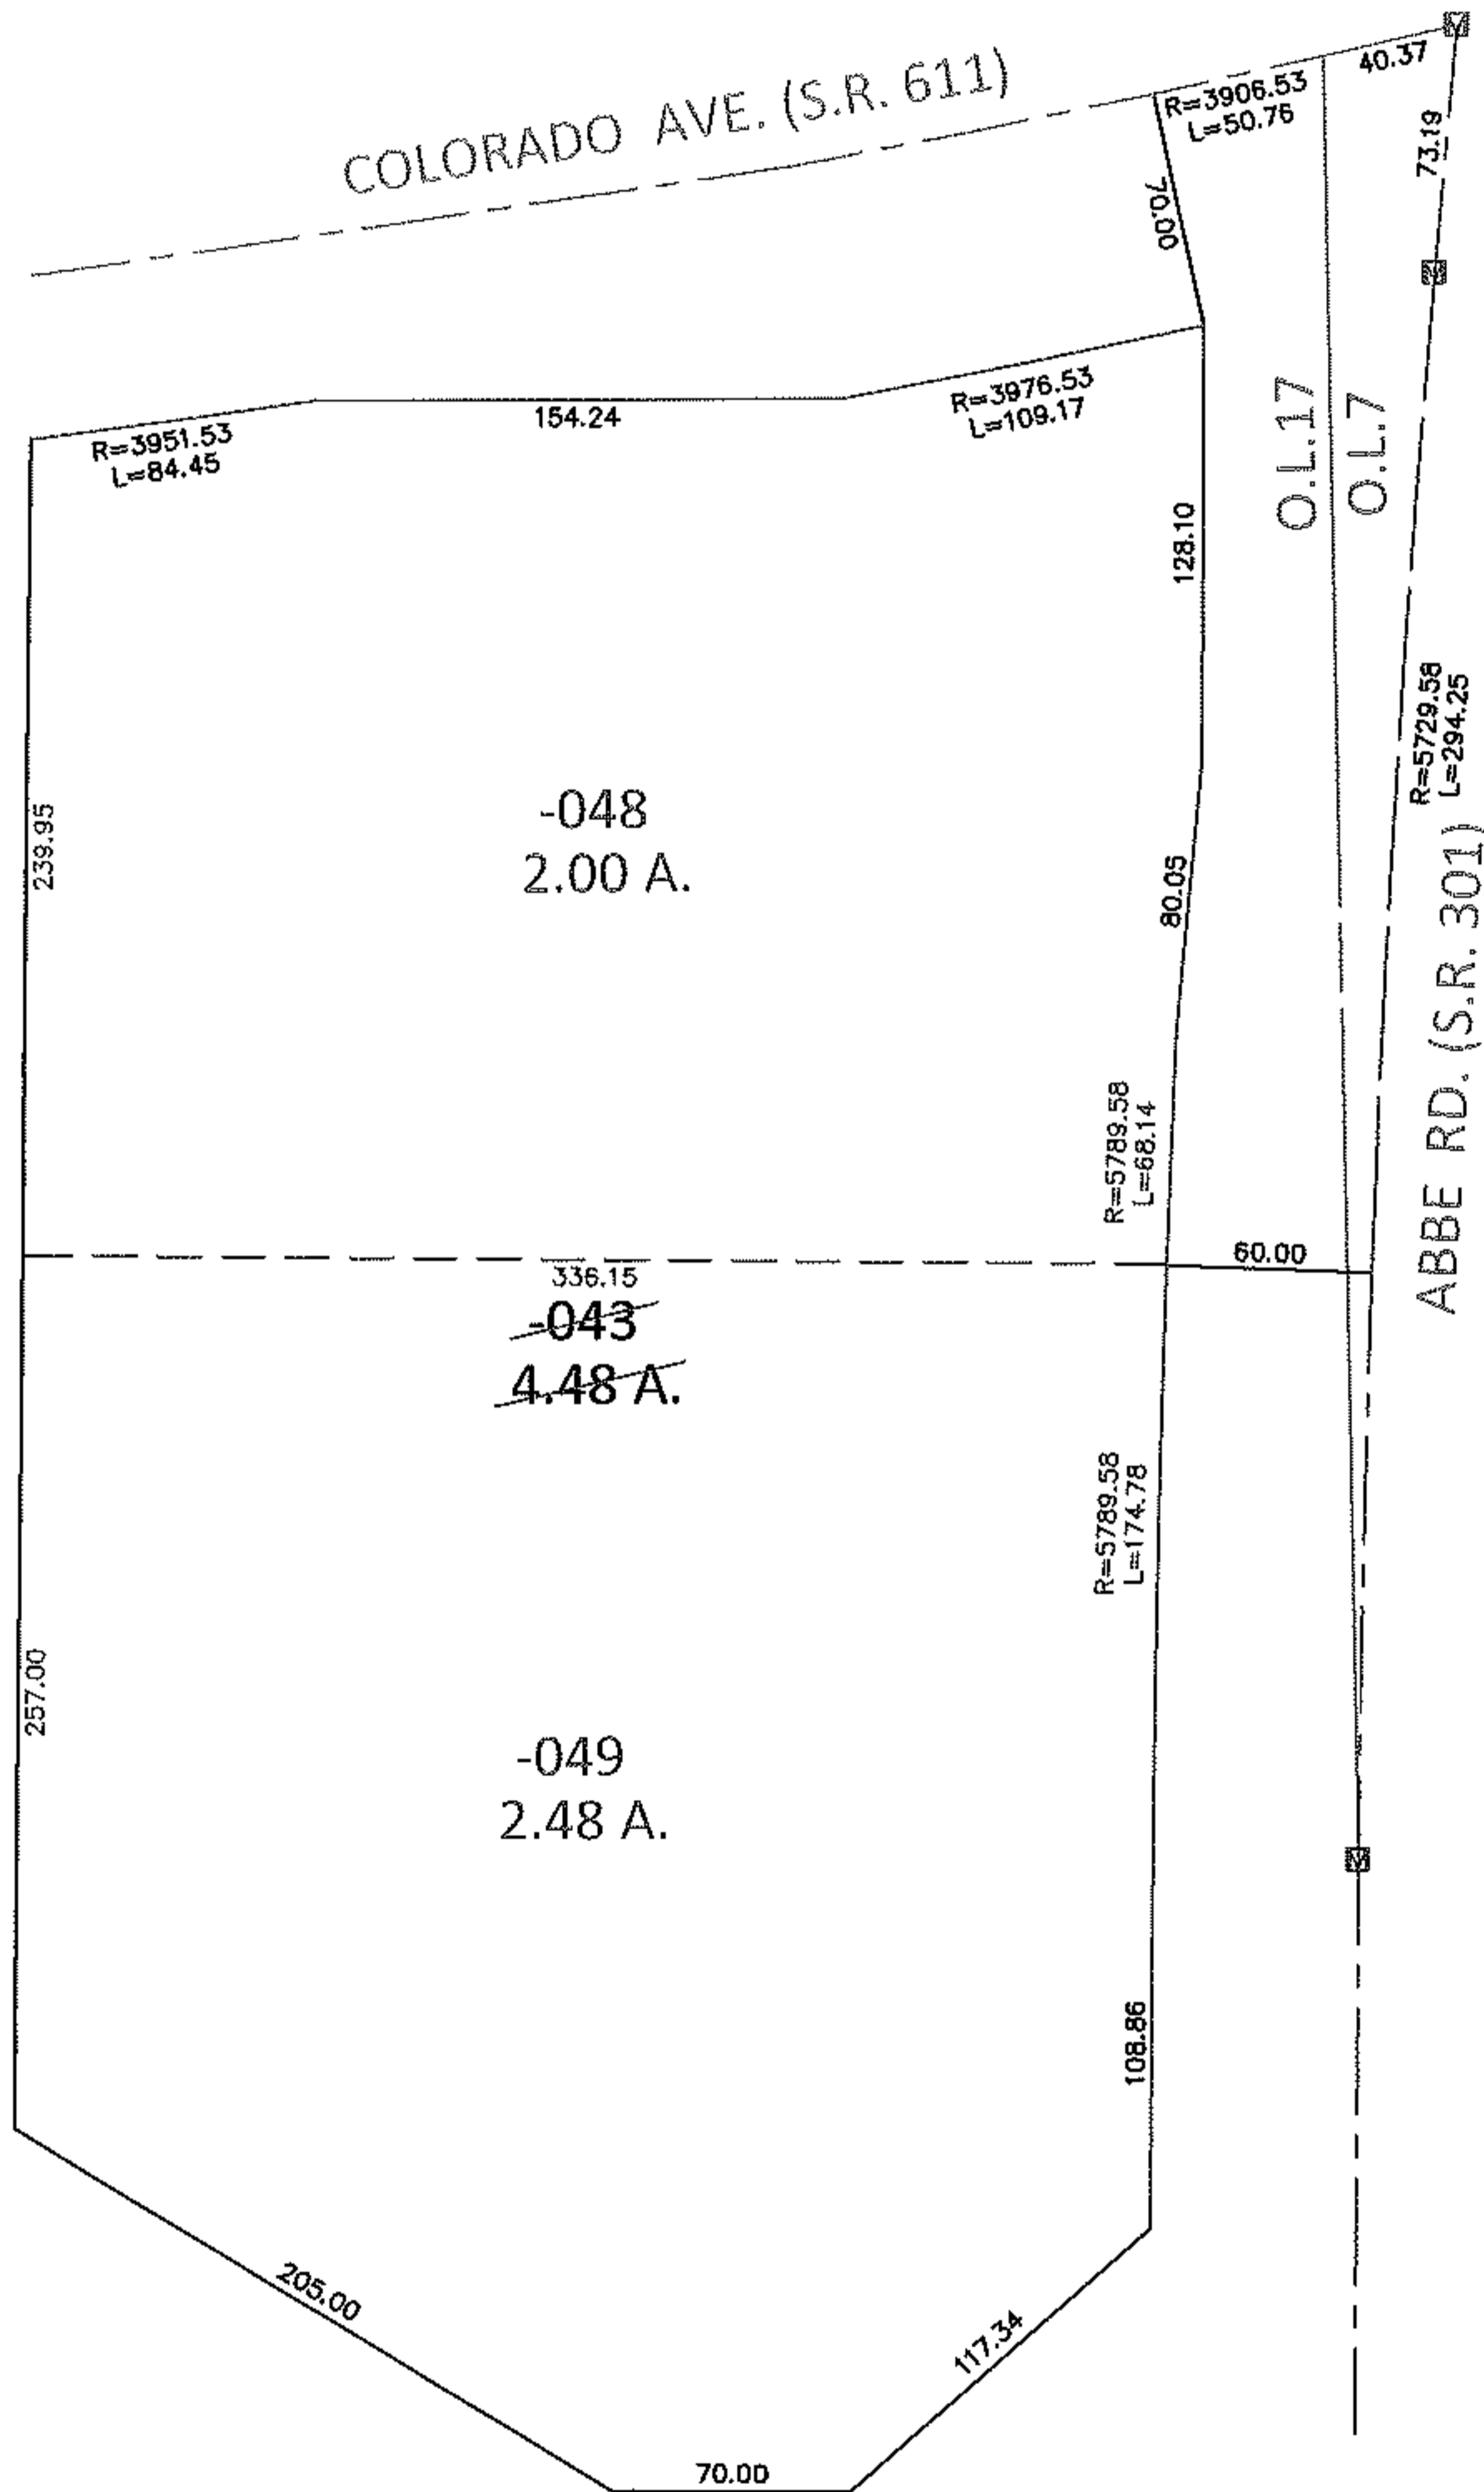


PARENT PARCEL: 03-00-017-102-043

CHILD PARCEL: 03-00-017-102-048,-049

14-03243

STARTING POINT: AT A MON BOX AT THE INTERSECTION OF C/L OF S.R.611 AND C/L OF S.R.301

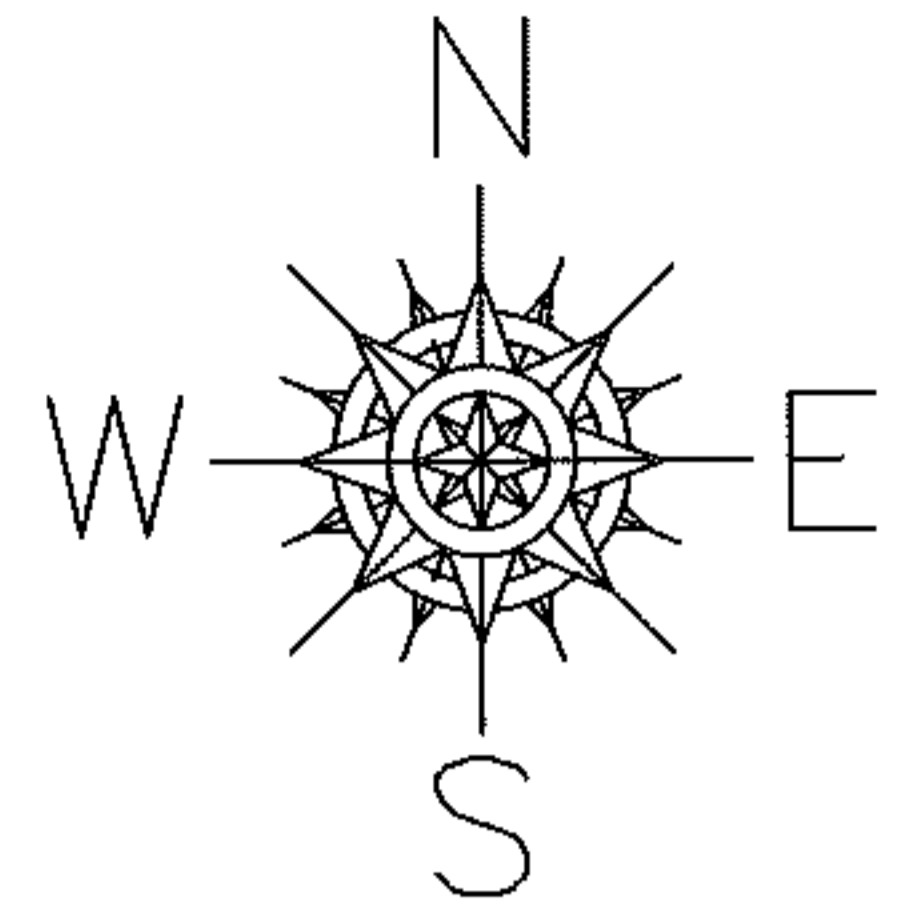

**SPLITS/DEEDS PROCESSED**

LORAIN COUNTY TAX MAP DEPARTMENT  
226 MIDDLE AVE. ELYRIA, OHIO

SURVEYED BY: CHRISTOPHER J. TOMKO

CLOSURE: .01:10,000

MAP PAGE(S): 3-00-017-B

APPROVED BY: RRM DATE: 4-15-14

SCALE: 1"= 100

PRIOR INST.: