


PARENT PARCEL: 02-01-003-120-022 THRU -026, -015, -016

CHILD PARCEL: 02-01-003-120-024, -025, -026, -036 THRU -040

STARTING POINT: SOUTHEAST CORNER OF S/L 10 IN SELAH CHAMBERLAIN TRUSTEE ALLOT. (VOL.2 PG.11)


15-03244-D

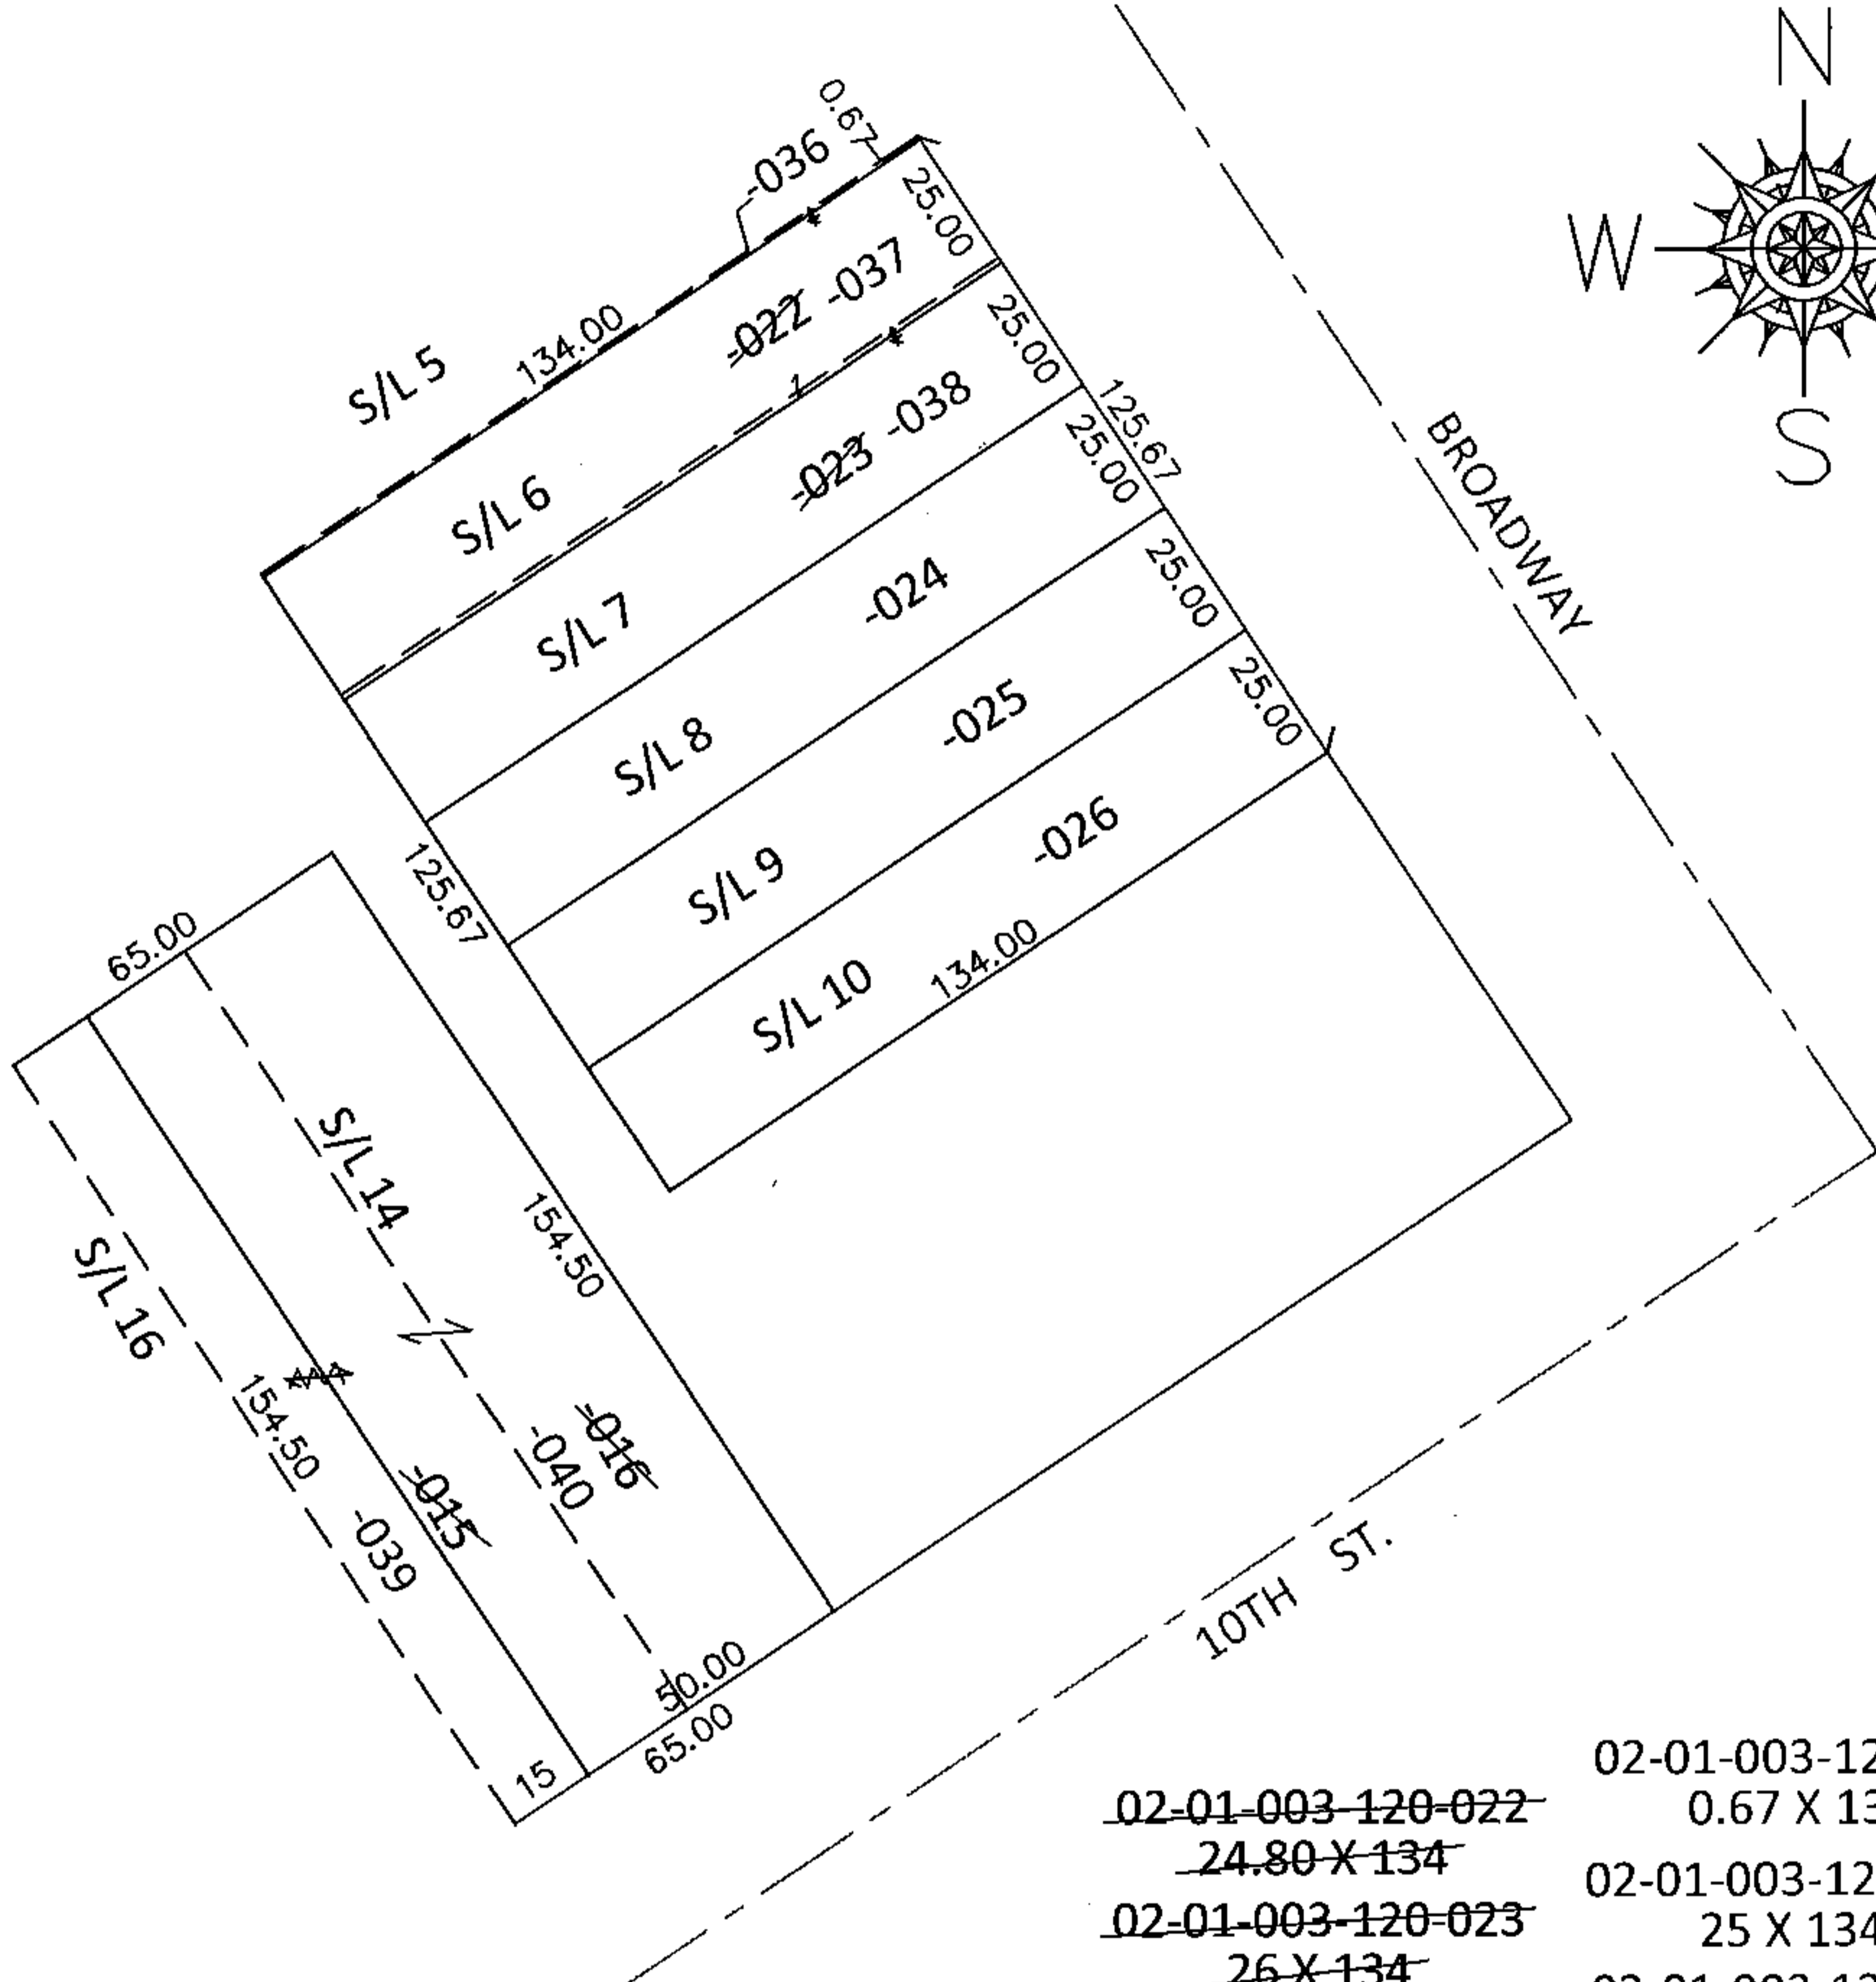

02-01-003-120-015 35 X 154	02-01-003-120-039 15 X 154.50
02-01-003-120-016 35 X 154	02-01-003-120-040 50 X 154.50

02-01-003-120-022 24.80 X 134	02-01-003-120-036 0.67 X 134
02-01-003-120-023 26 X 134	02-01-003-120-037 25 X 134
	02-01-003-120-038 25 X 134

PARCEL NUMBER CORRECTION

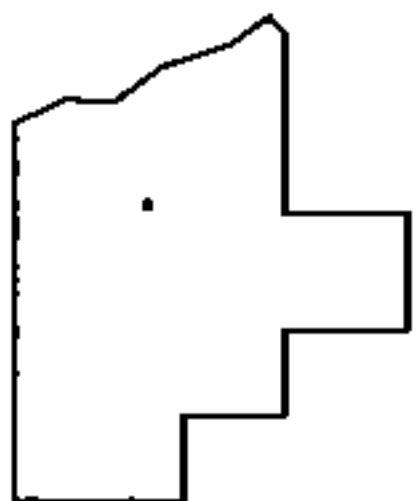

SPLITS/DEEDS PROCESSED

LORAIN COUNTY TAX MAP DEPARTMENT
226 MIDDLE AVE. ELYRIA, OHIO

SURVEYED BY: DALE R. HAYWOOD
 CLOSURE: .00:10,000
 MAP PAGE(S): 2-01-003-C
 APPROVED BY: RRM DATE: 7-10-15
 SCALE: 1"= 50' PRIOR INST.: 20020815041