


PARENT PARCEL: 09-00-085-106-010
CHILD PARCEL: XX-XX-XXX-XXX-XXX
STARTING POINT: NORTH R.O.W. OF COLLEGE ST. & EAST R.O.W. OF CEDAR ST.


15-03245-C

FRONTAGE CORRECTION


09-00-085-106-010
~~66.00 X 136.50~~
57.00 X 136.50
PER INST. # 2014-053763
WARDEN SURVEY IMAGE # 46589

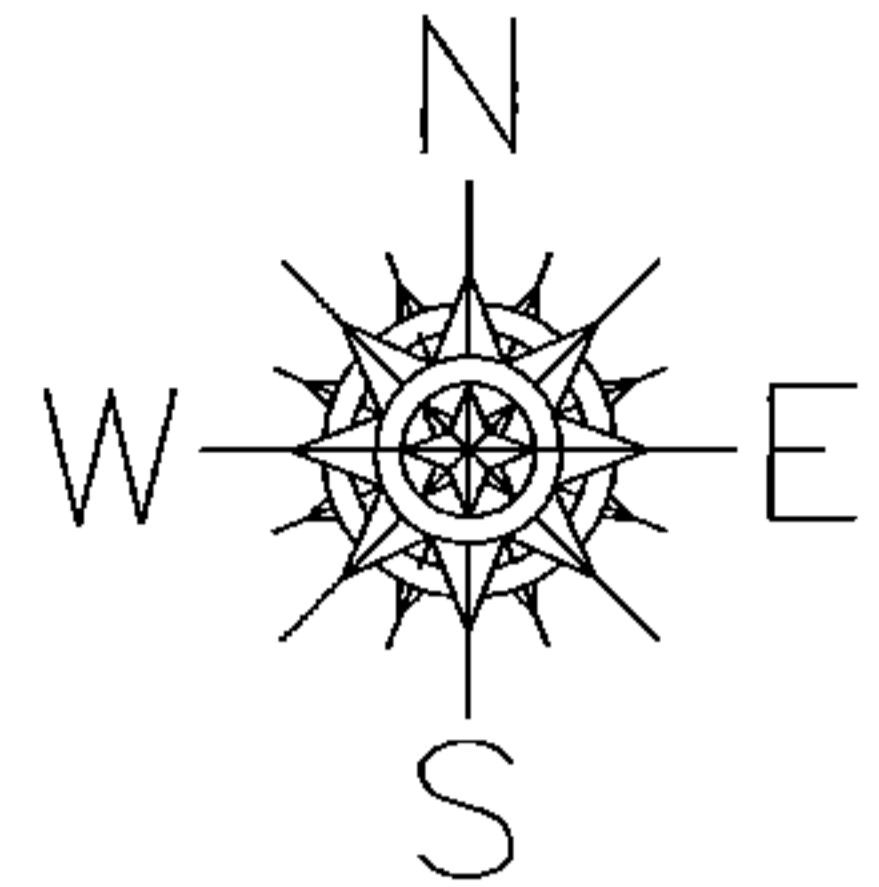

N. CEDAR ST. 54'

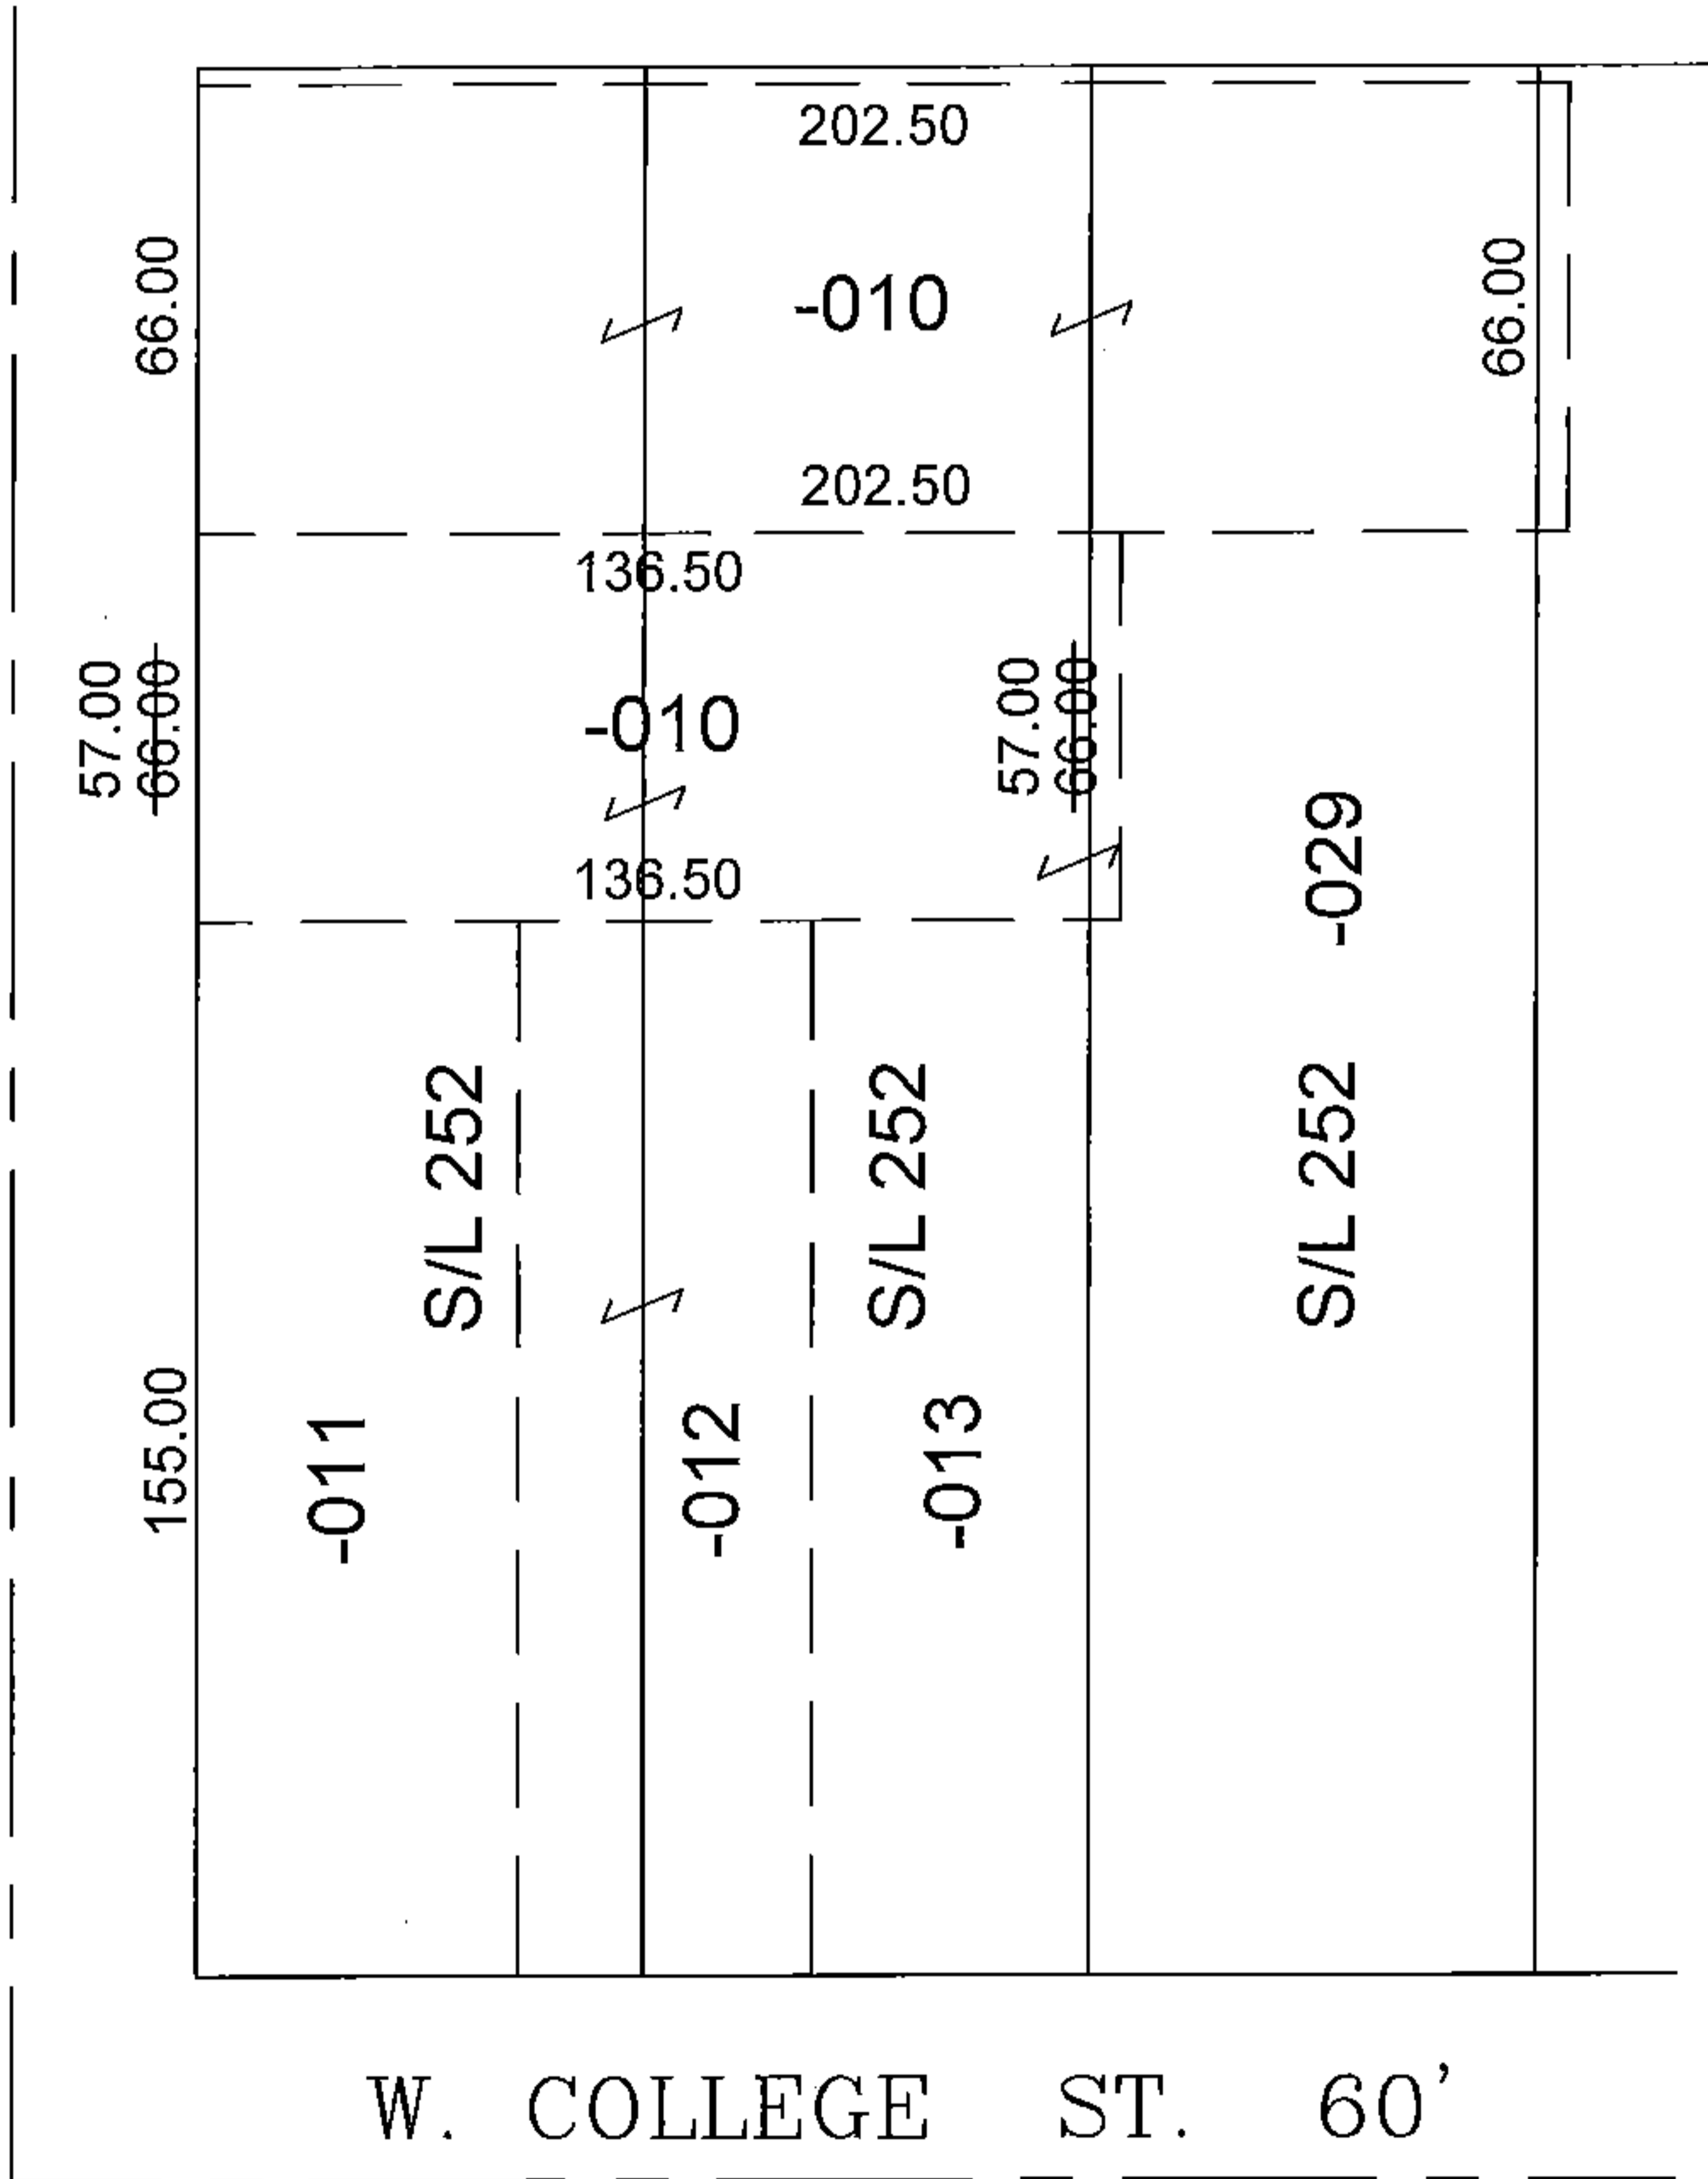

W. COLLEGE ST. 60'

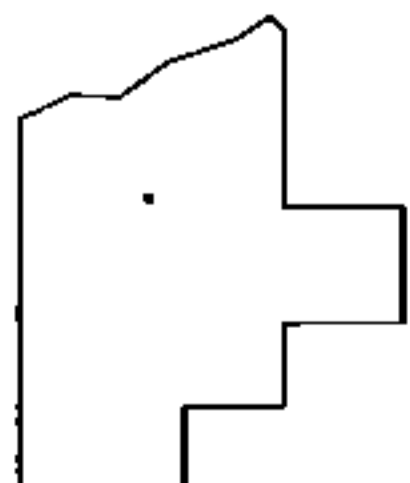

SPLITS/DEEDS PROCESSED

LORAIN COUNTY TAX MAP DEPARTMENT
226 MIDDLE AVE. ELYRIA, OHIO

SURVEYED BY: WARDEN
CLOSURE: 0.00 : 10,000
MAP PAGE(S): 09-00-085
APPROVED BY: TJS DATE: 7/14/15
SCALE: 1"=50' PRIOR INST.: DV 1179/275