
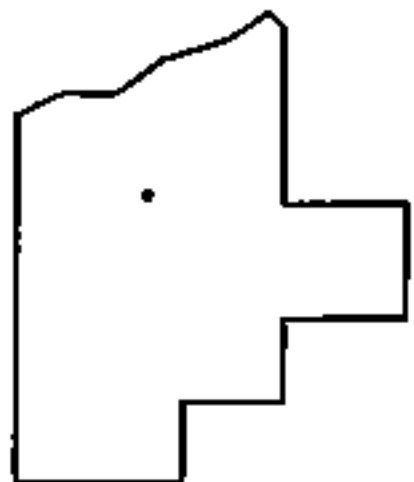
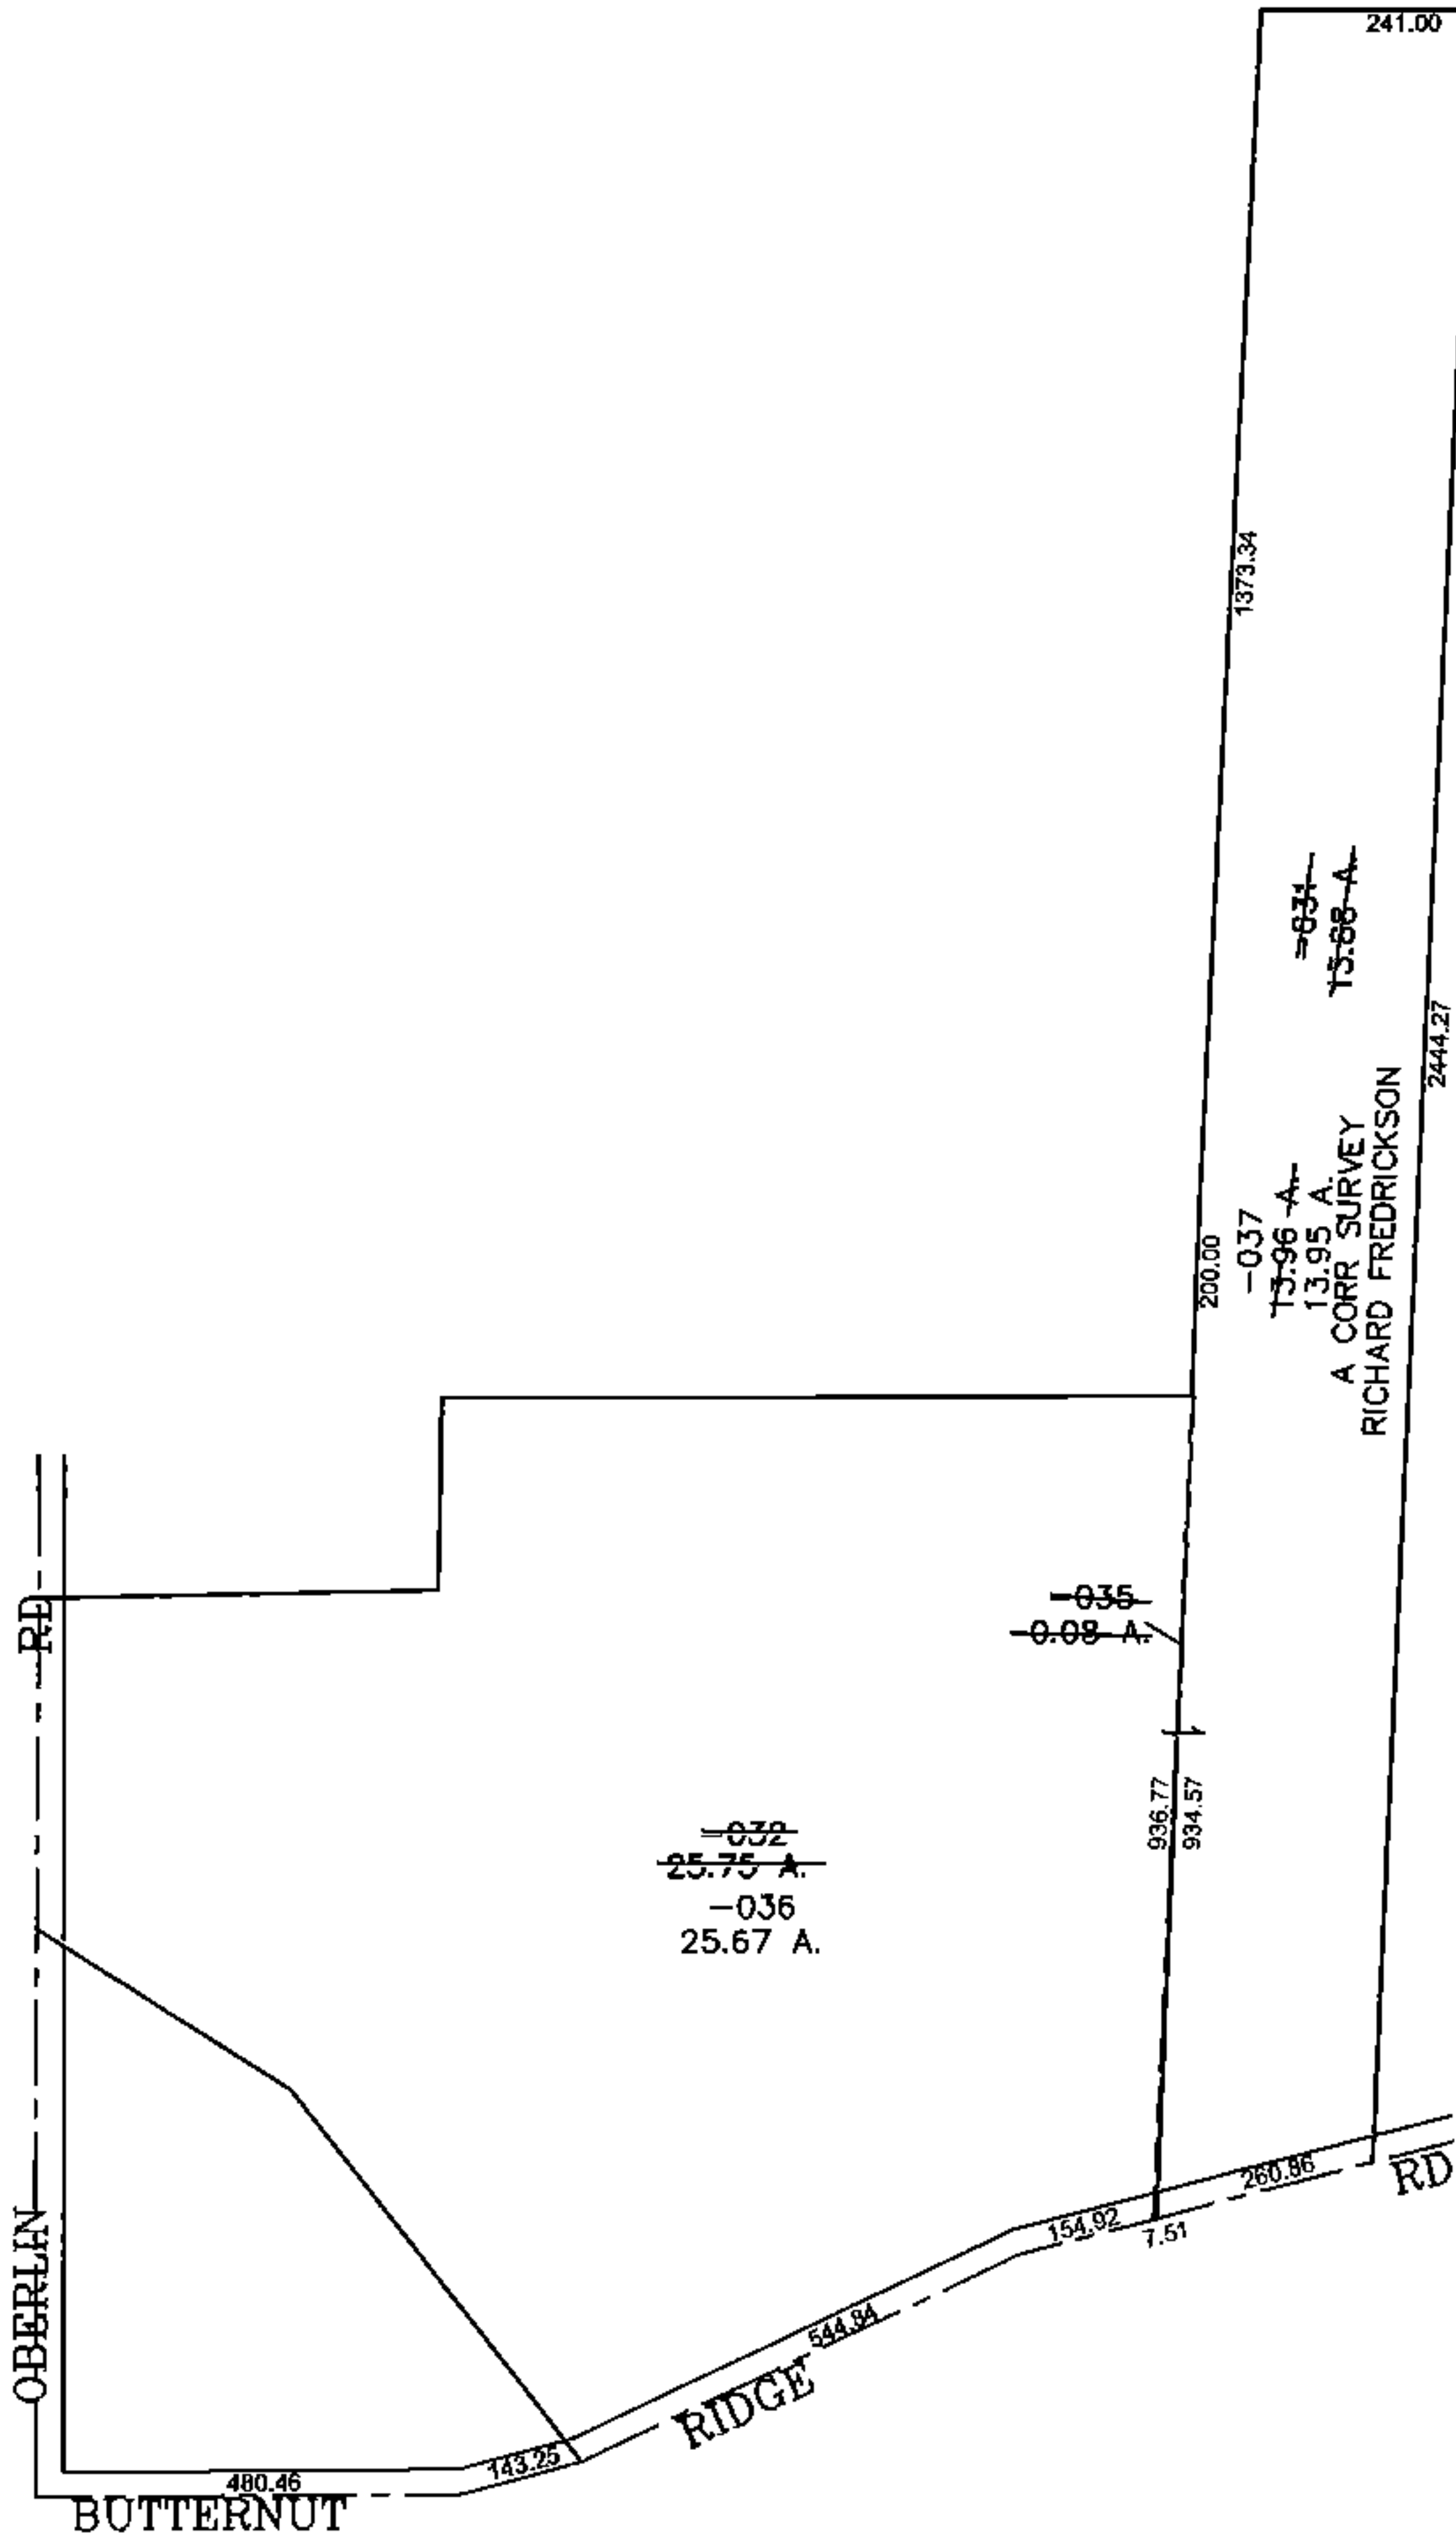


PARENT PARCEL: 09-00-058-000-032, -031

CHILD PARCEL: 09-00-058-000-035, -036, -037

STARTING POINT: CENTERLINE OF BUTTERNUT RIDGE RD & OBERLIN RD

14-03247

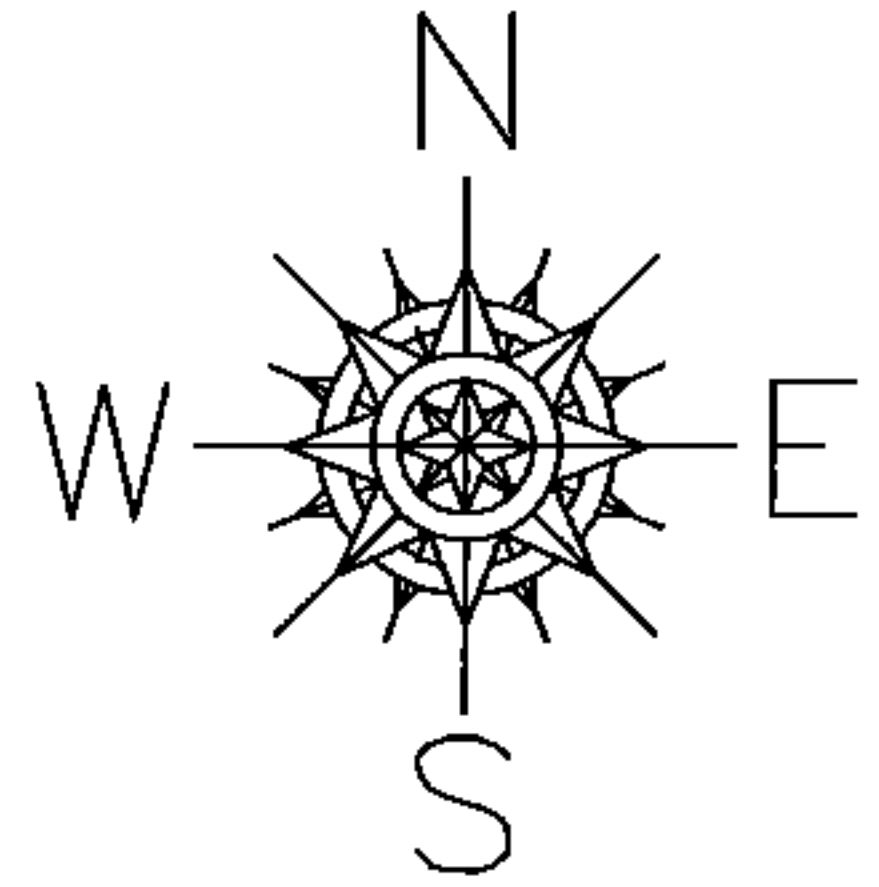

**SPLITS/DEEDS PROCESSED**

LORAIN COUNTY TAX MAP DEPARTMENT  
226 MIDDLE AVE. ELYRIA, OHIO

SURVEYED BY: RICHARD FREDRICKSON

CLOSURE: 0.00 : 10.000

MAP PAGE(S): 09-00-058

APPROVED BY: JAH DATE: 5-1-2014

SCALE: 1" = 400 PRIOR INST.: 20020817190