
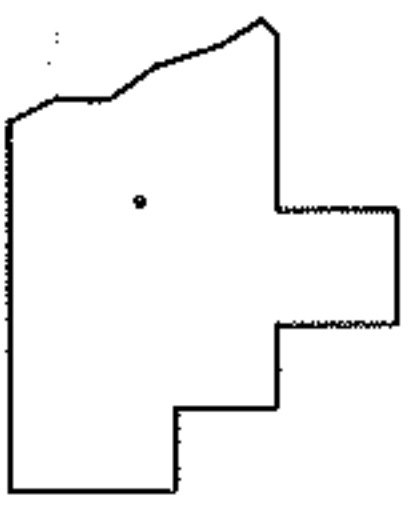
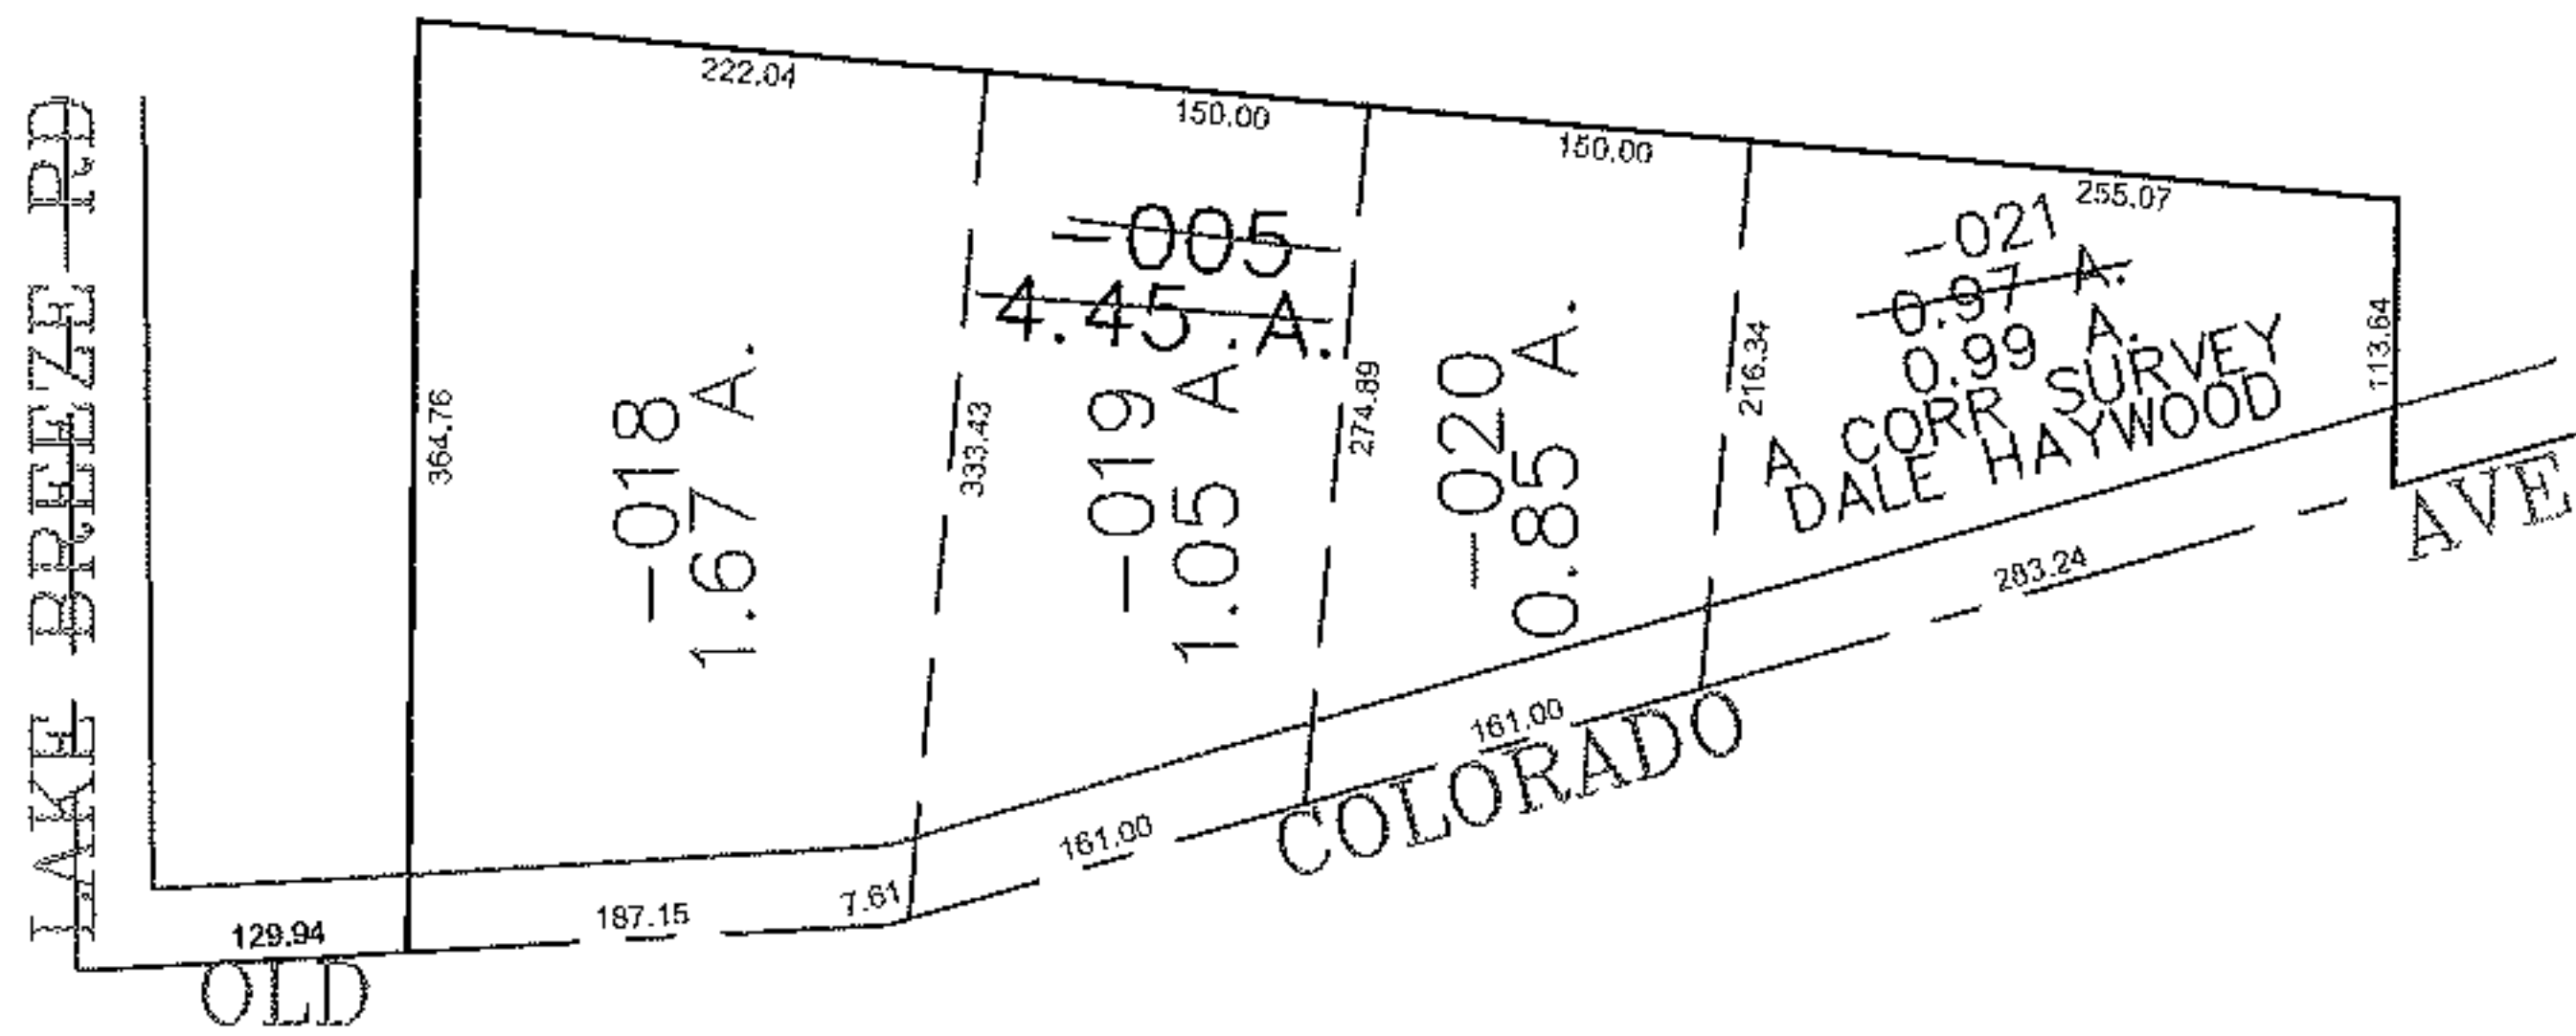


PARENT PARCEL: 03-00-064-000-005

CHILD PARCEL: 03-00-064-000-018, -019, -020, -021

STARTING POINT: CENTERLINE OF LAKE BREEZE RD & OLD COLORADO AVE

14-03248

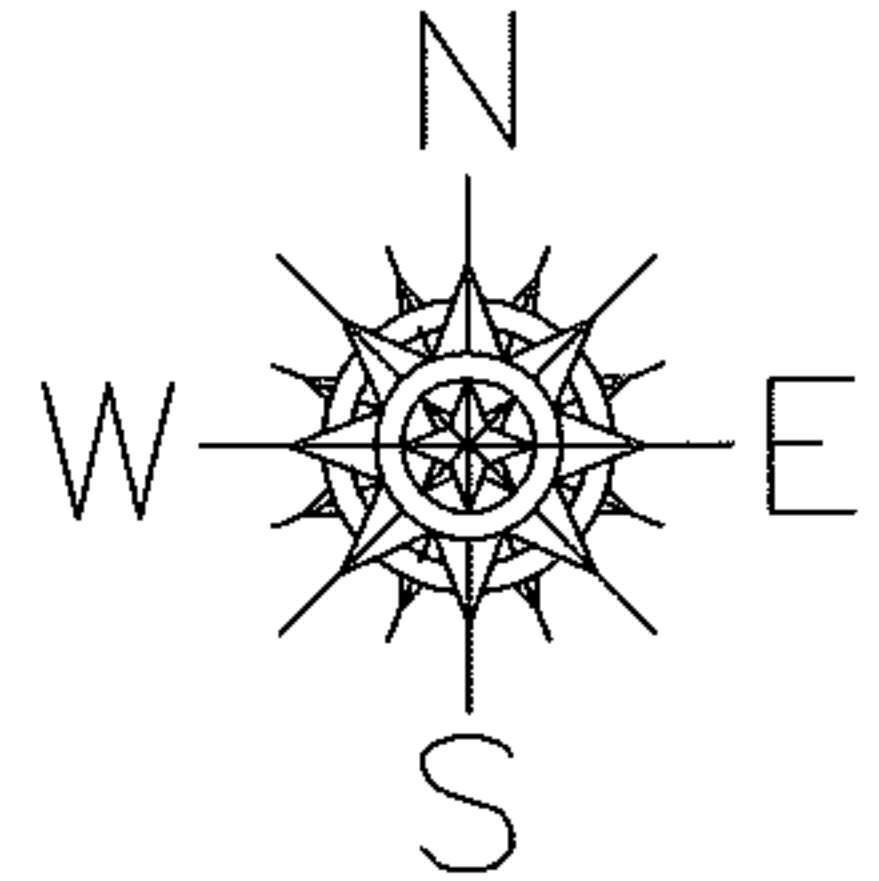

**SPLITS/DEEDS PROCESSED**  
 LORAIN COUNTY TAX MAP DEPARTMENT  
 226 MIDDLE AVE. ELYRIA, OHIO

SURVEYED BY: DALE HAYWOOD  
 CLOSURE: 0.00 : 10,000  
 MAP PAGE(S): 03-00-064-A  
 APPROVED BY: JAH DATE: 5-1-2014  
 SCALE: 1" = 200 PRIOR INSTRUMENT: 19970509556