
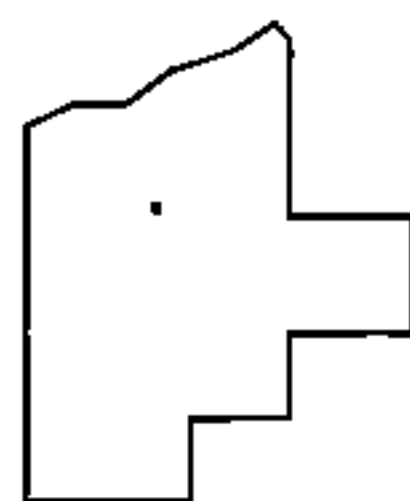
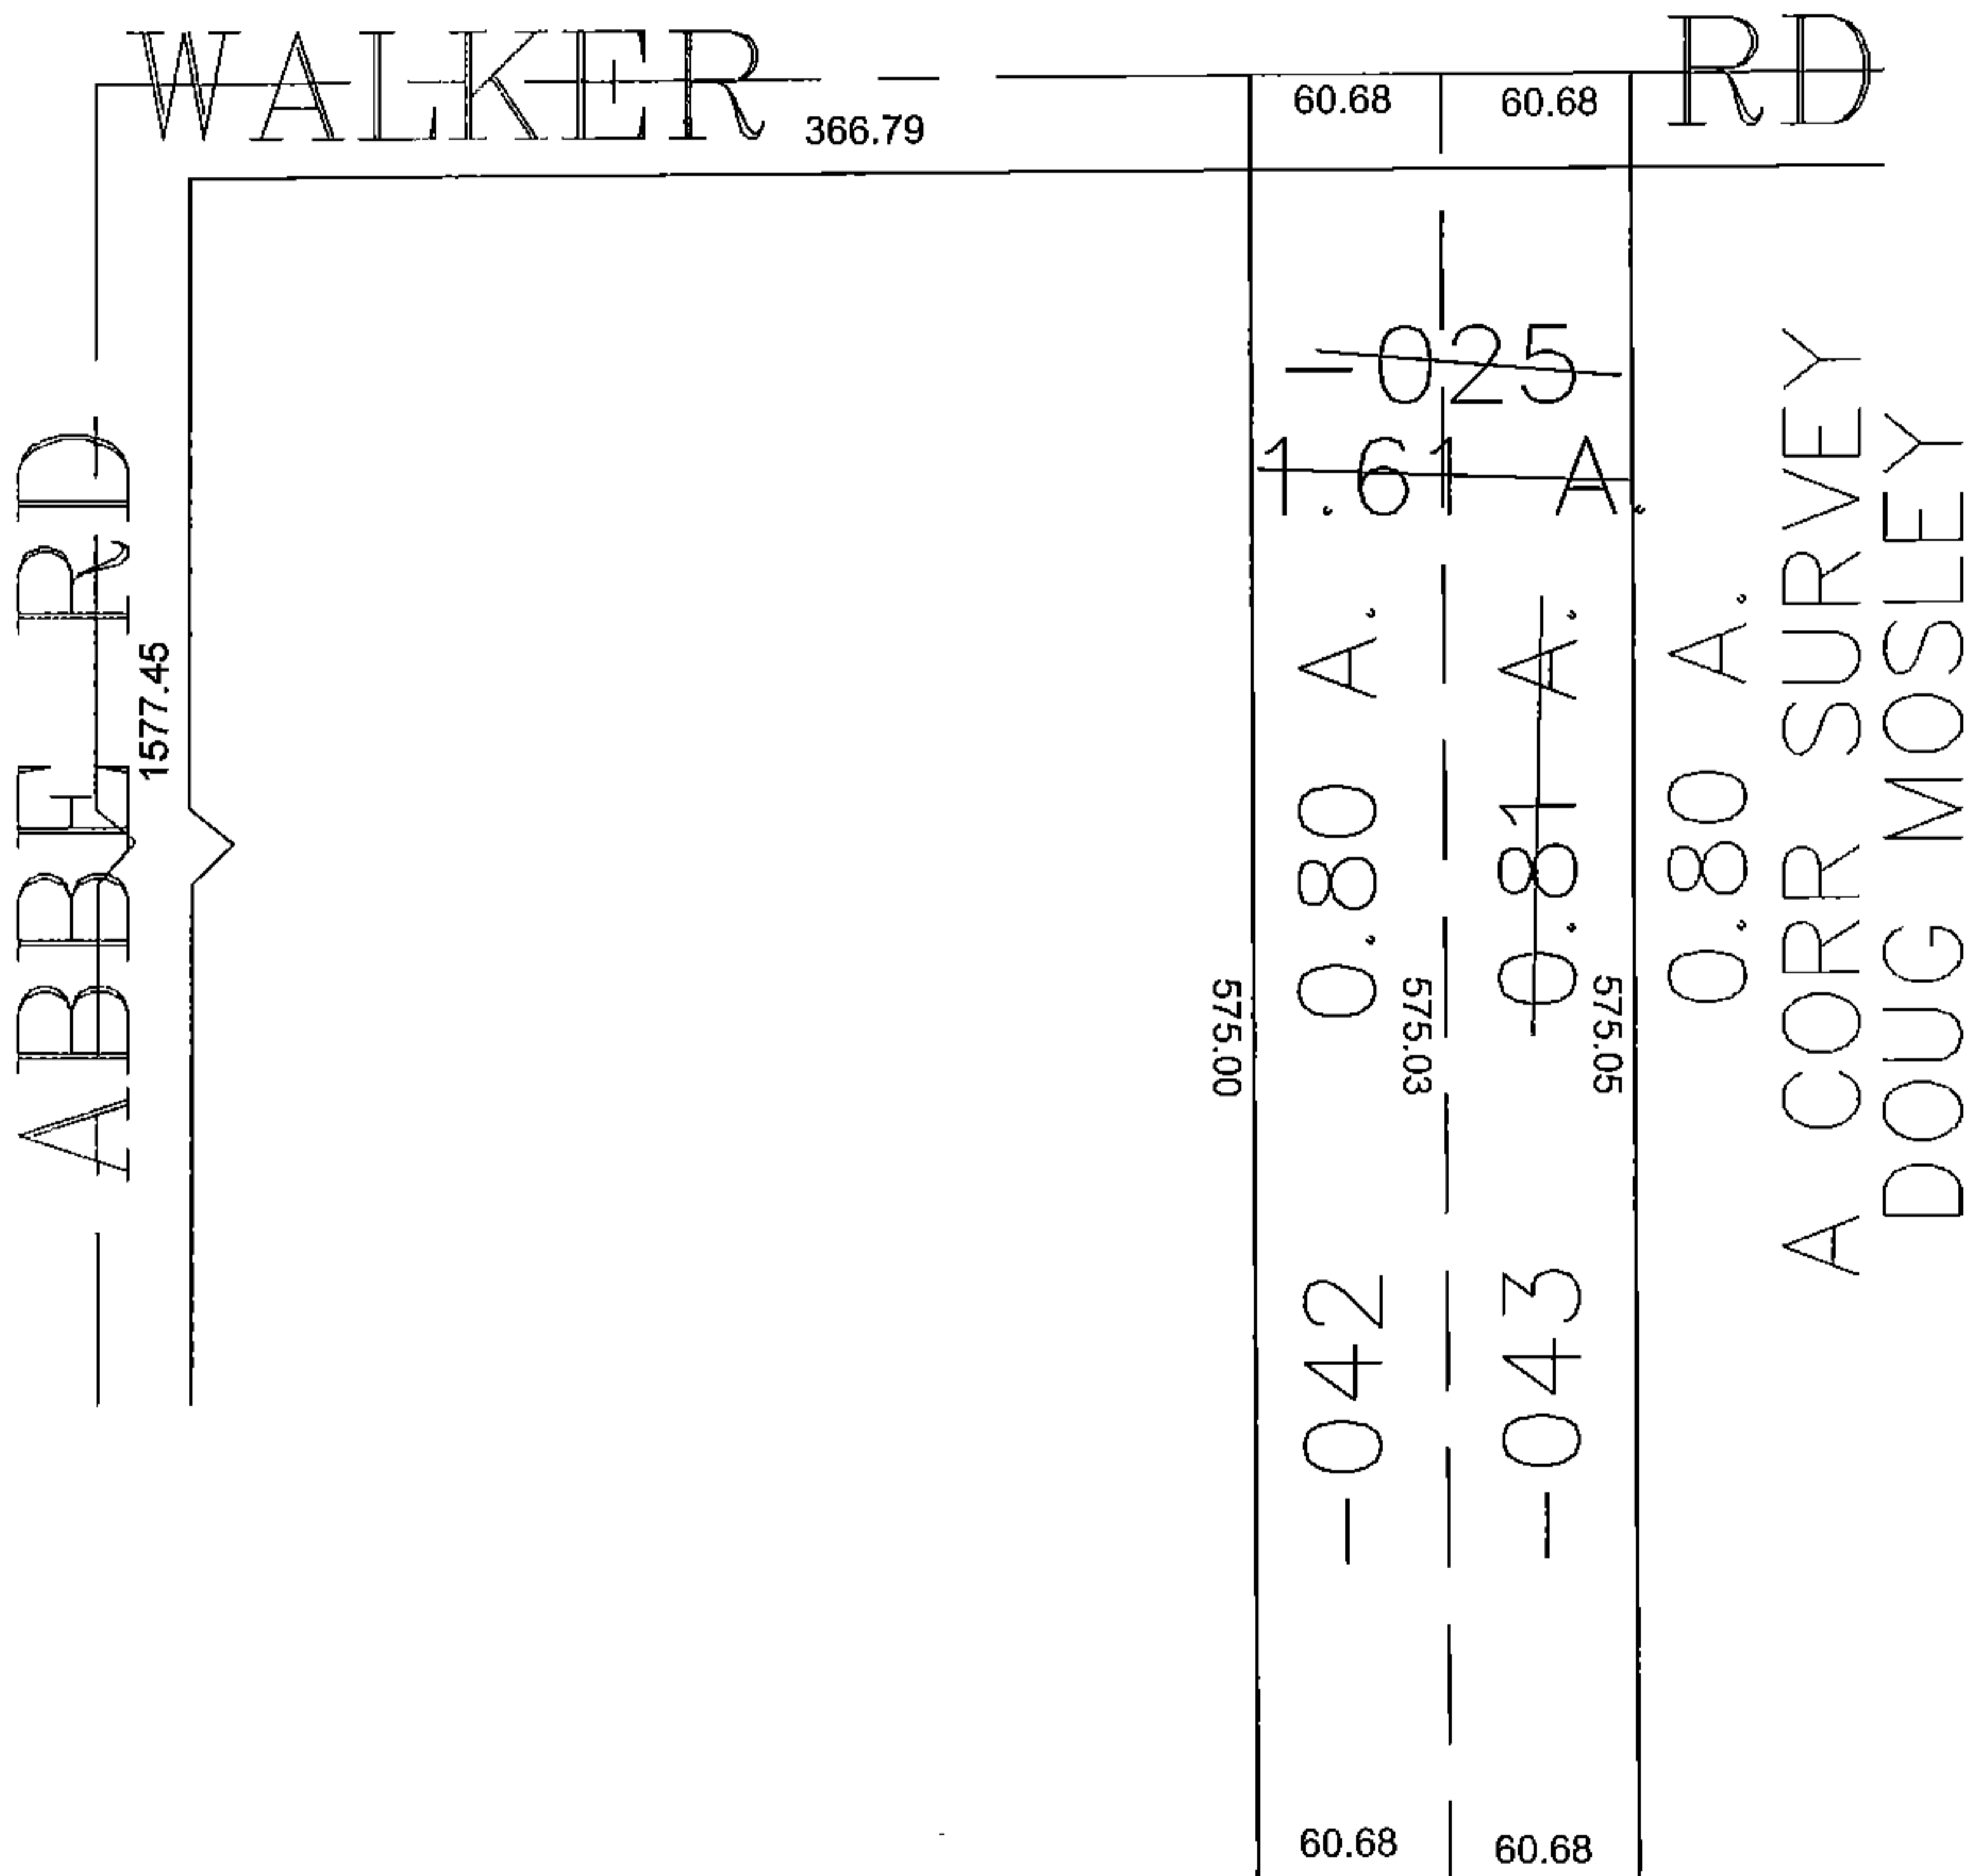


PARENT PARCEL: 03-00-033-115-025

CHILD PARCEL: 03-00-033-115-042, -043

STARTING POINT: CENTERLINE OF ABBE RD & WALKER RD

14-03250

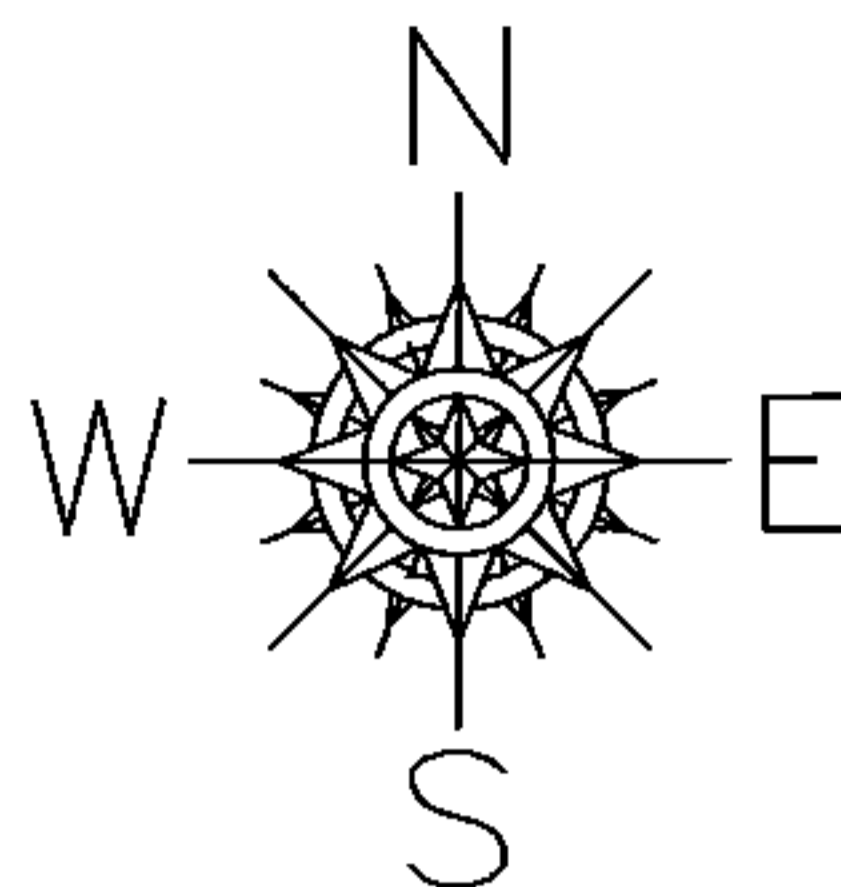

**SPLITS/DEEDS PROCESSED**

LORAIN COUNTY TAX MAP DEPARTMENT  
226 MIDDLE AVE. ELYRIA, OHIO

SURVEYED BY: DOUG MOSELY

CLOSURE: 0.00 : 10.000

MAP PAGE(S): 03-00-033-B

APPROVED BY: JAH DATE: 7-14-2014

SCALE: 1" = 100 PRIOR INSTRUMENT: 19970483801