
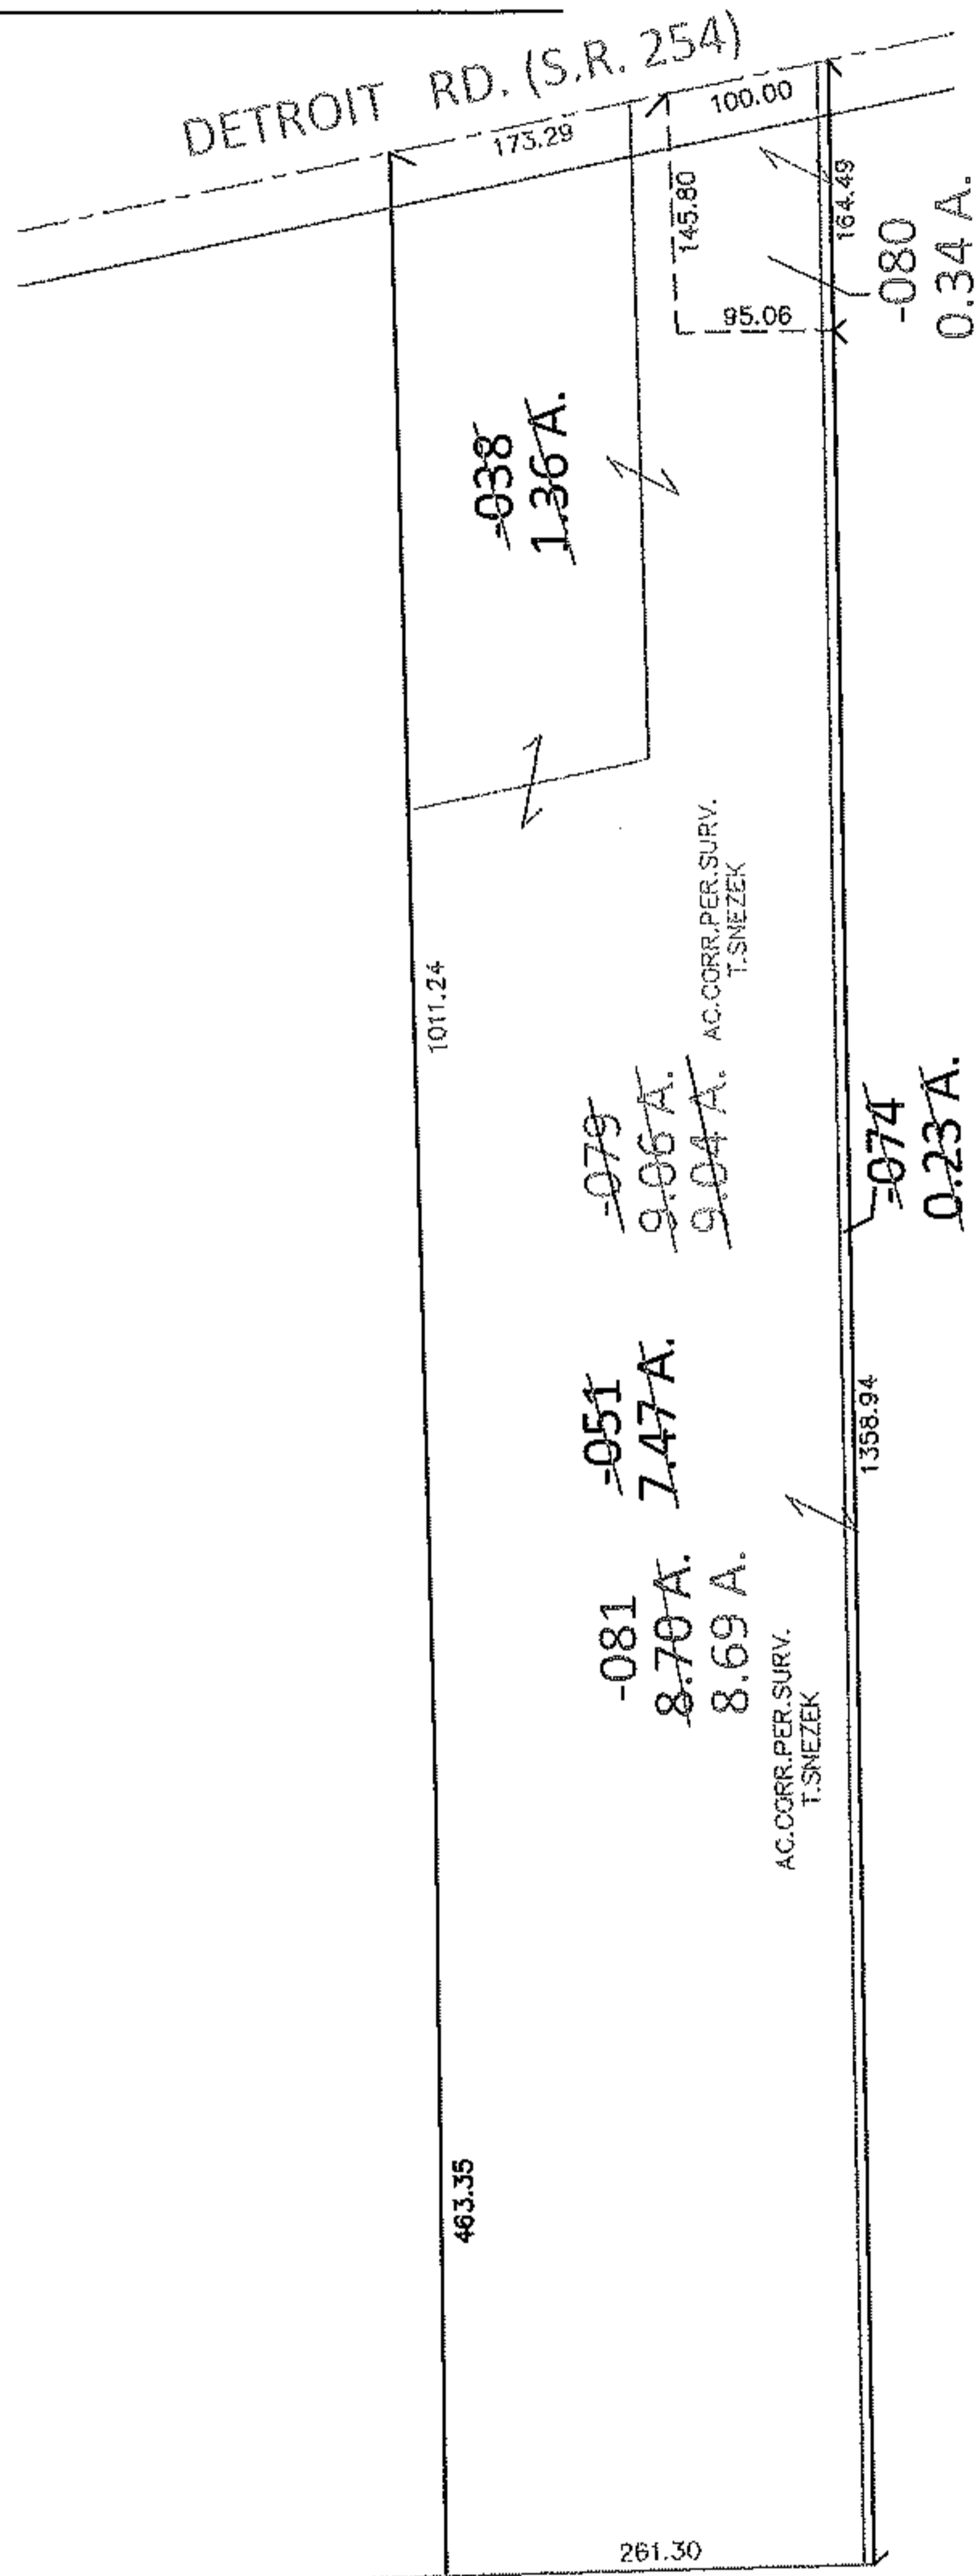


PARENT PARCEL: 04-00-027-102-038, -051, -074

CHILD PARCEL: 04-00-027-102-079 THRU -081

STARTING POINT: SOUTHWEST CORNER OF SEC. 27

14-03251

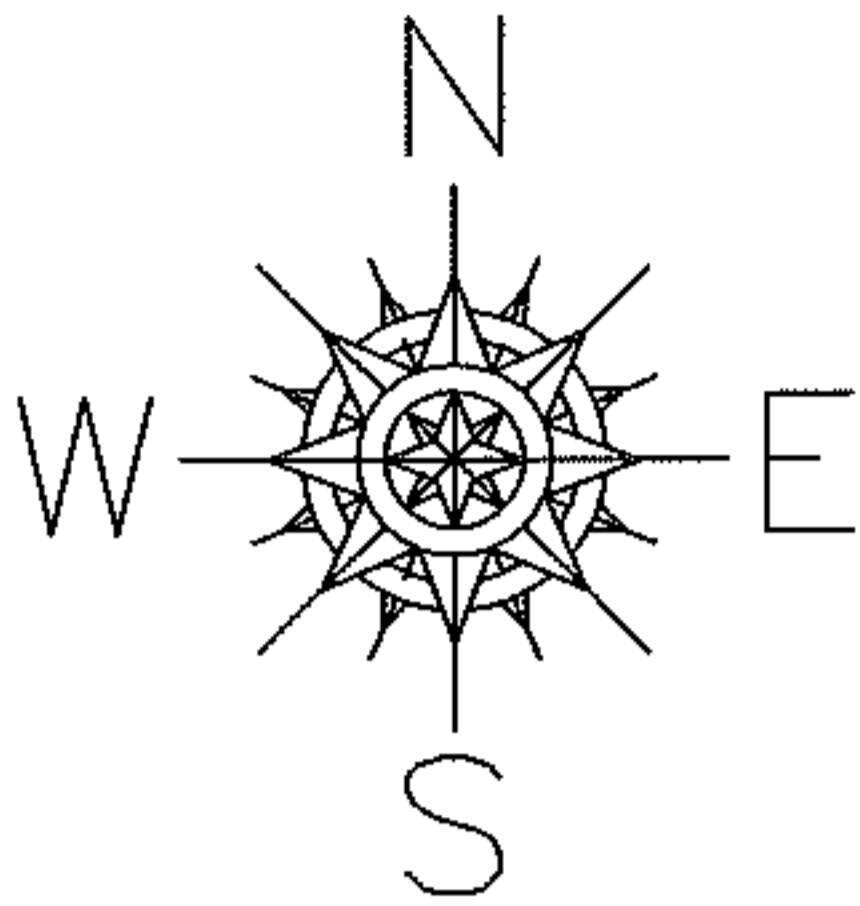

NAGEL RD.

SEC. 27
SEC. 26

918.45

463.35

1011.24

-081
8.70 A.
8.69 A.

-079
9.06 A.
9.04 A.

-038
1.36 A.

-074
0.23 A.

-080
0.34 A.

AC. CORR. PER. SURV.
T. SNEZEK

AC. CORR. PER. SURV.
T. SNEZEK

8.70 A.
8.69 A.

9.06 A.
9.04 A.

173.29

100.00


145.80

95.06

1358.94

164.49

261.30

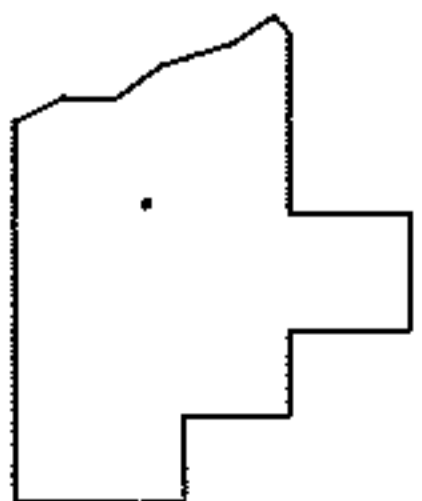

SPLITS/DEEDS PROCESSED

LORAIN COUNTY TAX MAP DEPARTMENT
226 MIDDLE AVE. ELYRIA, OHIO

SURVEYED BY: THOMAS M. SNEZEK

CLOSURE: 01:10,000

MAP PAGE(S): 4-00-027-E

APPROVED BY: RRM DATE: 5-5-14

SCALE: 1"= 200 PRIOR INST.: DV 1406/31