
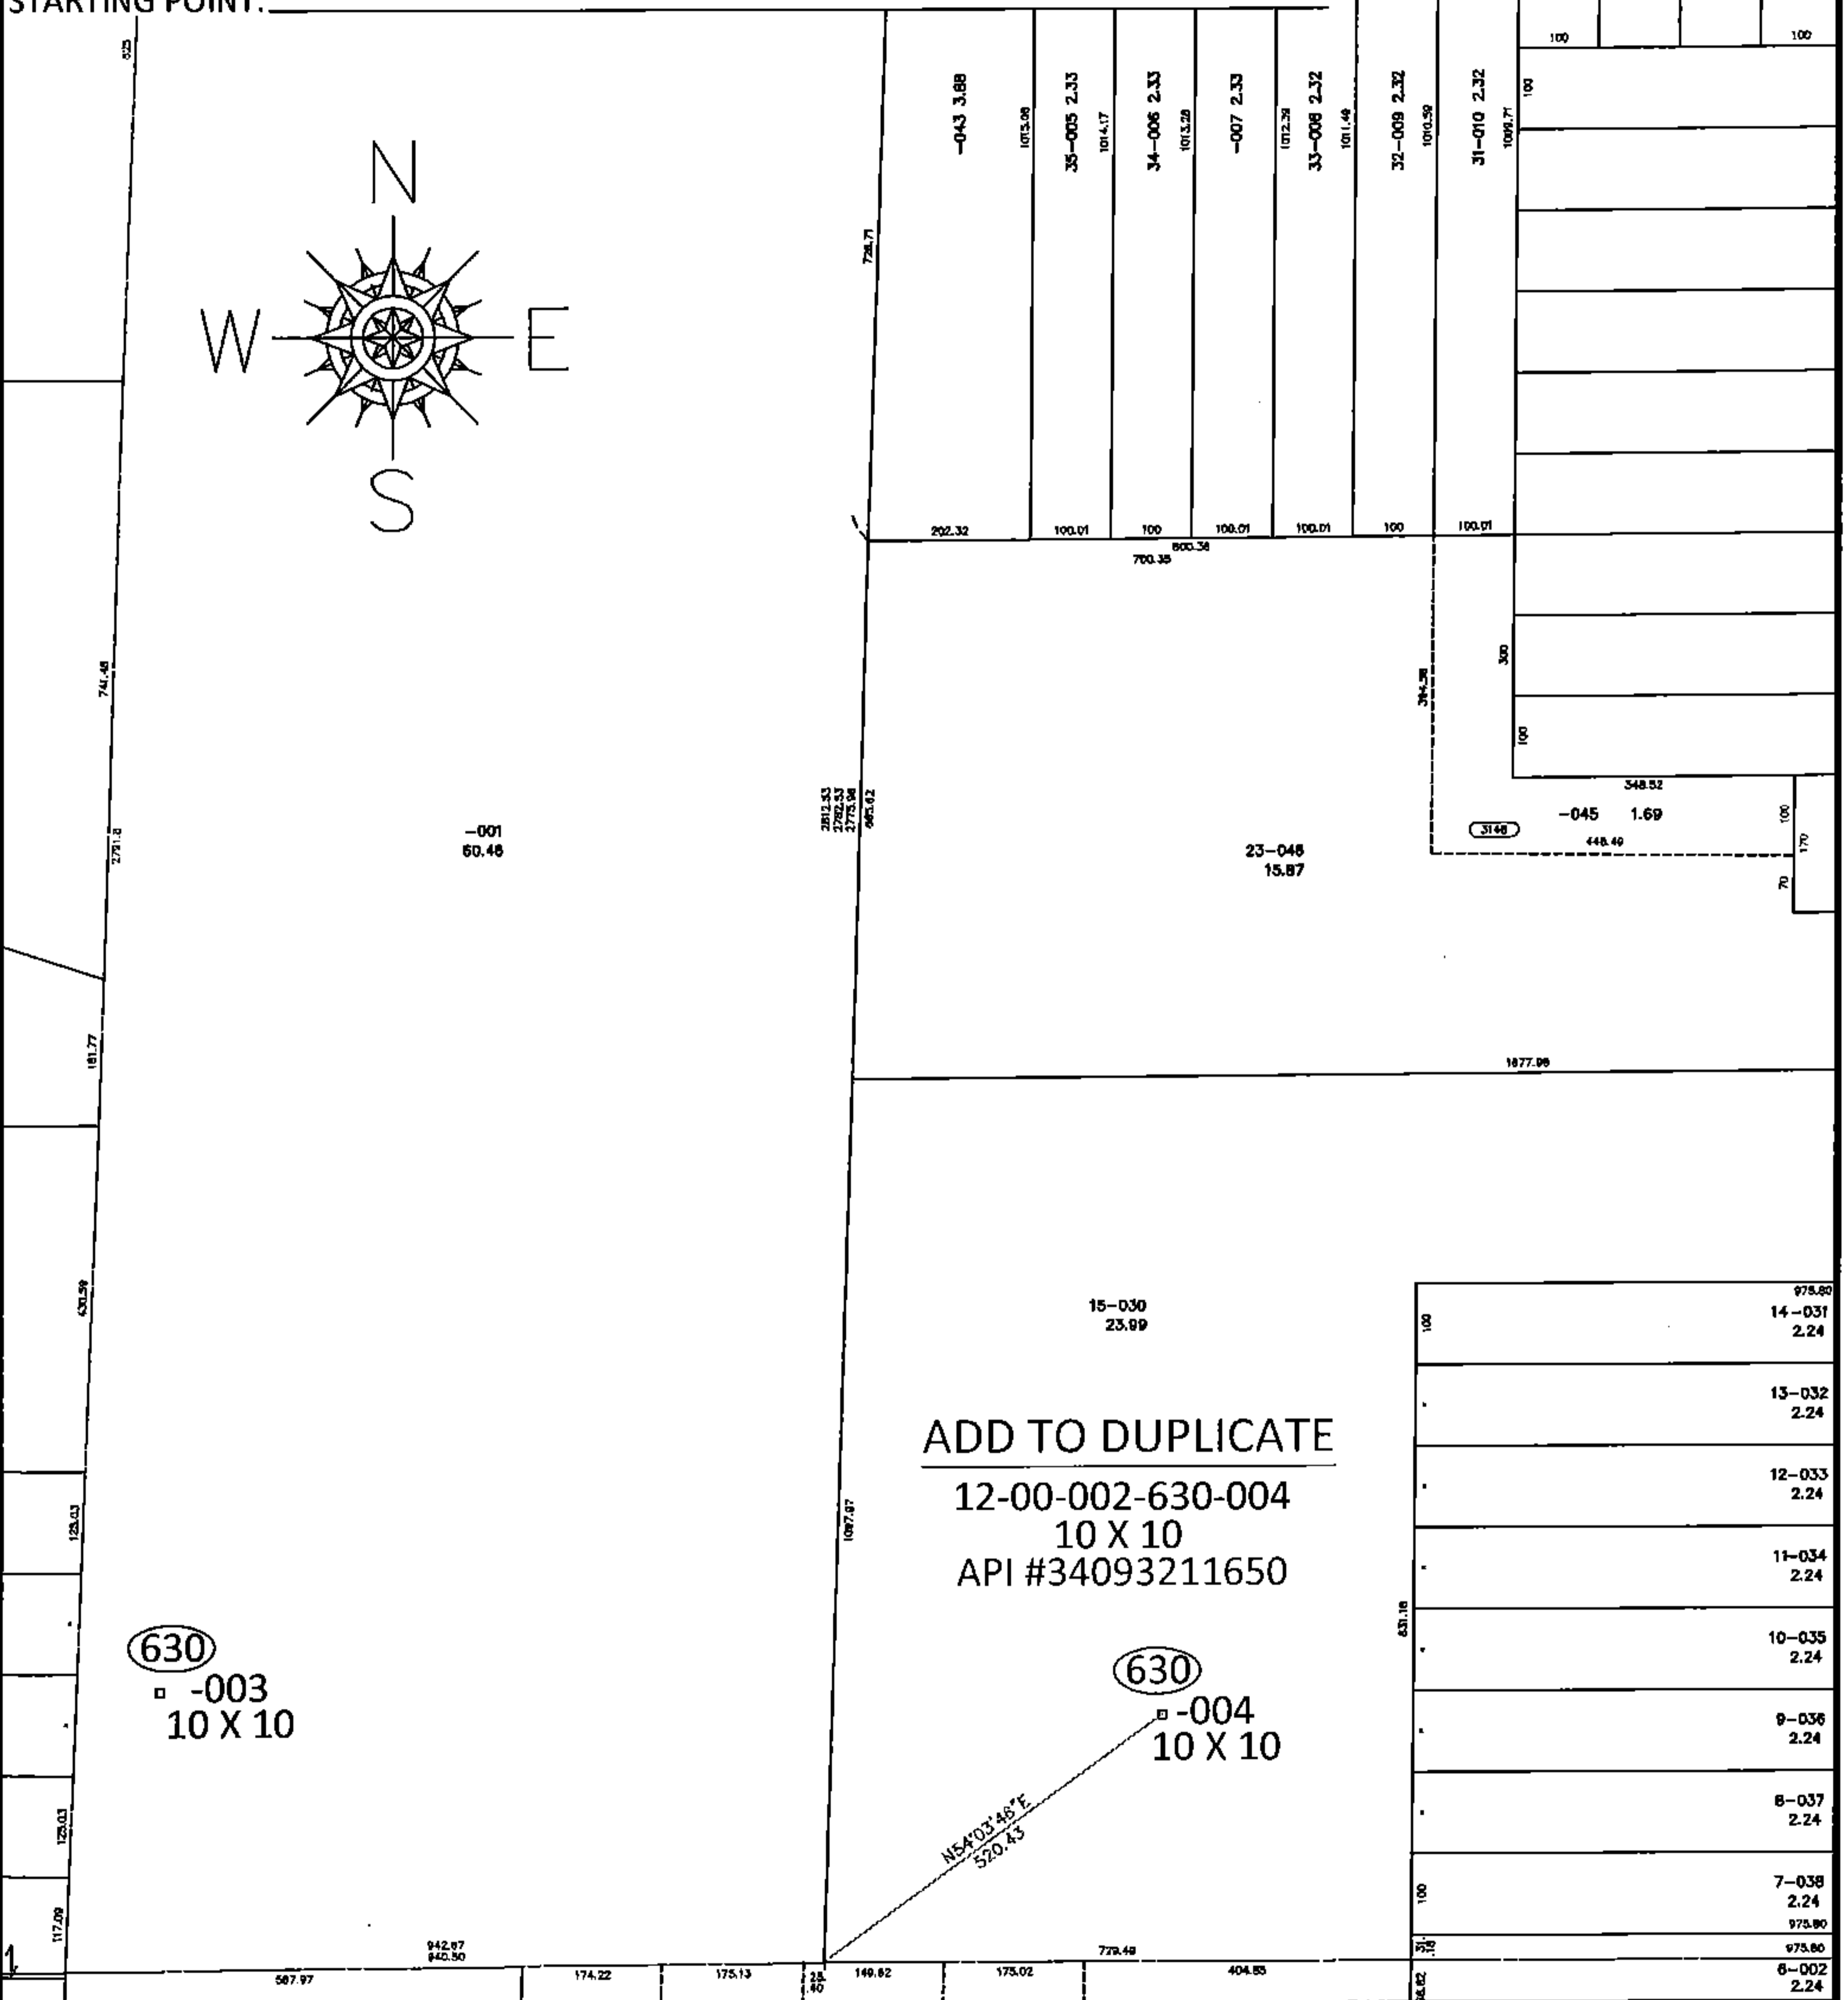


PARENT PARCEL: 12-00-002-000-030

CHILD PARCEL: 12-00-002-630-004

15-03252-A

STARTING POINT: \_\_\_\_\_

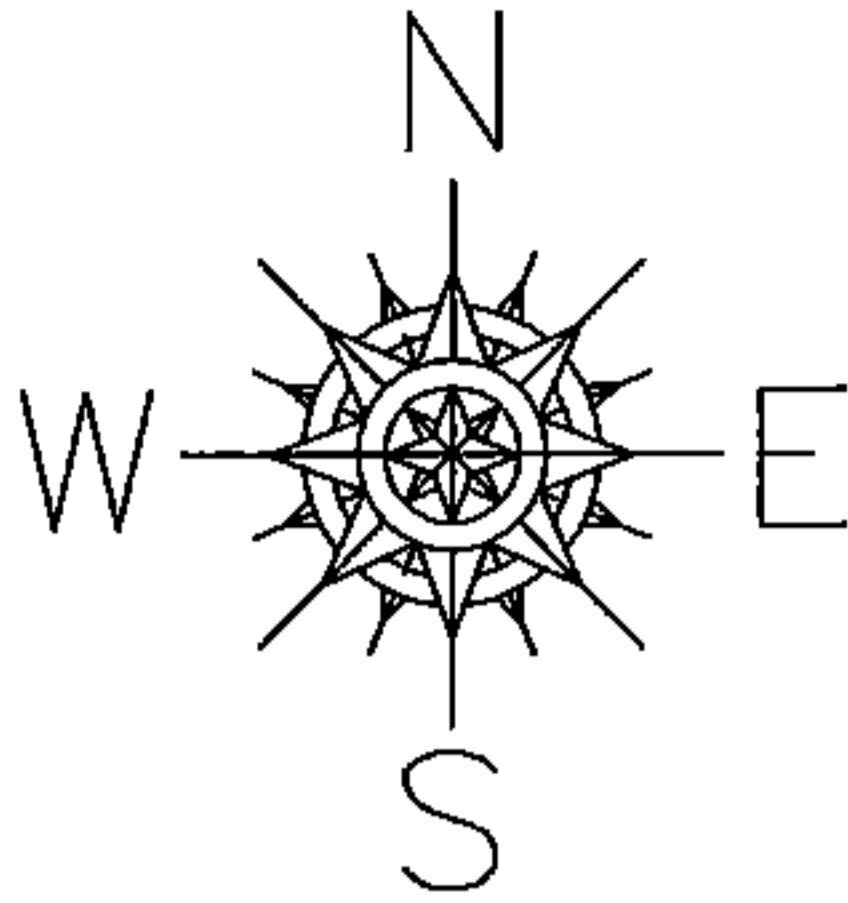


ADD TO DUPLICATE

12-00-002-630-004  
10 X 10  
API #34093211650

630  
-003  
10 X 10

630  
-004  
10 X 10

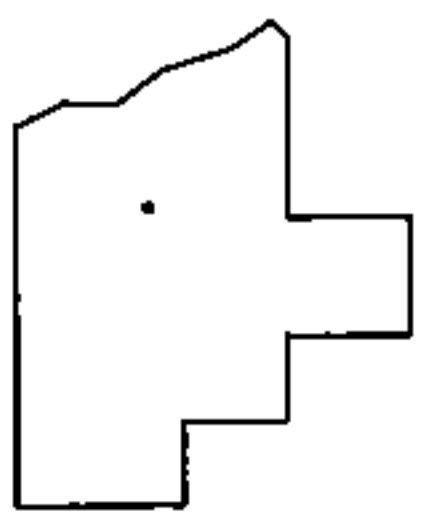

SPLITS/DEEDS PROCESSED

LORAIN COUNTY TAX MAP DEPARTMENT  
226 MIDDLE AVE. ELYRIA, OHIO

SURVEYED BY: N/A  
CLOSURE: N/A  
MAP PAGE(S): 12-00-002-B  
APPROVED BY: RRM DATE: 7-20-15  
SCALE: 1" = 300 PRIOR INST.: \_\_\_\_\_