
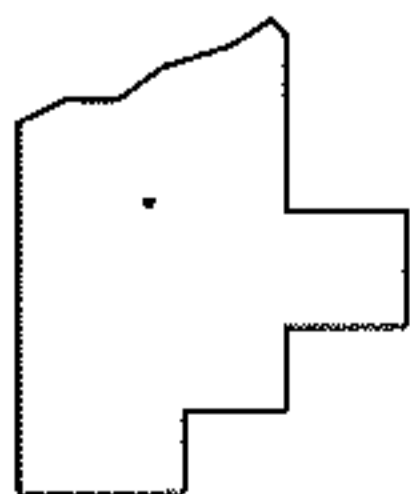
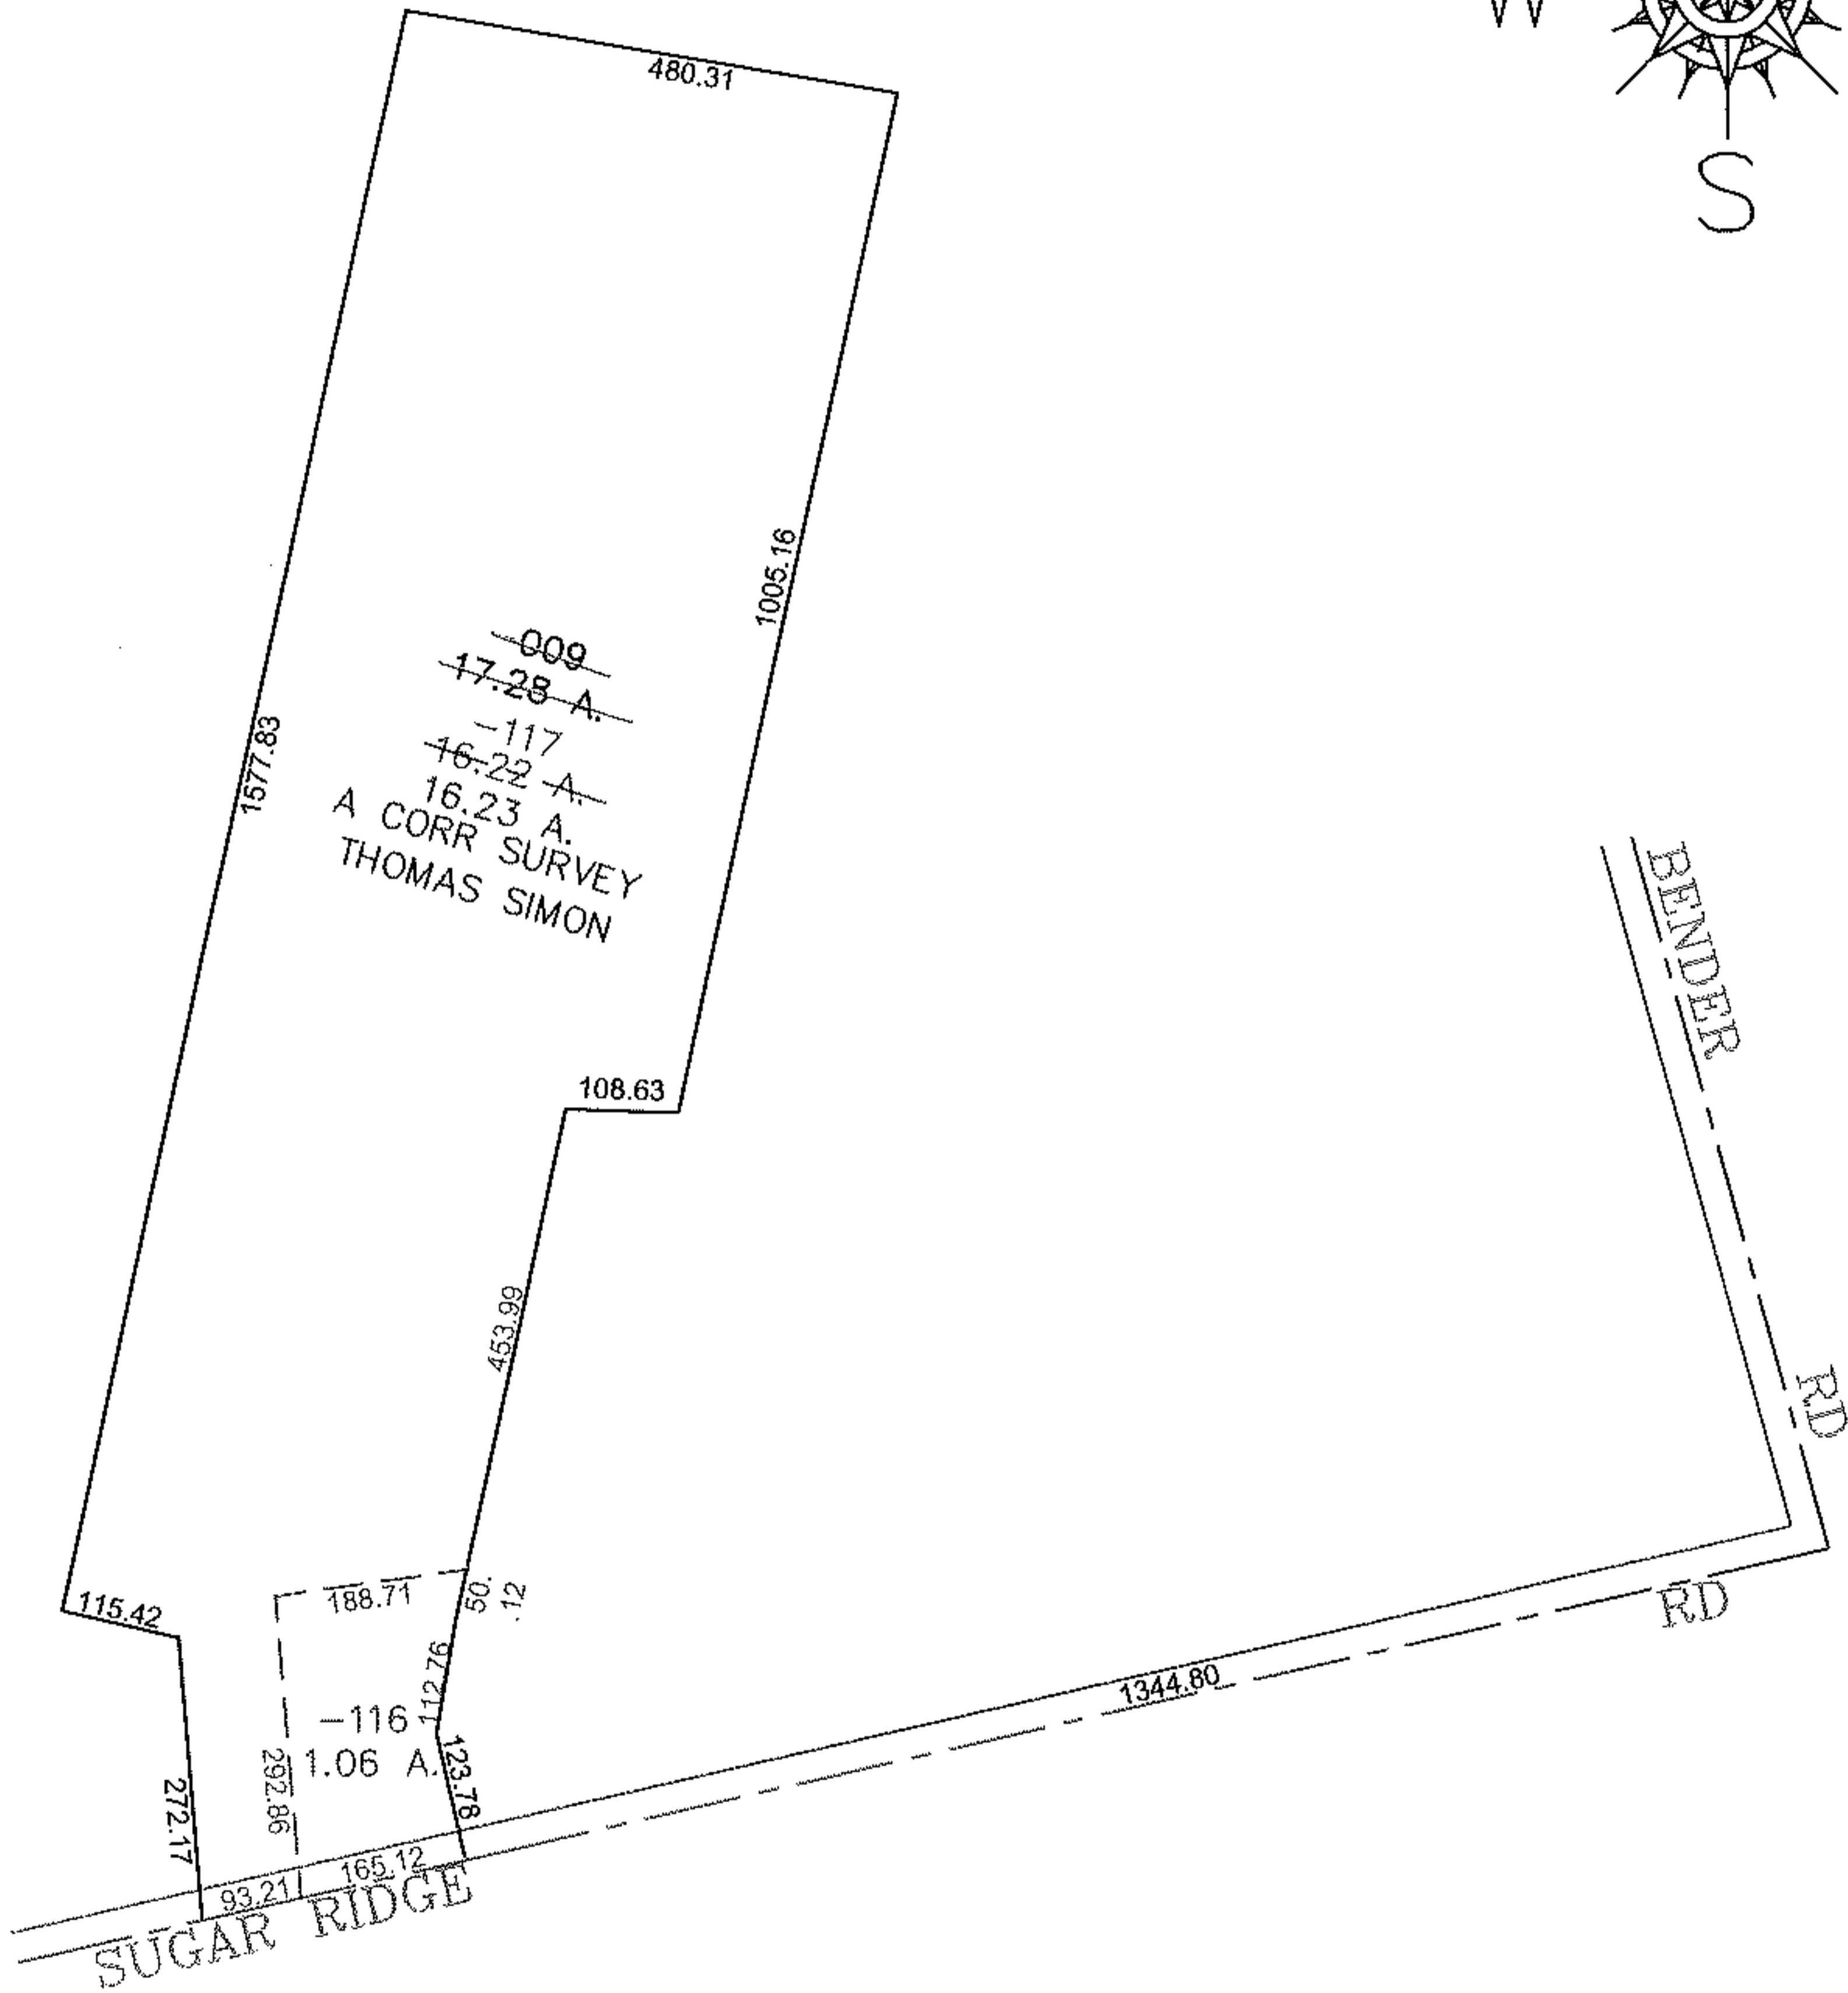


PARENT PARCEL: 07-00-047-000-009

CHILD PARCEL: 07-00-047-000-116, -117

STARTING POINT: CENTERLINE OF SUGAR RIDGE RD & BENDER RD

14-03252

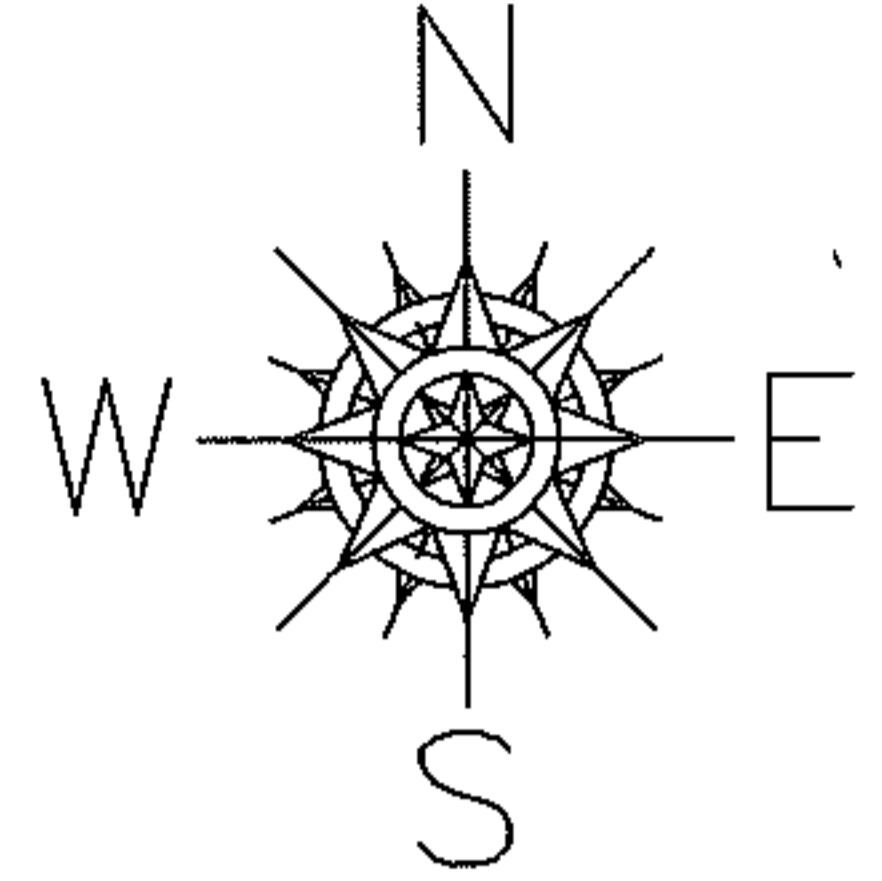

SPLITS/DEEDS PROCESSED

LORAIN COUNTY TAX MAP DEPARTMENT
226 MIDDLE AVE. ELYRIA, OHIO

SURVEYED BY: THOMAS SIMON
 CLOSURE: 0.00 : 10,000
 MAP PAGE(S): 07-00-047-D
 APPROVED BY: JAH DATE: 5/8/2014
 SCALE: 1" = 300 PRIOR INSTRUMENT: 20130454676