
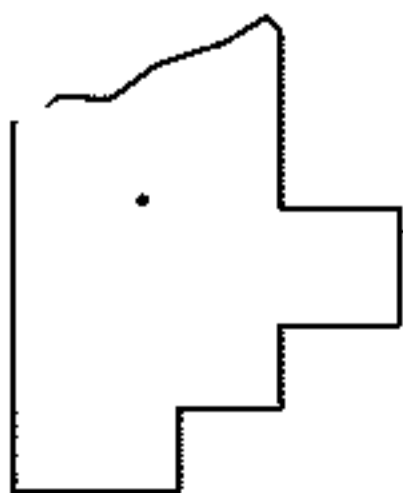


PARENT PARCEL: 19-06-042-000-012

CHILD PARCEL: 19-06-042-000-015, -016

STARTING POINT: CENTERLINE OF SHORT RD & VERMONT ST

14-03253

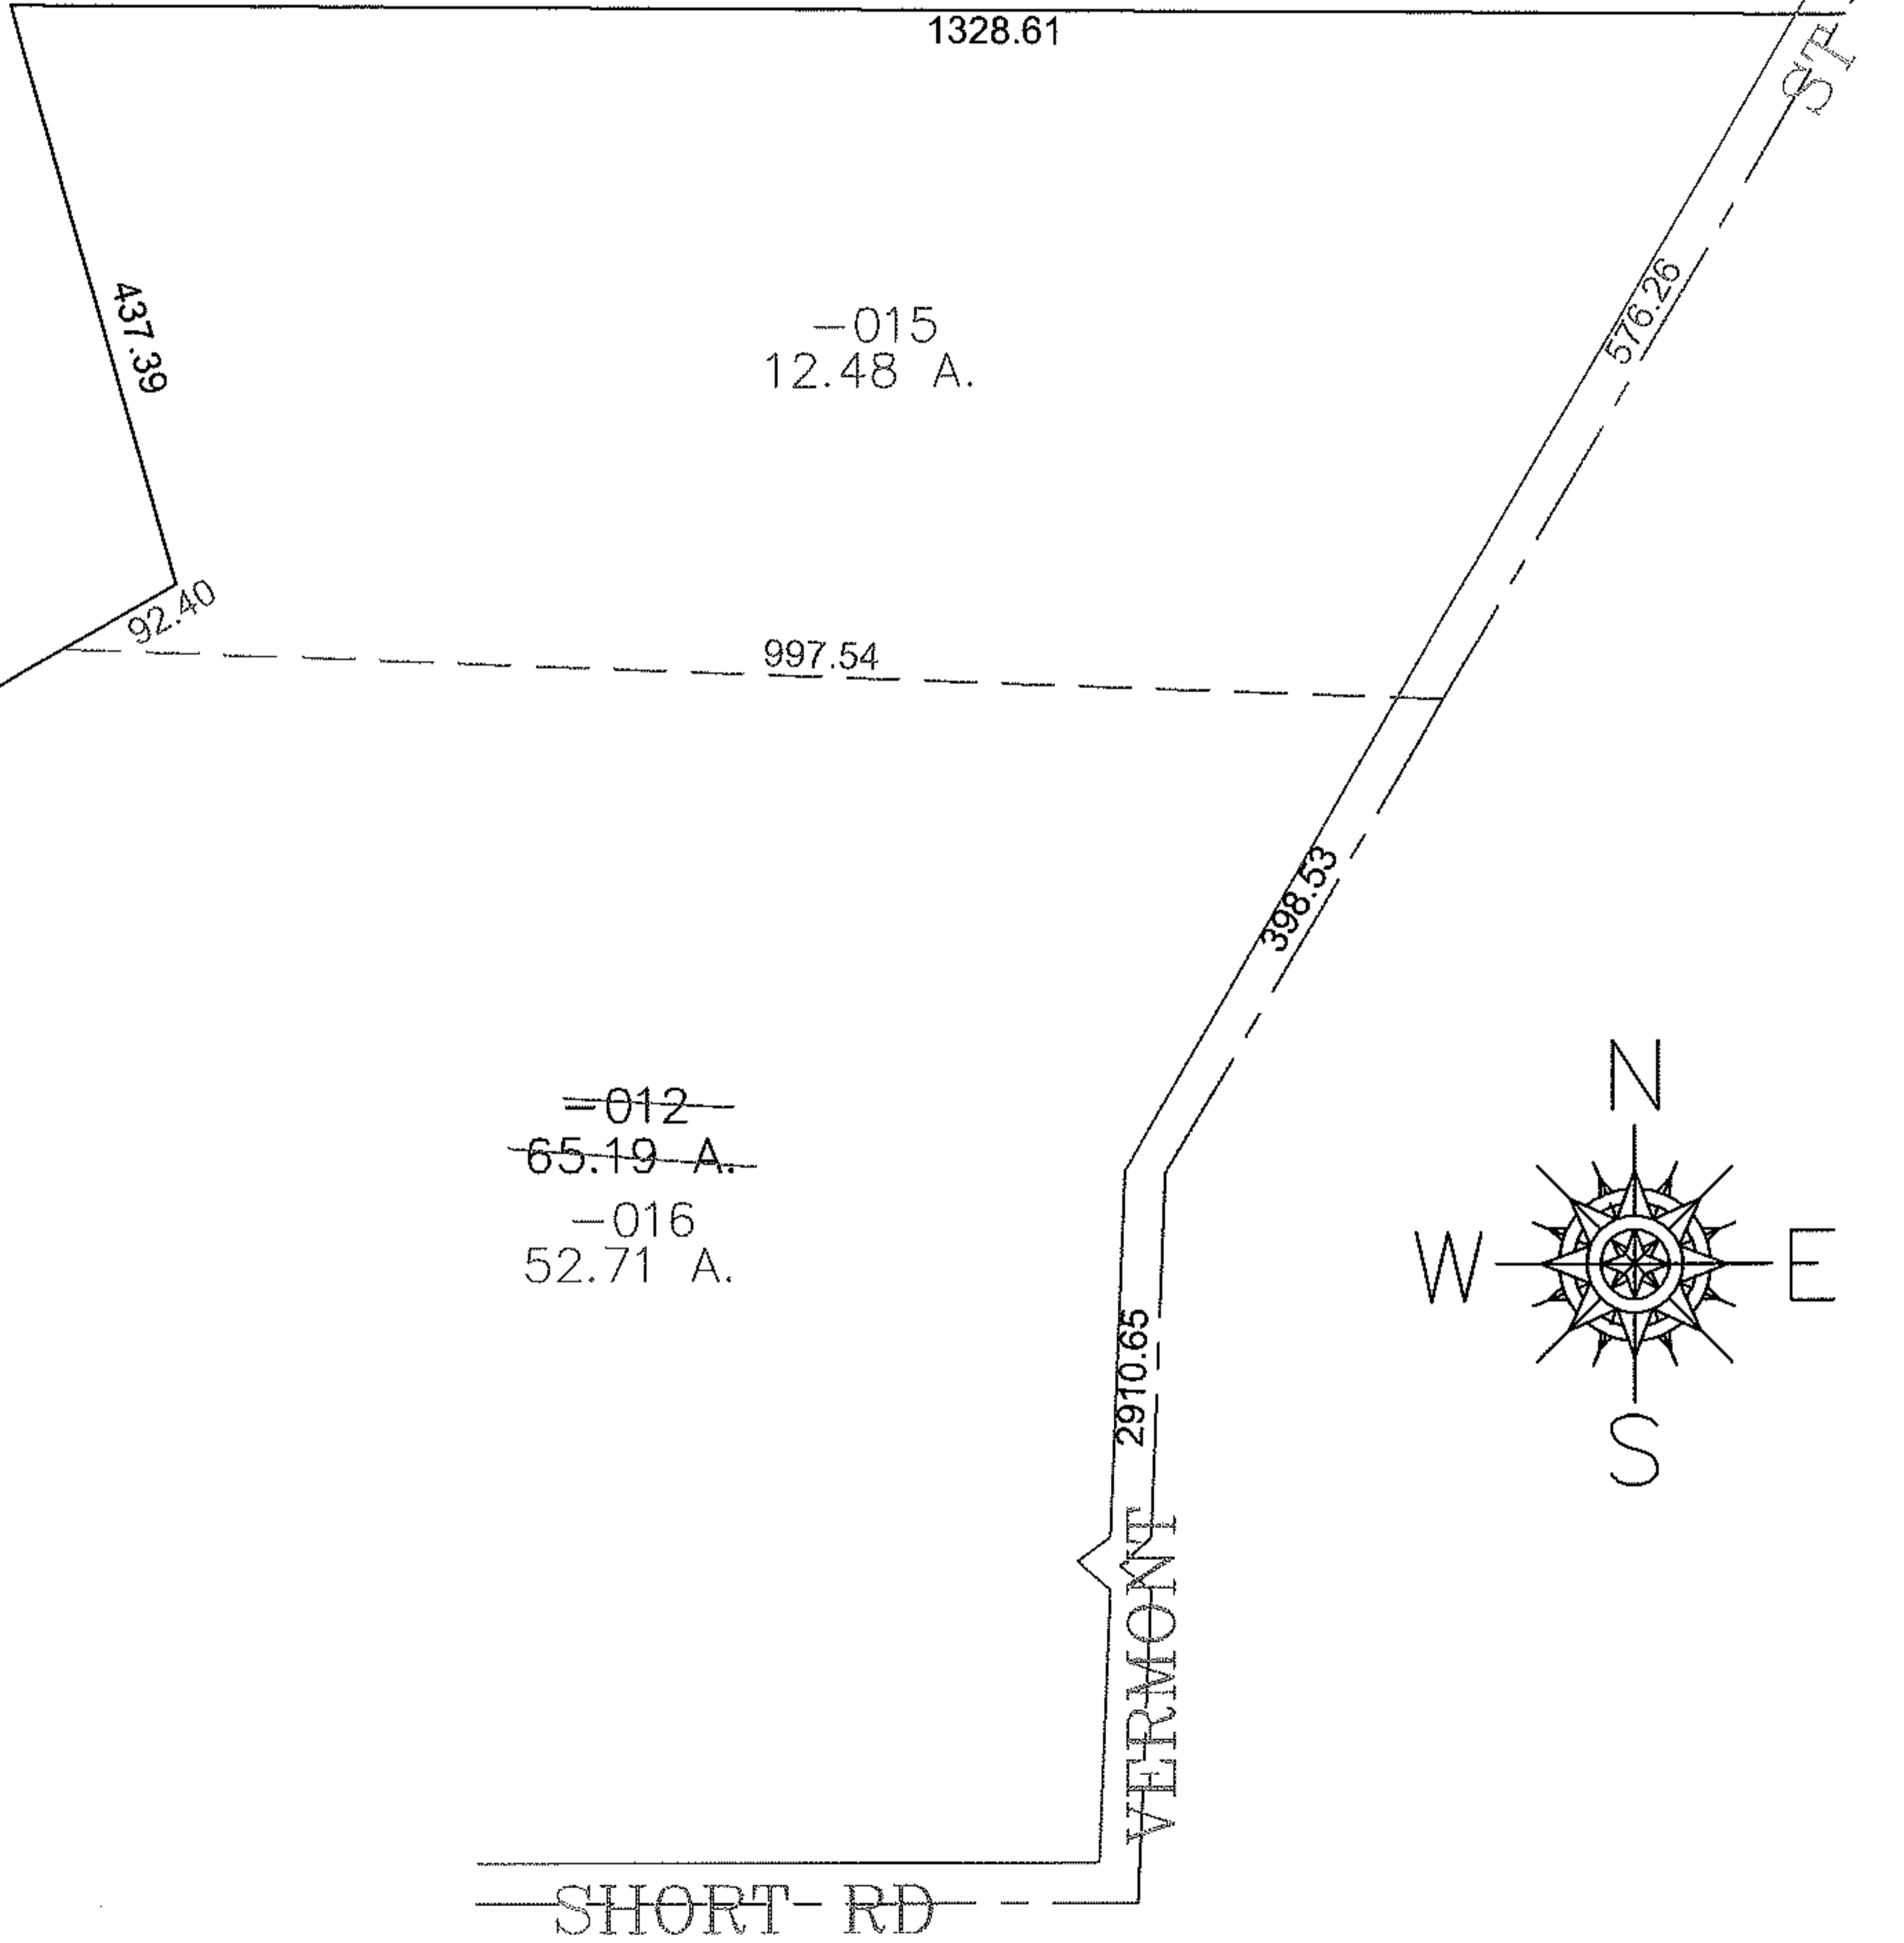

SPLITS/DEEDS PROCESSED
 LORAIN COUNTY TAX MAP DEPARTMENT
 226 MIDDLE AVE. ELYRIA, OHIO

SURVEYED BY: THOMAS SIMON
 CLOSURE: 0.00 : 10.000
 MAP PAGE(S): 19-D
 APPROVED BY: JAH DATE: 5/8/2014
 SCALE: 1" = 200 PRIOR INSTRUMENT: 20040032583