
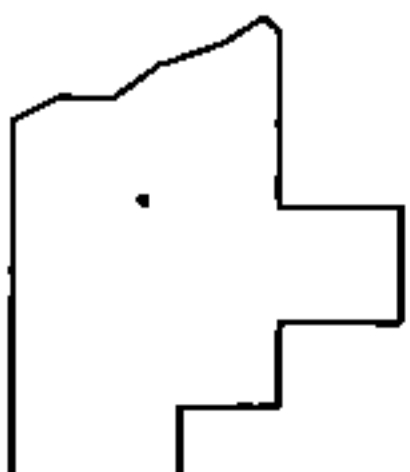
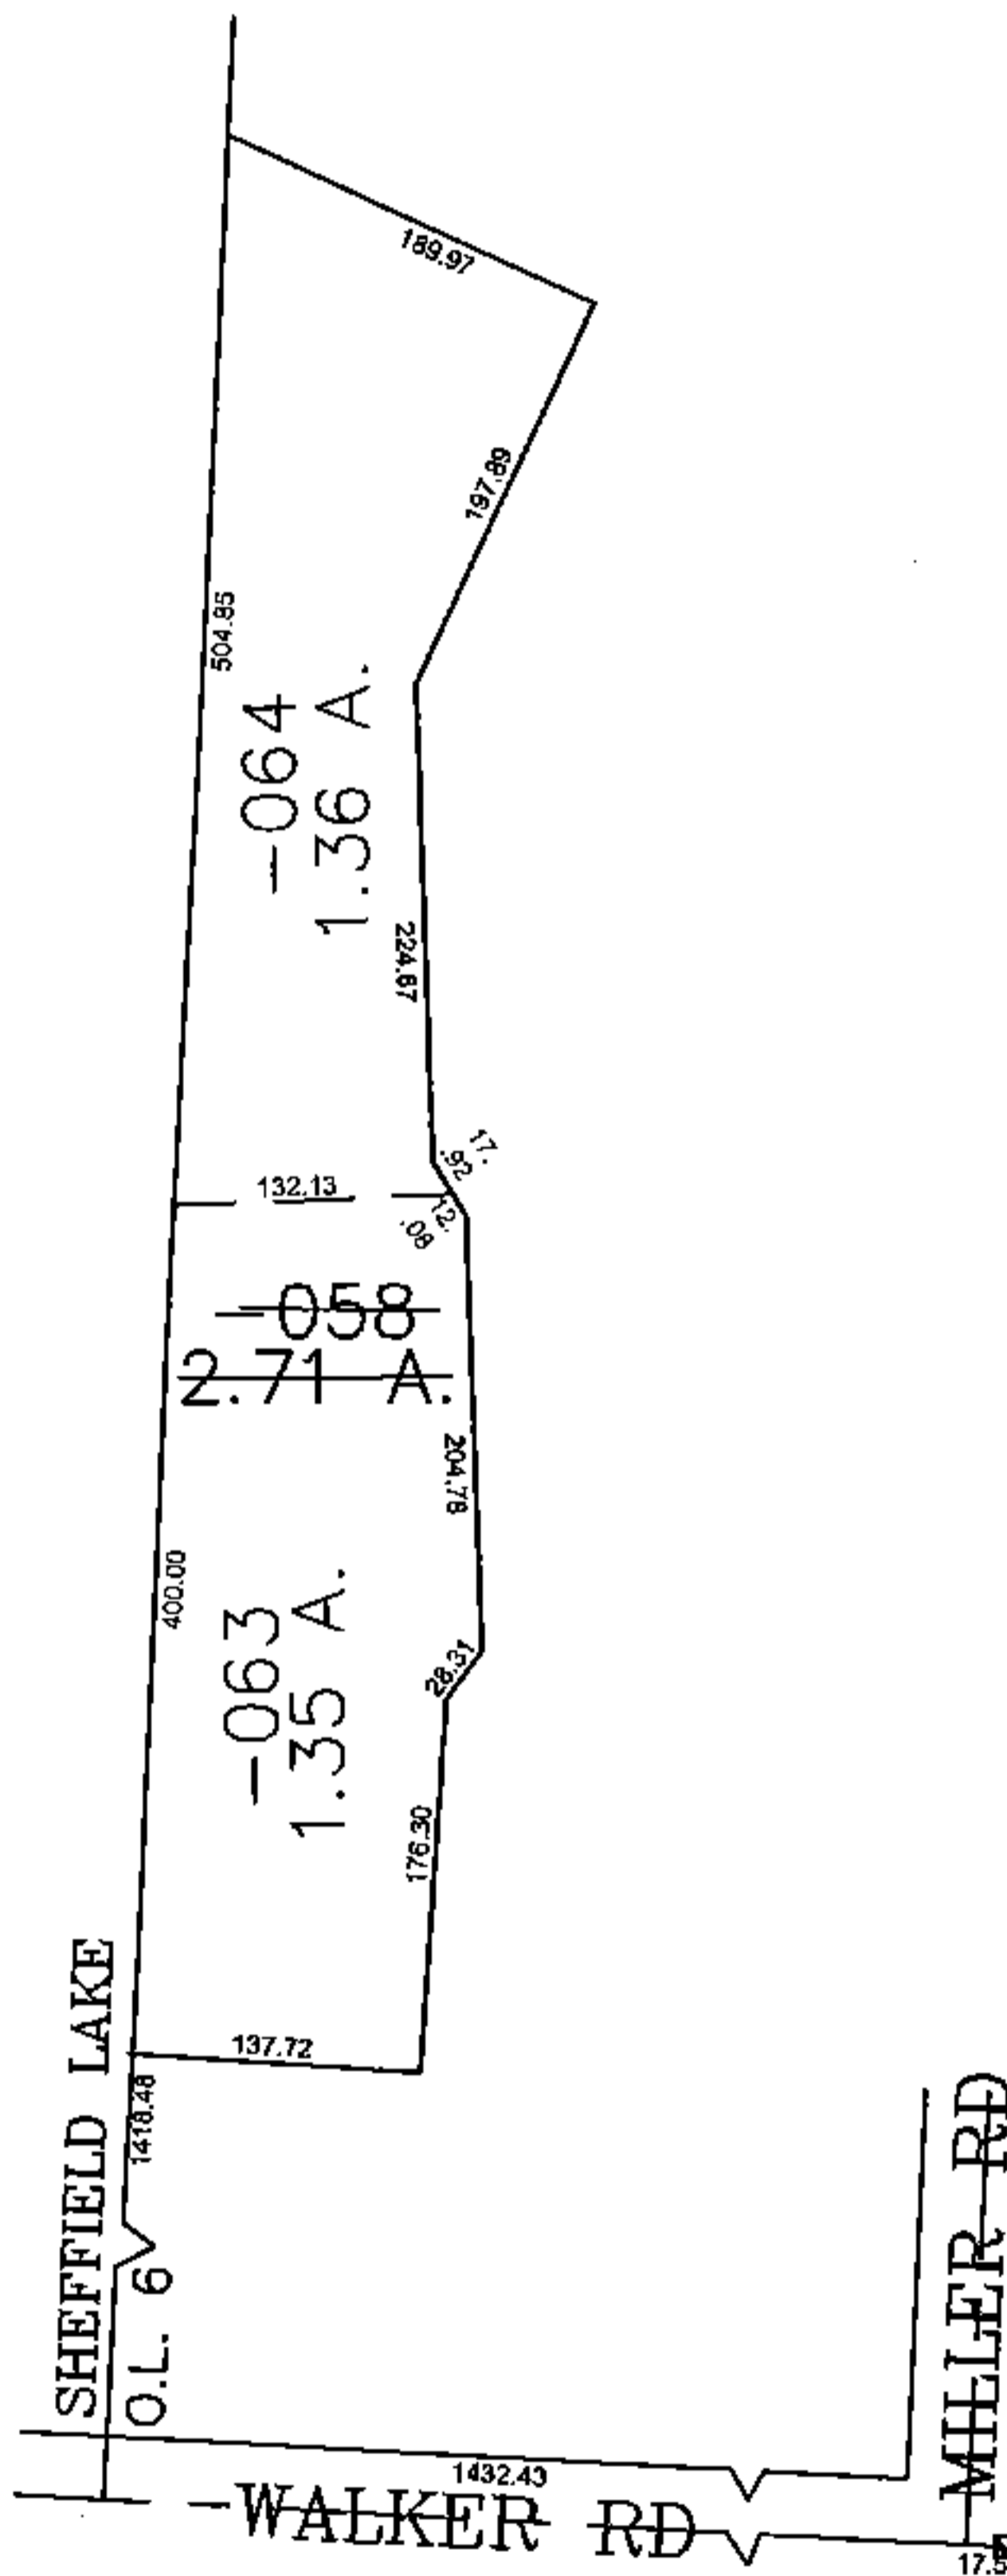


PARENT PARCEL: 04-00-006-105-058

CHILD PARCEL: 04-00-006-105-063, -064

STARTING POINT: CENTERLINE OF WALKER RD & MILLER RD

14-03258

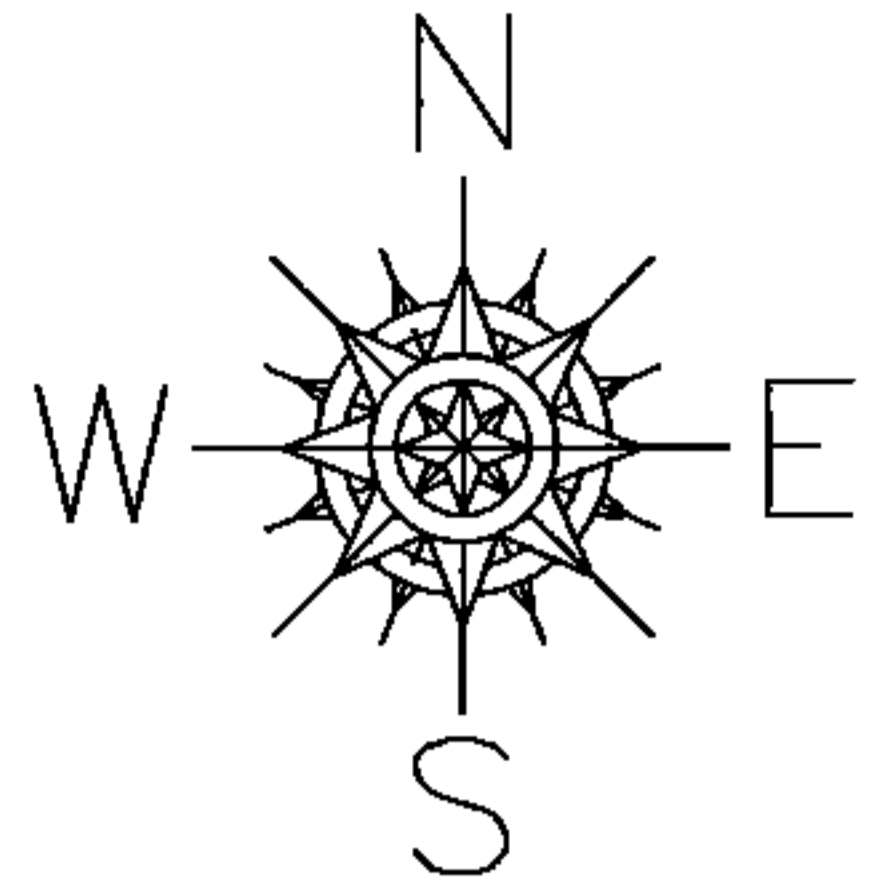

SPLITS/DEEDS PROCESSED
 LORAIN COUNTY TAX MAP DEPARTMENT
 226 MIDDLE AVE. ELYRIA, OHIO

SURVEYED BY: JAMES T SAYLER
 CLOSURE: 0.00 : 10.000
 MAP PAGE(S): 04-00-006-E
 APPROVED BY: JAH DATE: 6-2-2014
 SCALE: 1" = 200 PRIOR INSTRUMENT: 20120408946