
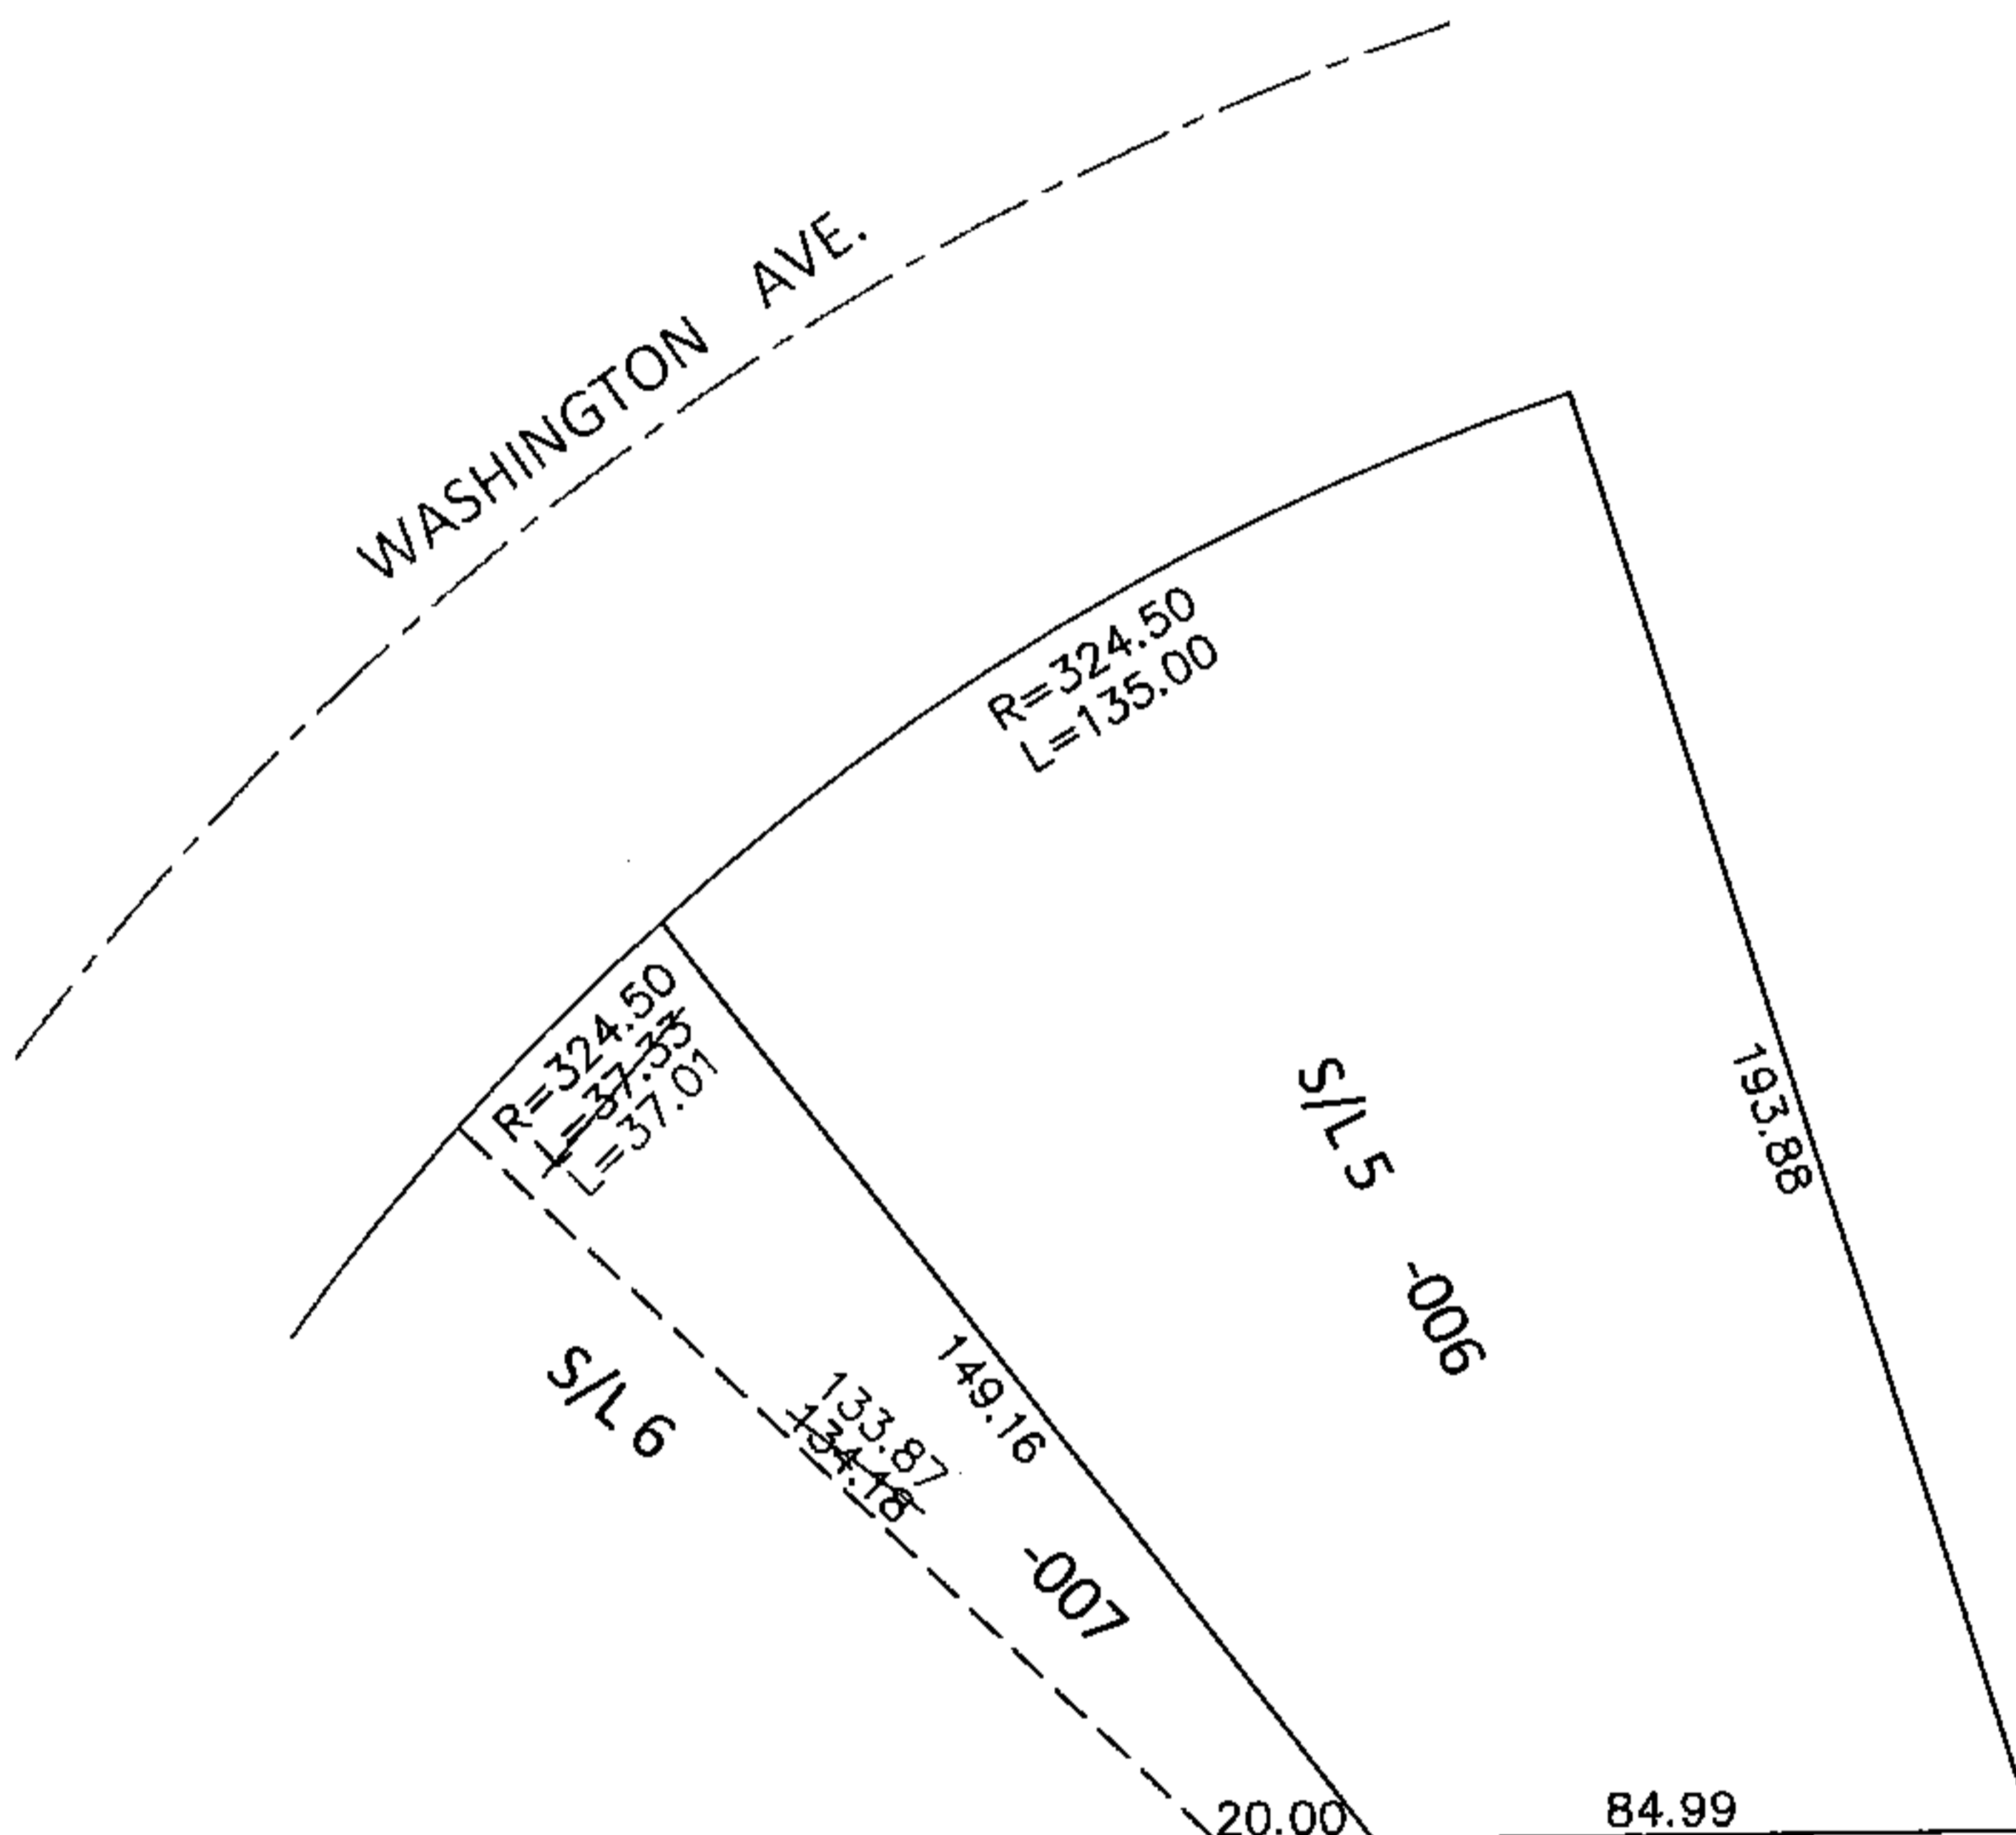


PARENT PARCEL: 06-25-134-000-006, -007

CHILD PARCEL: _____

STARTING POINT: NORTHWEST CORNER OF SUBLOT 6 IN ELYWOOD SUB. (VOL.12 PG.31)

15-03259-D

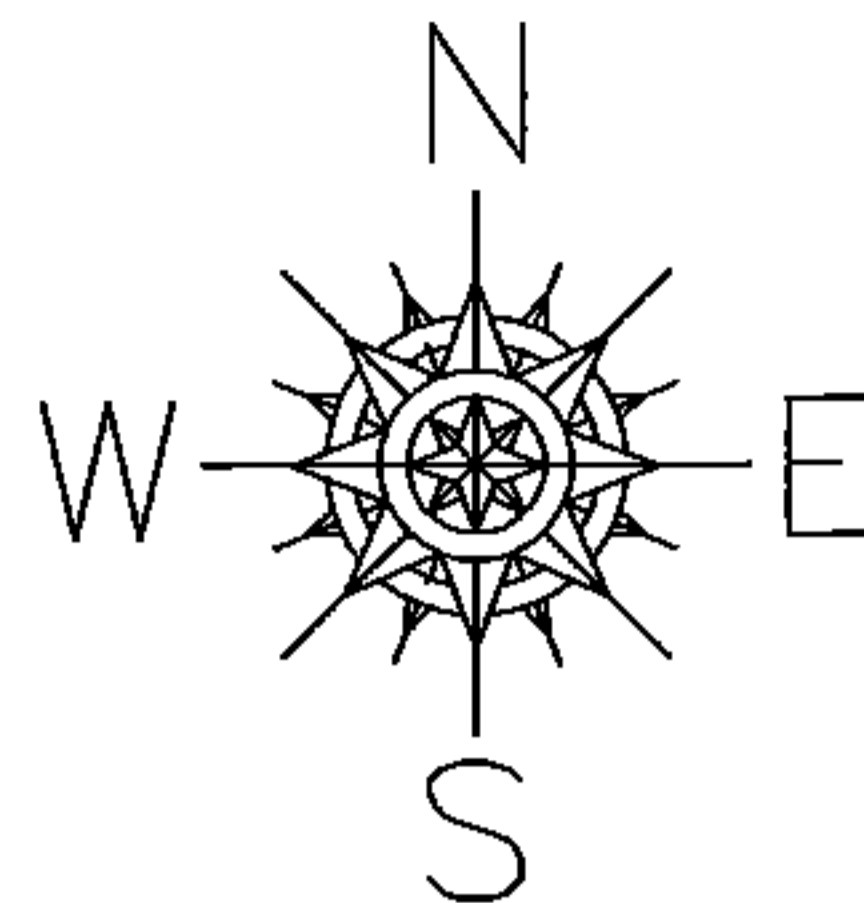


FRONTAGE & DEPTH CORRECTION

06-25-134-000-007

37.01 X 149.16

~~37.33 X 149.00~~

PER SURVEY BY D. HAYWOOD

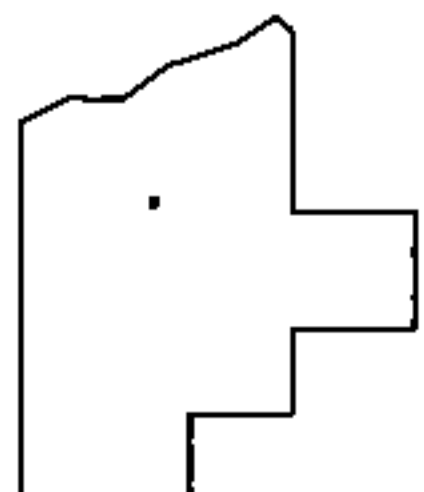

SPLITS/DEEDS PROCESSED

LORAIN COUNTY TAX MAP DEPARTMENT
226 MIDDLE AVE. ELYRIA, OHIO

SURVEYED BY: DALE R. HAYWOOD

CLOSURE: .01:10,000

MAP PAGE(S): 6-102

APPROVED BY: RRM DATE: 7-23-15

SCALE: 1"= 50' PRIOR INST.: 20120420506