
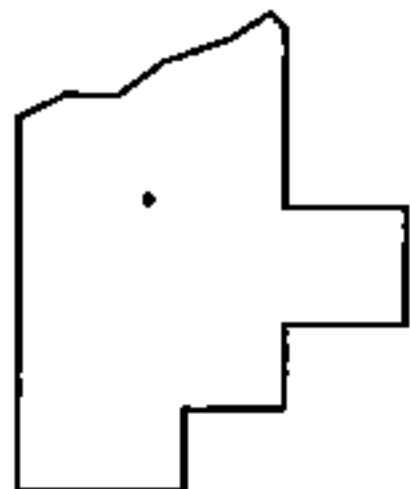
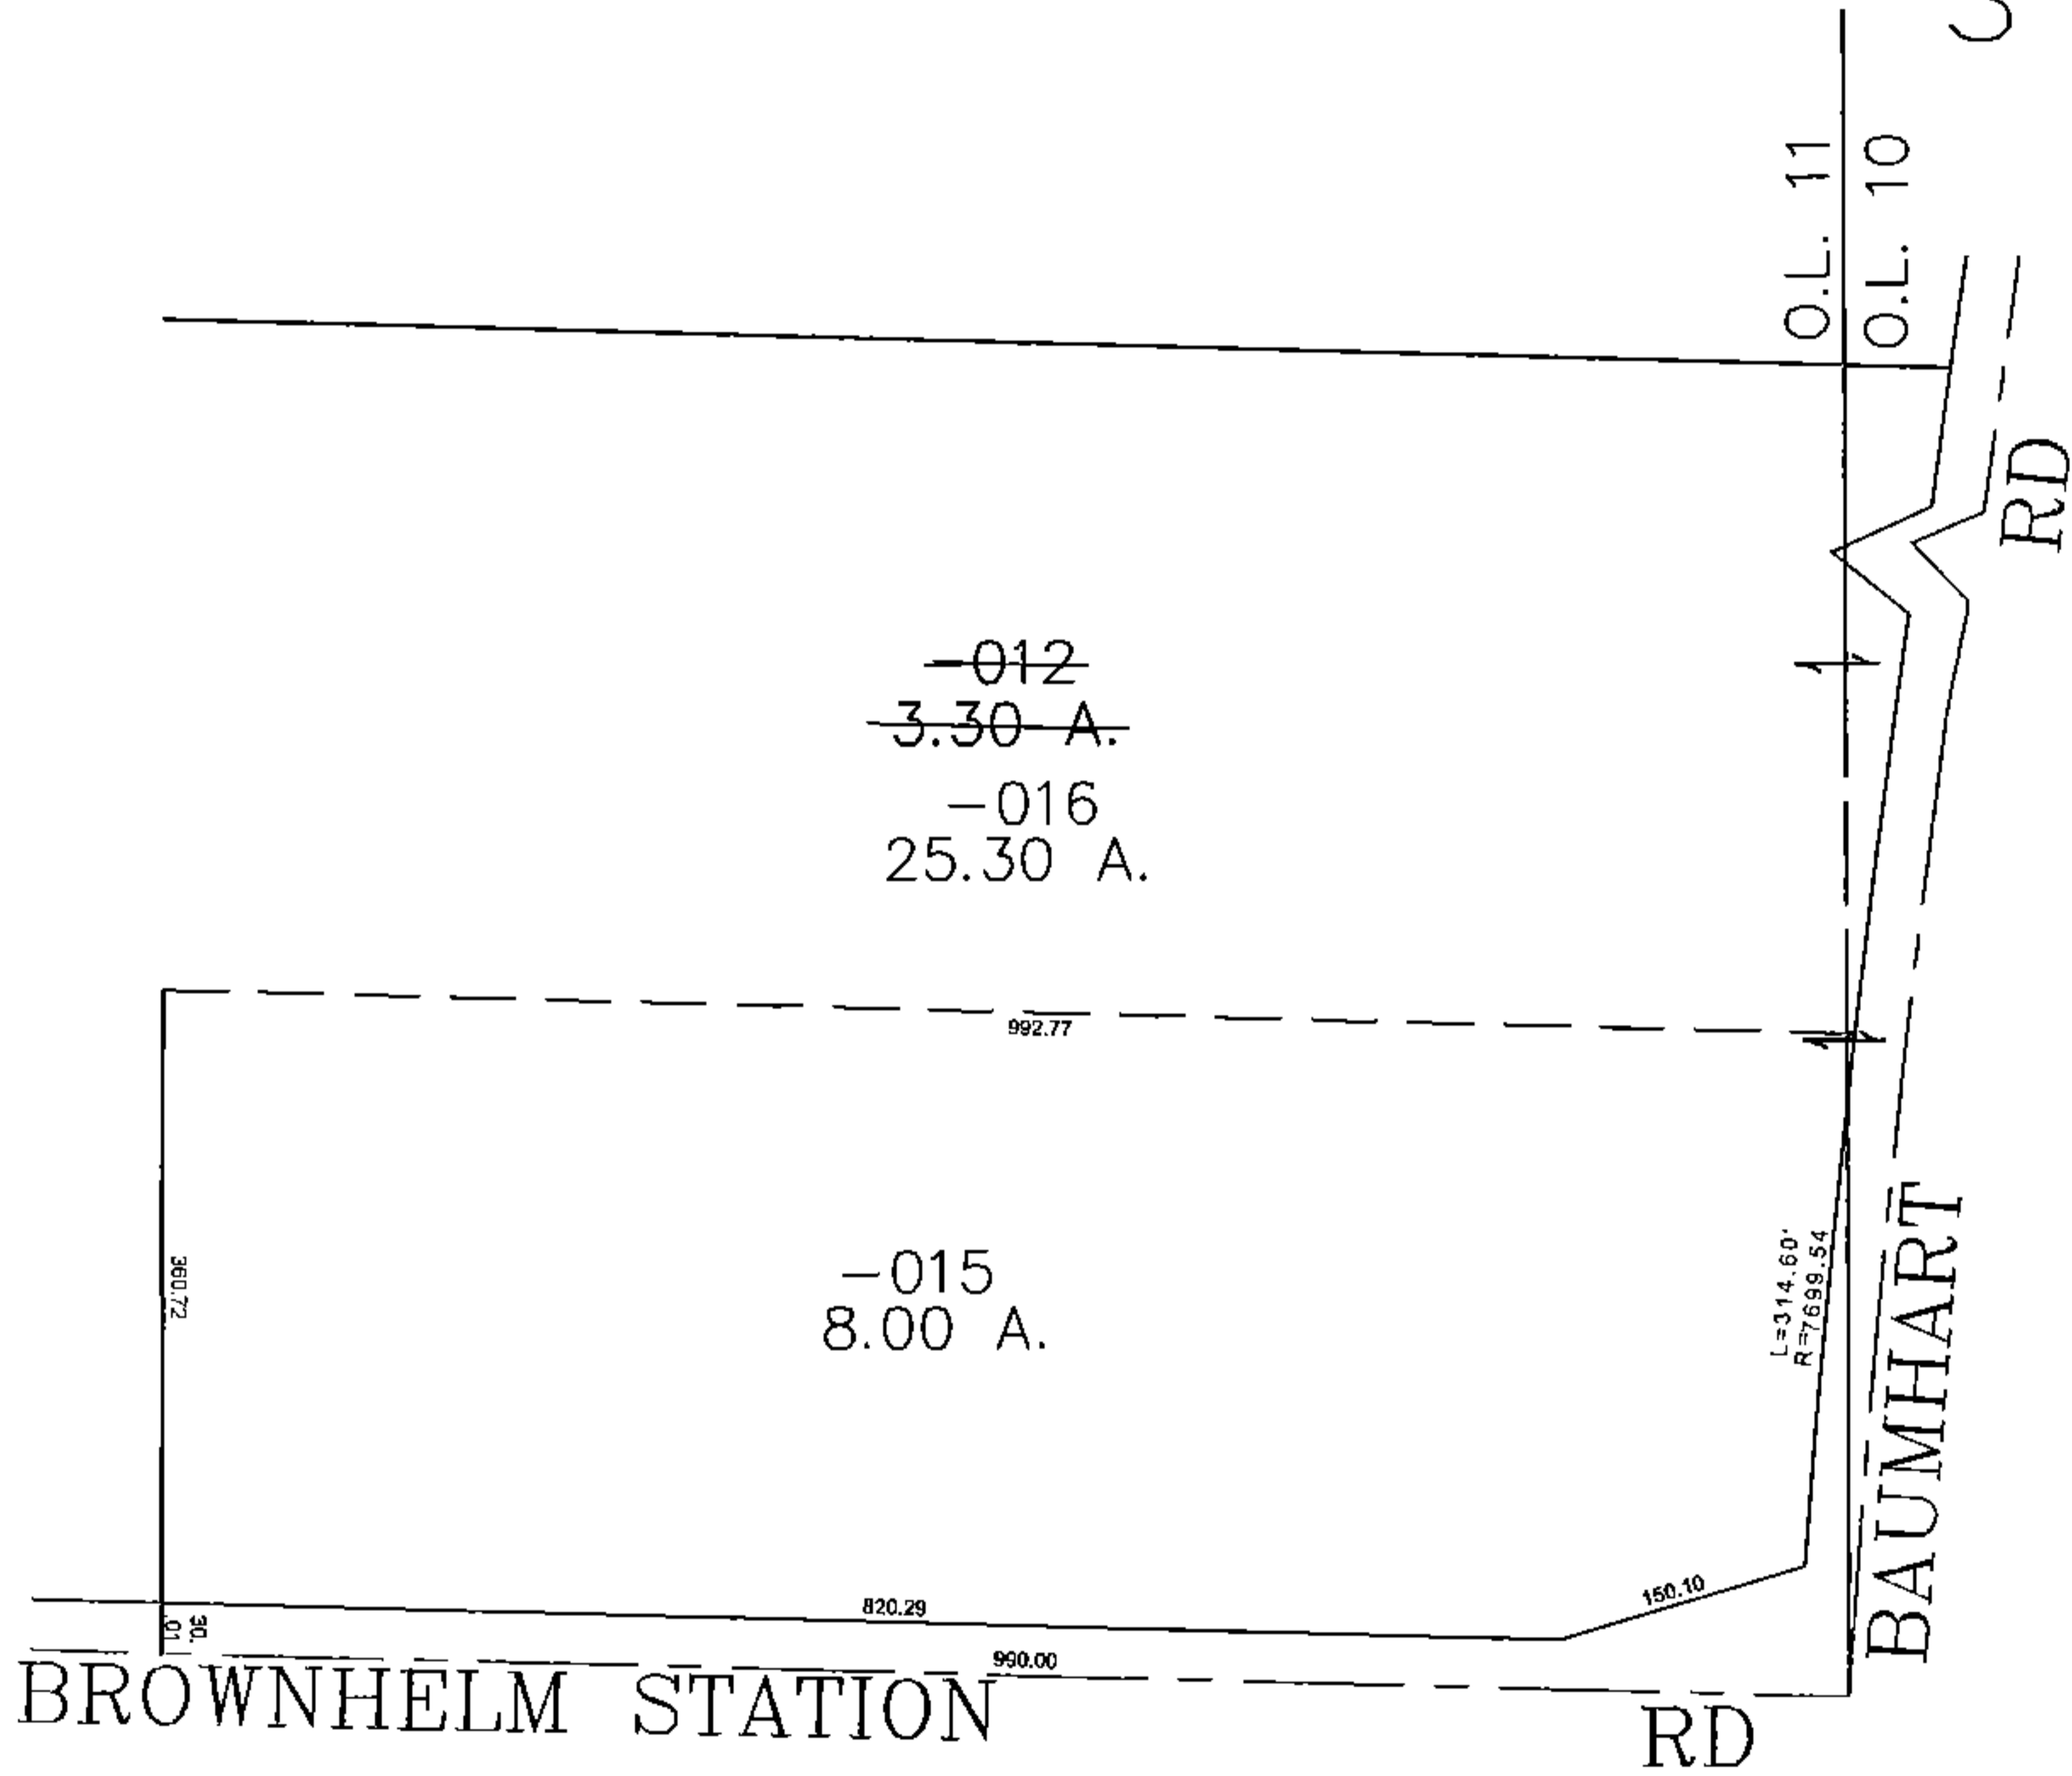


PARENT PARCEL: 01-00-011-000-012

CHILD PARCEL: 01-00-011-000-015, -016

STARTING POINT: CENTERLINE OF BROWNHELM STATION RD & BAUMHART RD

14-03259

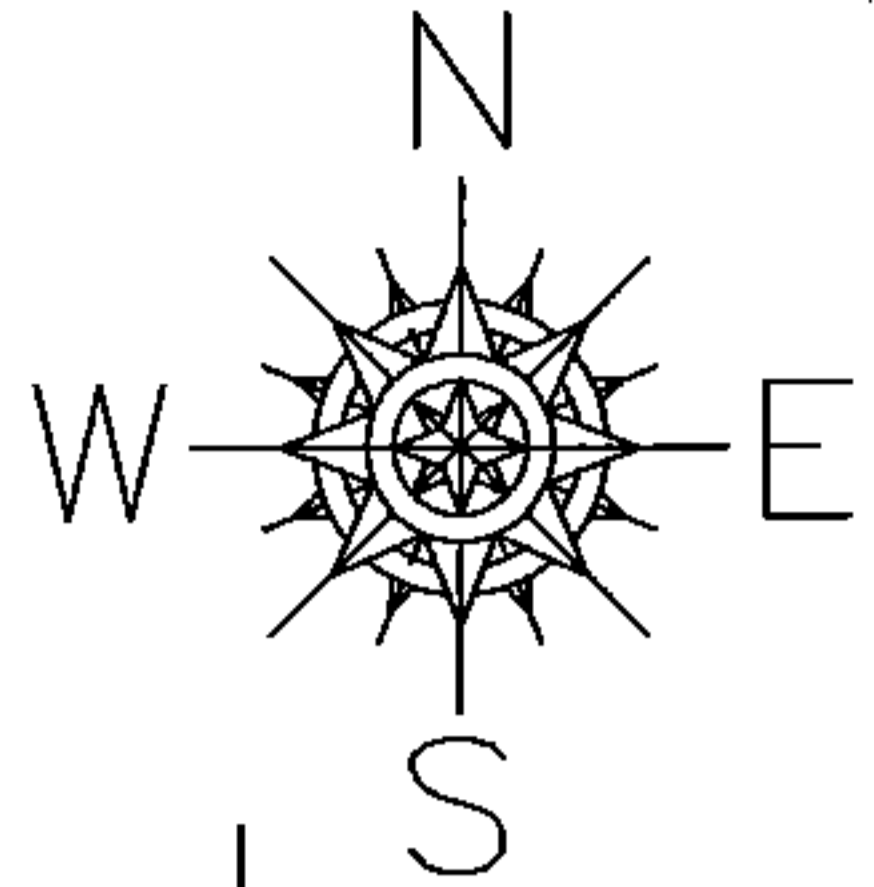

**SPLITS/DEEDS PROCESSED**  
 LORAIN COUNTY TAX MAP DEPARTMENT  
 226 MIDDLE AVE. ELYRIA, OHIO

SURVEYED BY: RICHARD FREDRICKSON  
 CLOSURE: 0.00 : 10,000  
 MAP PAGE(S): 01-00-011  
 APPROVED BY: JAH DATE: 6-13-2014  
 SCALE: 1" = 200' PRIOR INSTRUMENT: 20140492860