

PARENT PARCEL: 10-00-016-900-003
CHILD PARCEL: 11-00-098-900-014 & 10-00-016-900-004
STARTING POINT: PLAT VOL. 51 PG. 36




15-03260-C

SPLIT TO CORRECT OWNERSHIP

~~10-00-016-900-003~~
~~9.26 A.~~
~~OWNER: CARLISLE TWP.~~

11-00-098-900-014
2.00 A.
OWNER: EATON TWP.

10-00-016-900-004
7.26 A.
OWNER: CARLISLE TWP.
CORR. PER PV. 51 PG. 36

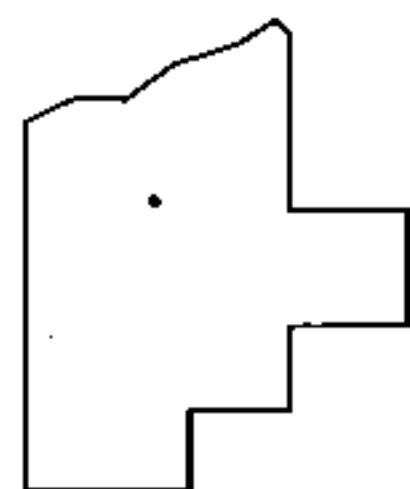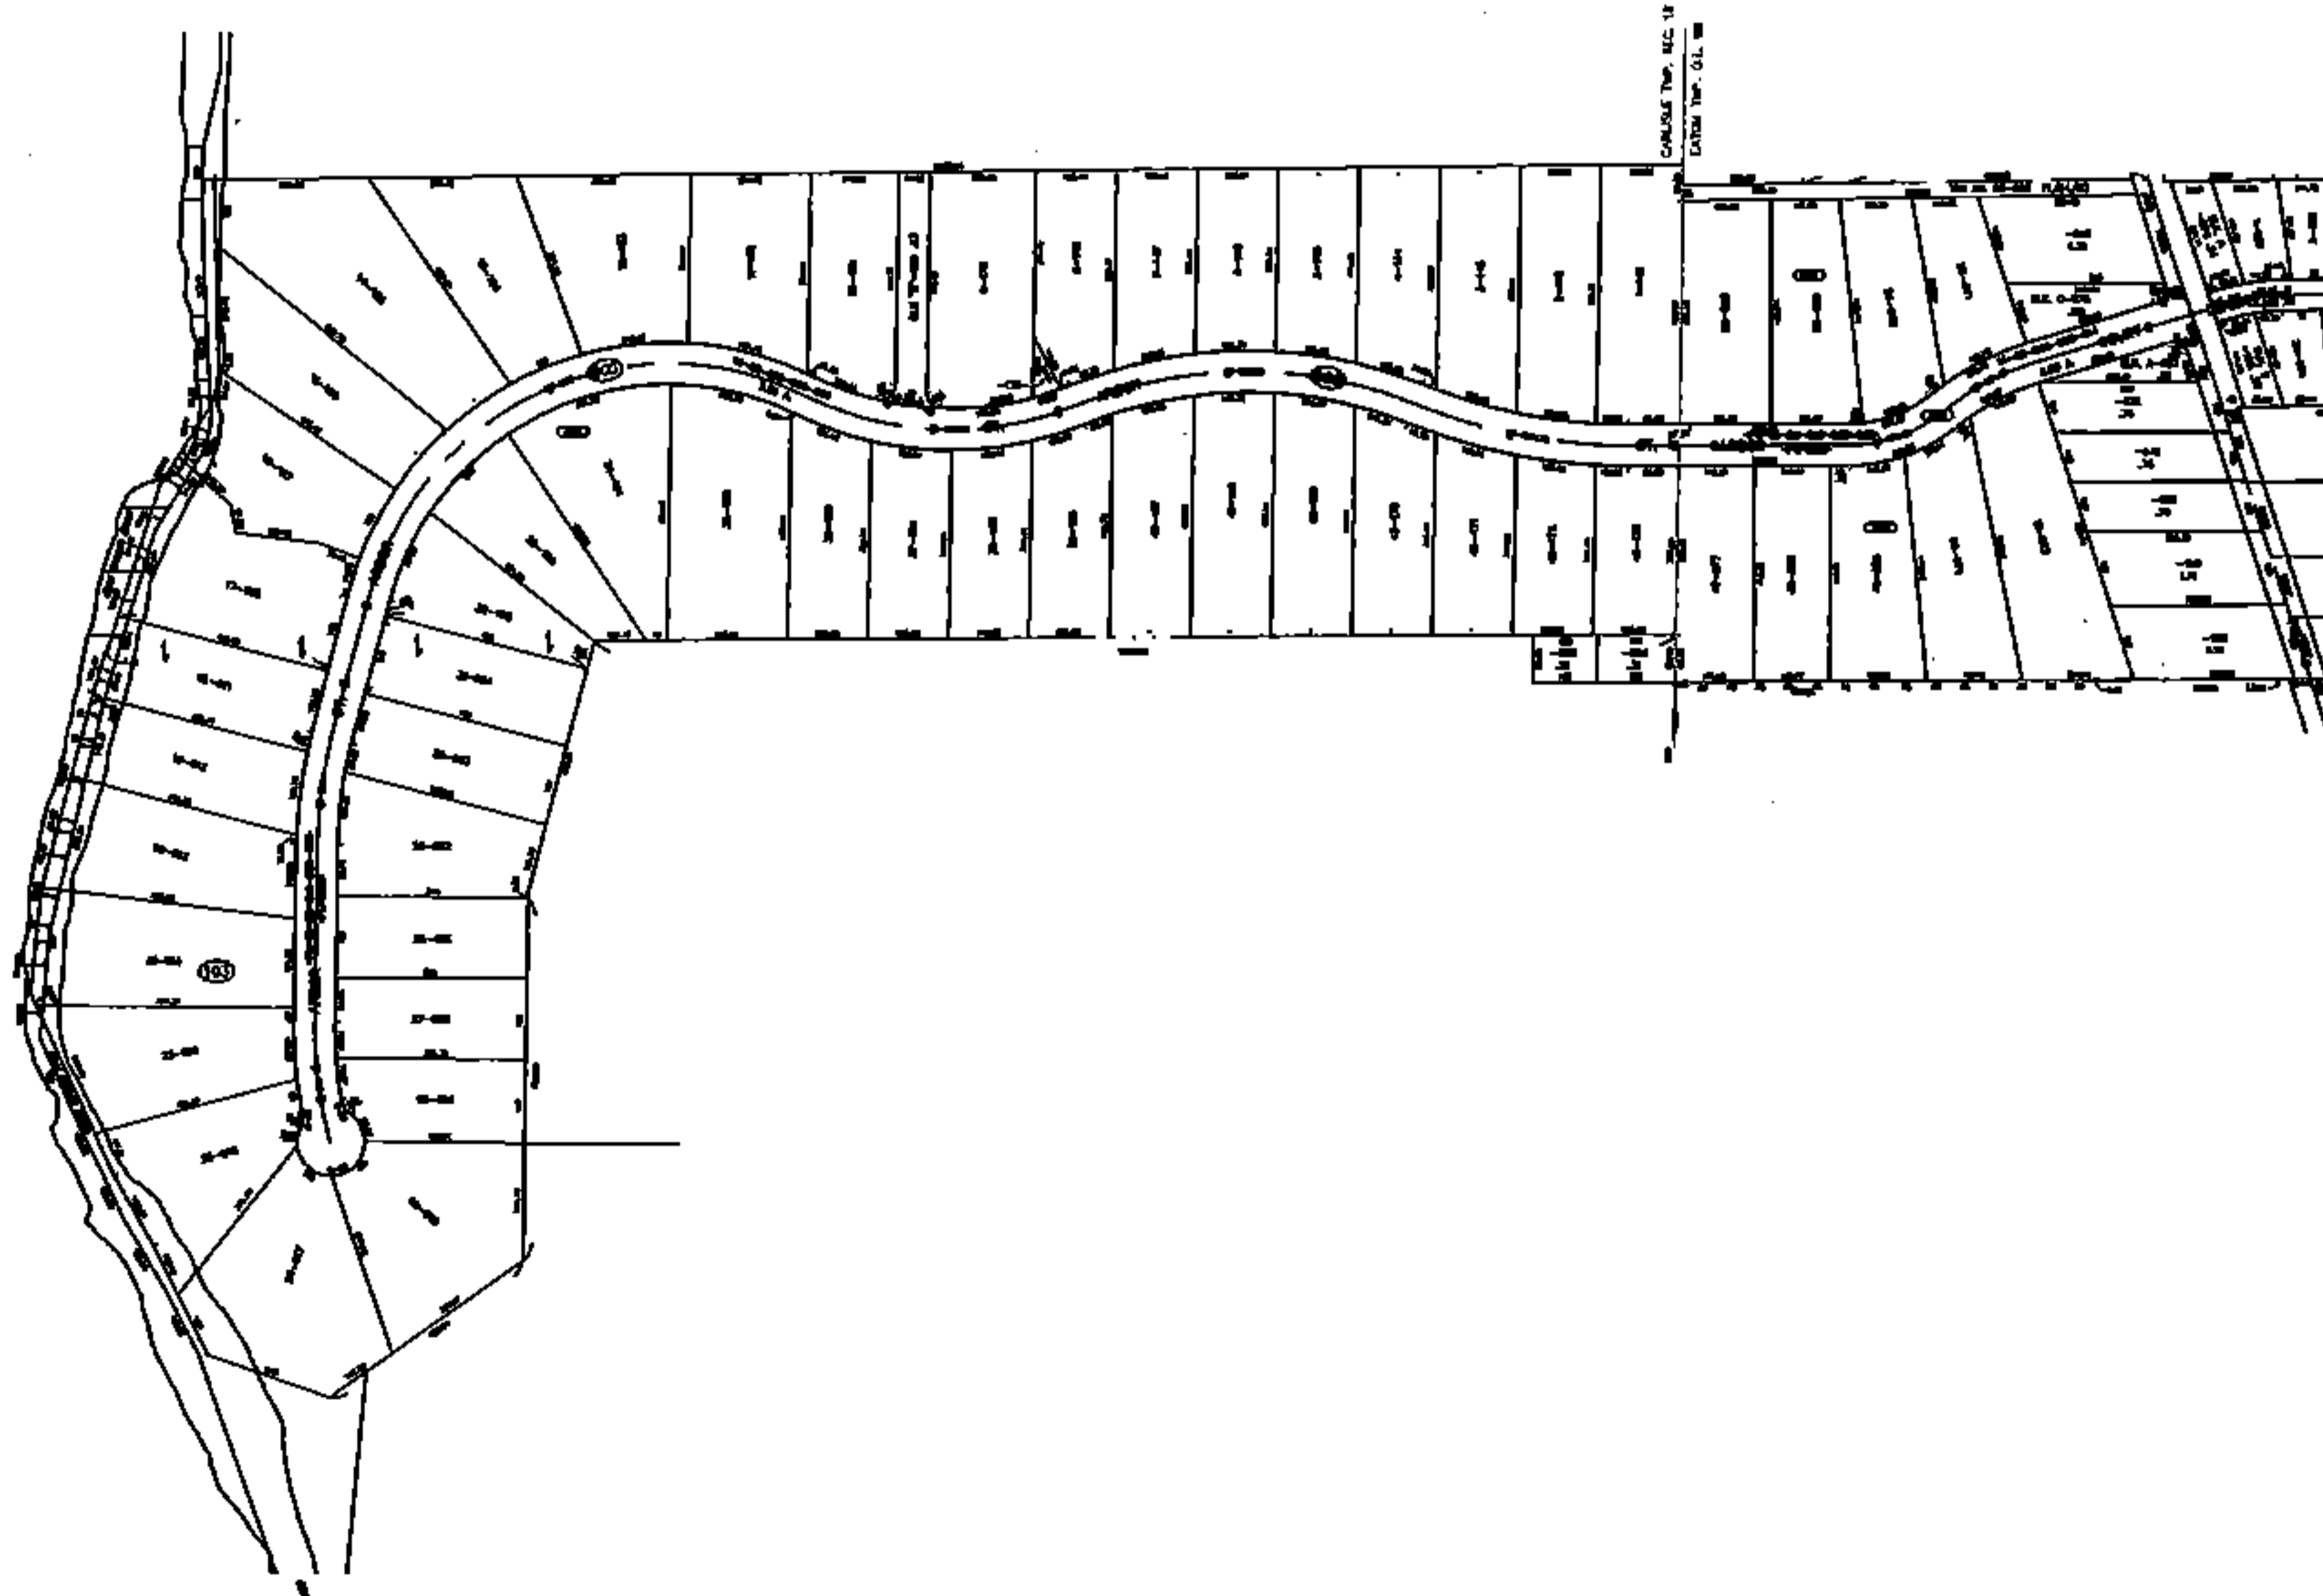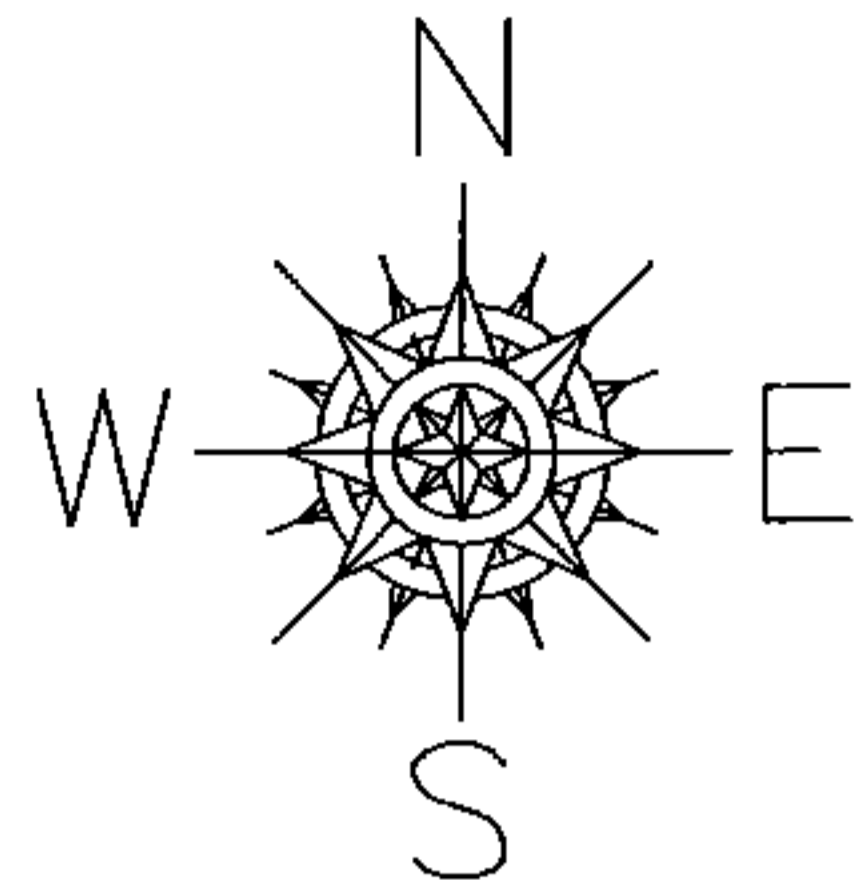

SPLITS/DEEDS PROCESSED
LORAIN COUNTY TAX MAP DEPARTMENT
226 MIDDLE AVE. ELYRIA, OHIO

SURVEYED BY: DAVID L. ELWELL
CLOSURE: NA
MAP PAGE(S): 11-00-098 & 16-00-016
APPROVED BY: TJS DATE: 7/23/15
SCALE: 1"=700 PRIOR INST.: DV XXXX/XXX