
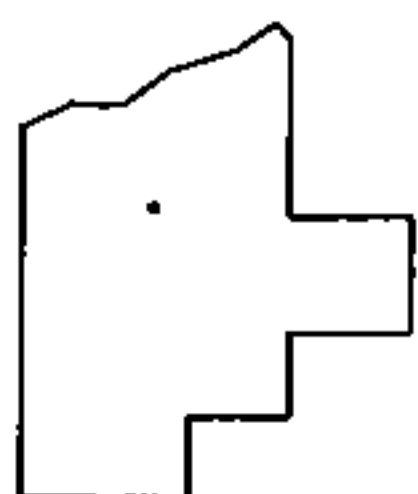
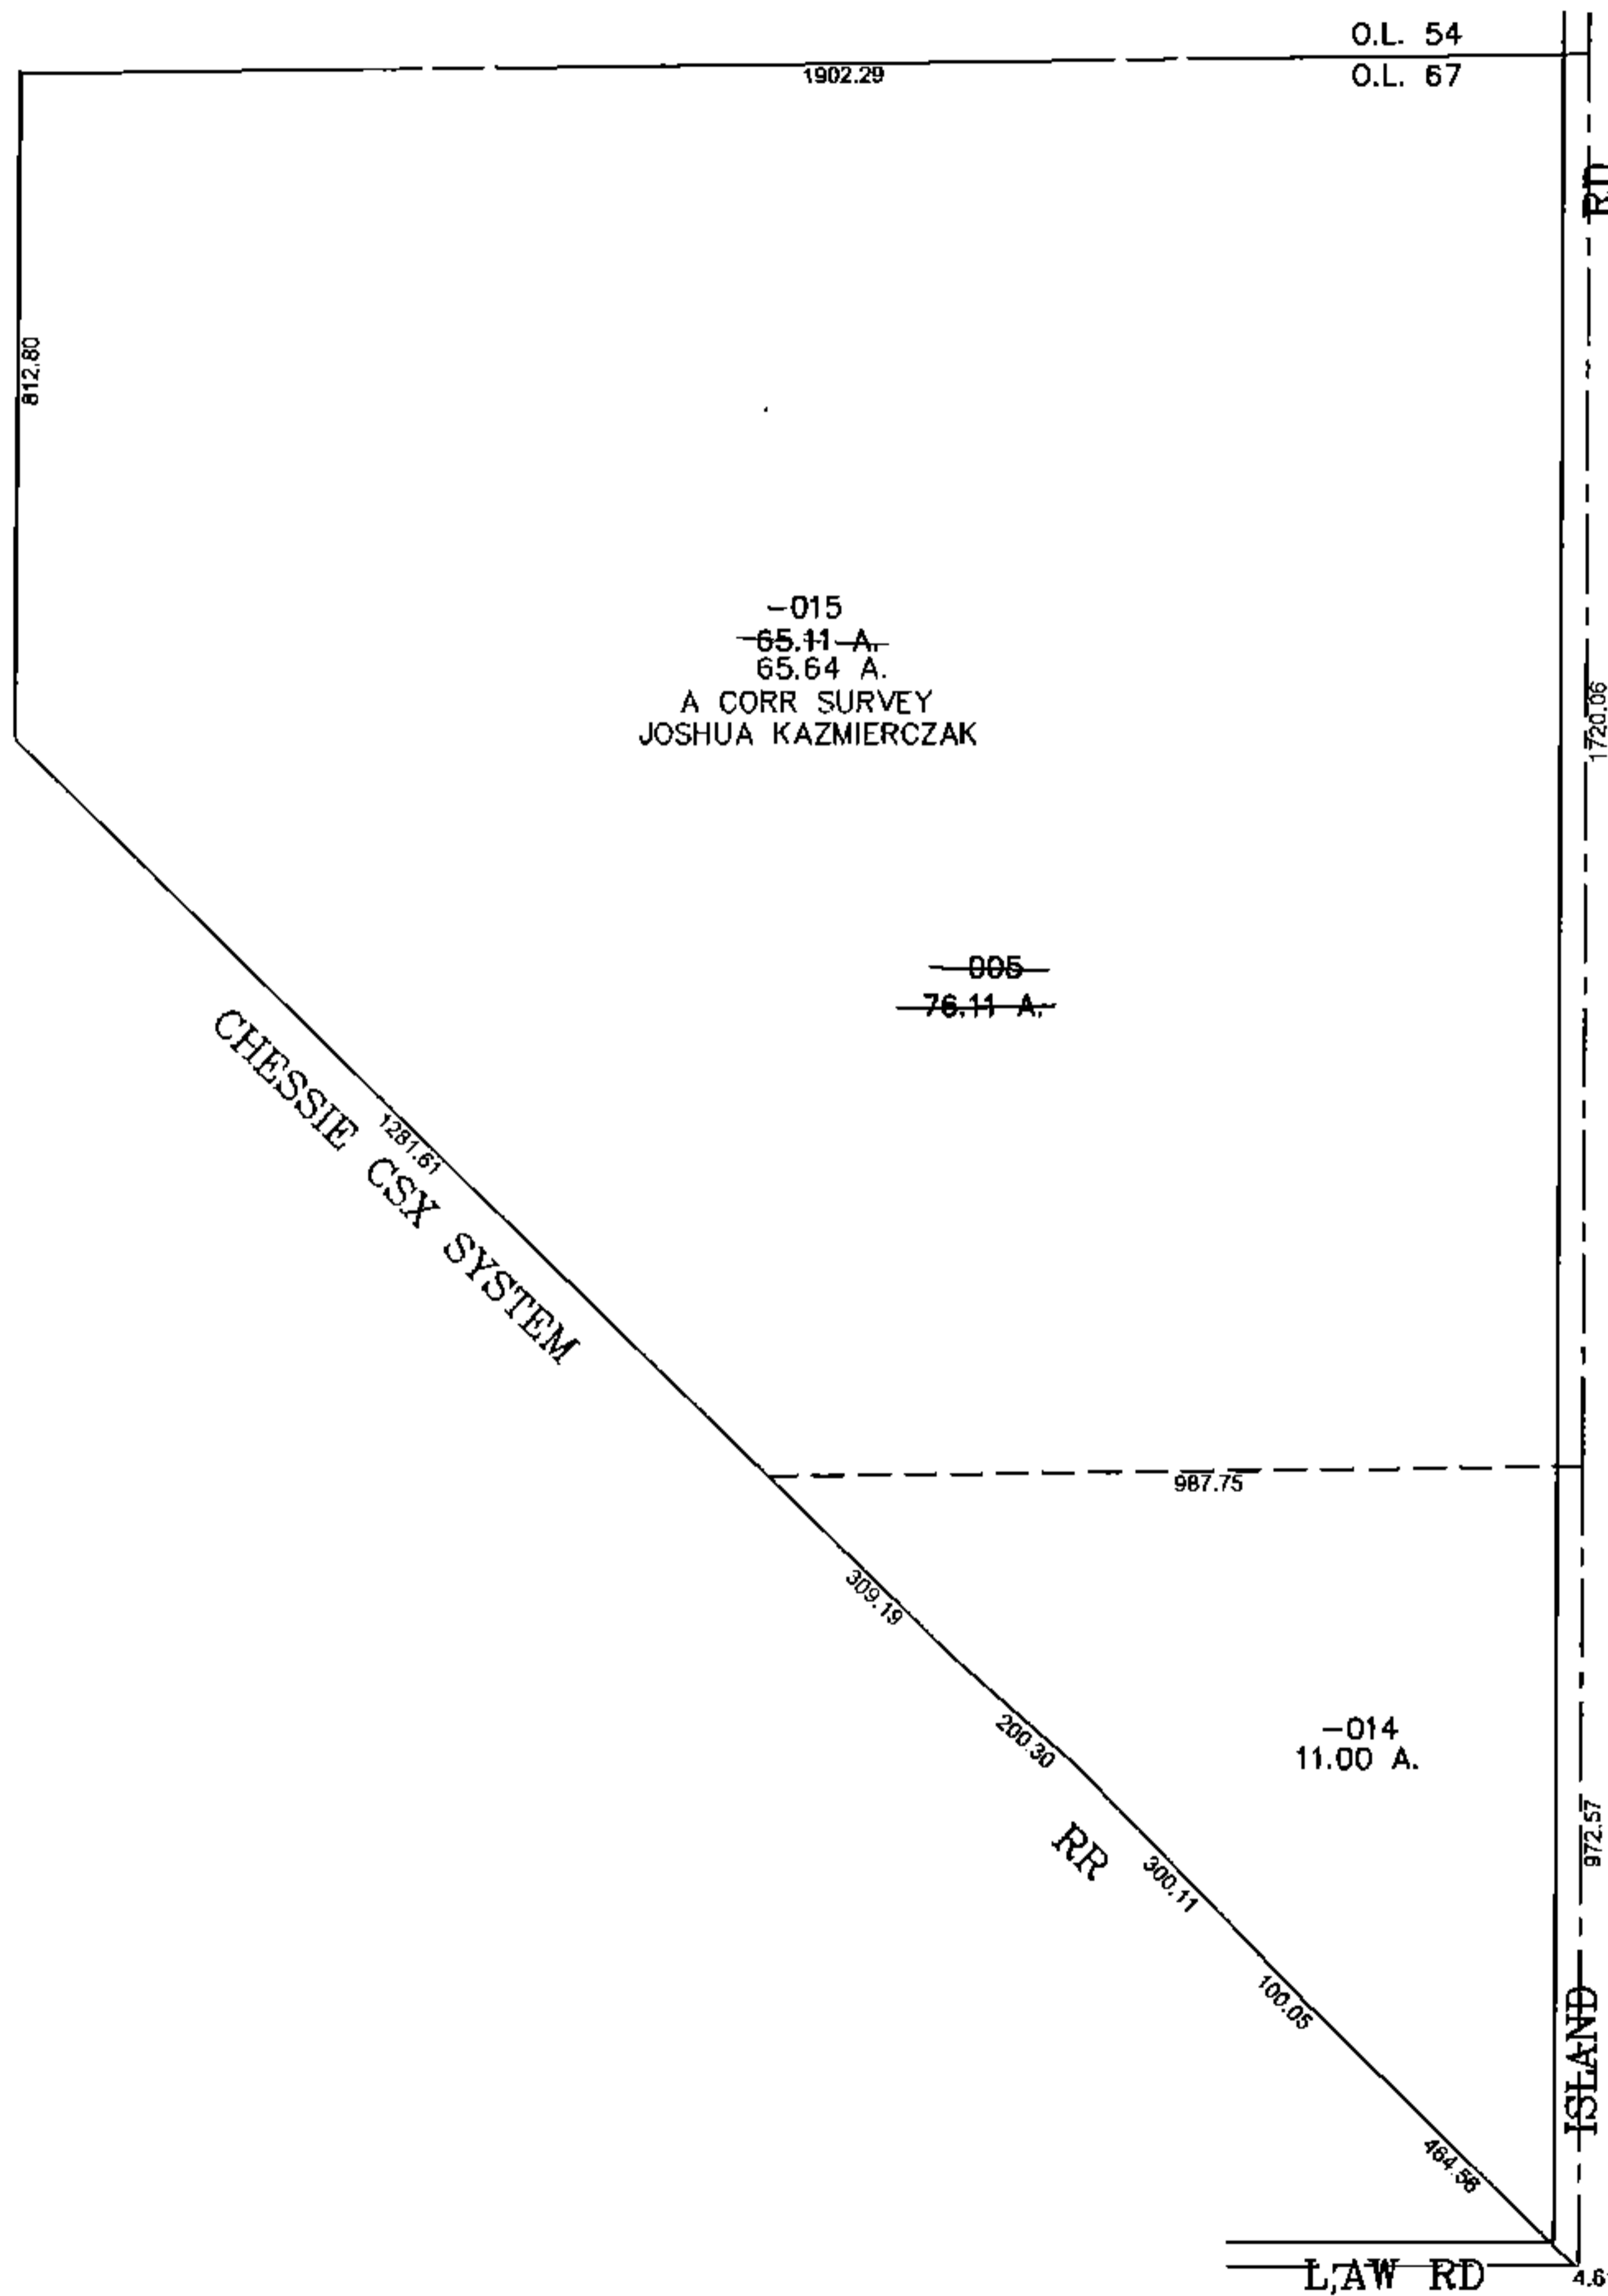


PARENT PARCEL: 16-00-067-000-005

CHILD PARCEL: 16-00-067-000-014, -015

STARTING POINT: CENTERLINE OF LAW RD & ISLAND RD

14-03261

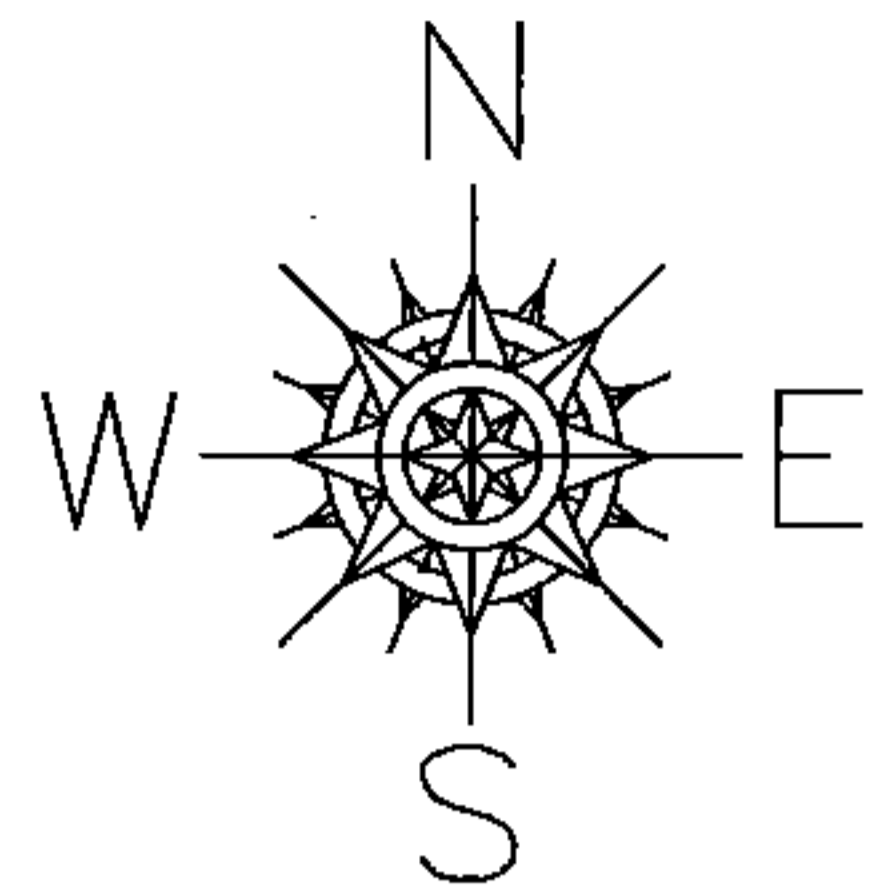

SPLITS/DEEDS PROCESSED

LORAIN COUNTY TAX MAP DEPARTMENT
226 MIDDLE AVE. ELYRIA, OHIO

SURVEYED BY: JOSHUA KAZMIERCZAK

CLOSURE: 0.00 : 10,000

MAP PAGE(S): 16-G

APPROVED BY: JAH DATE: 6-17-2014

SCALE: 1"= 400 PRIOR INST.: DV 1051/470