
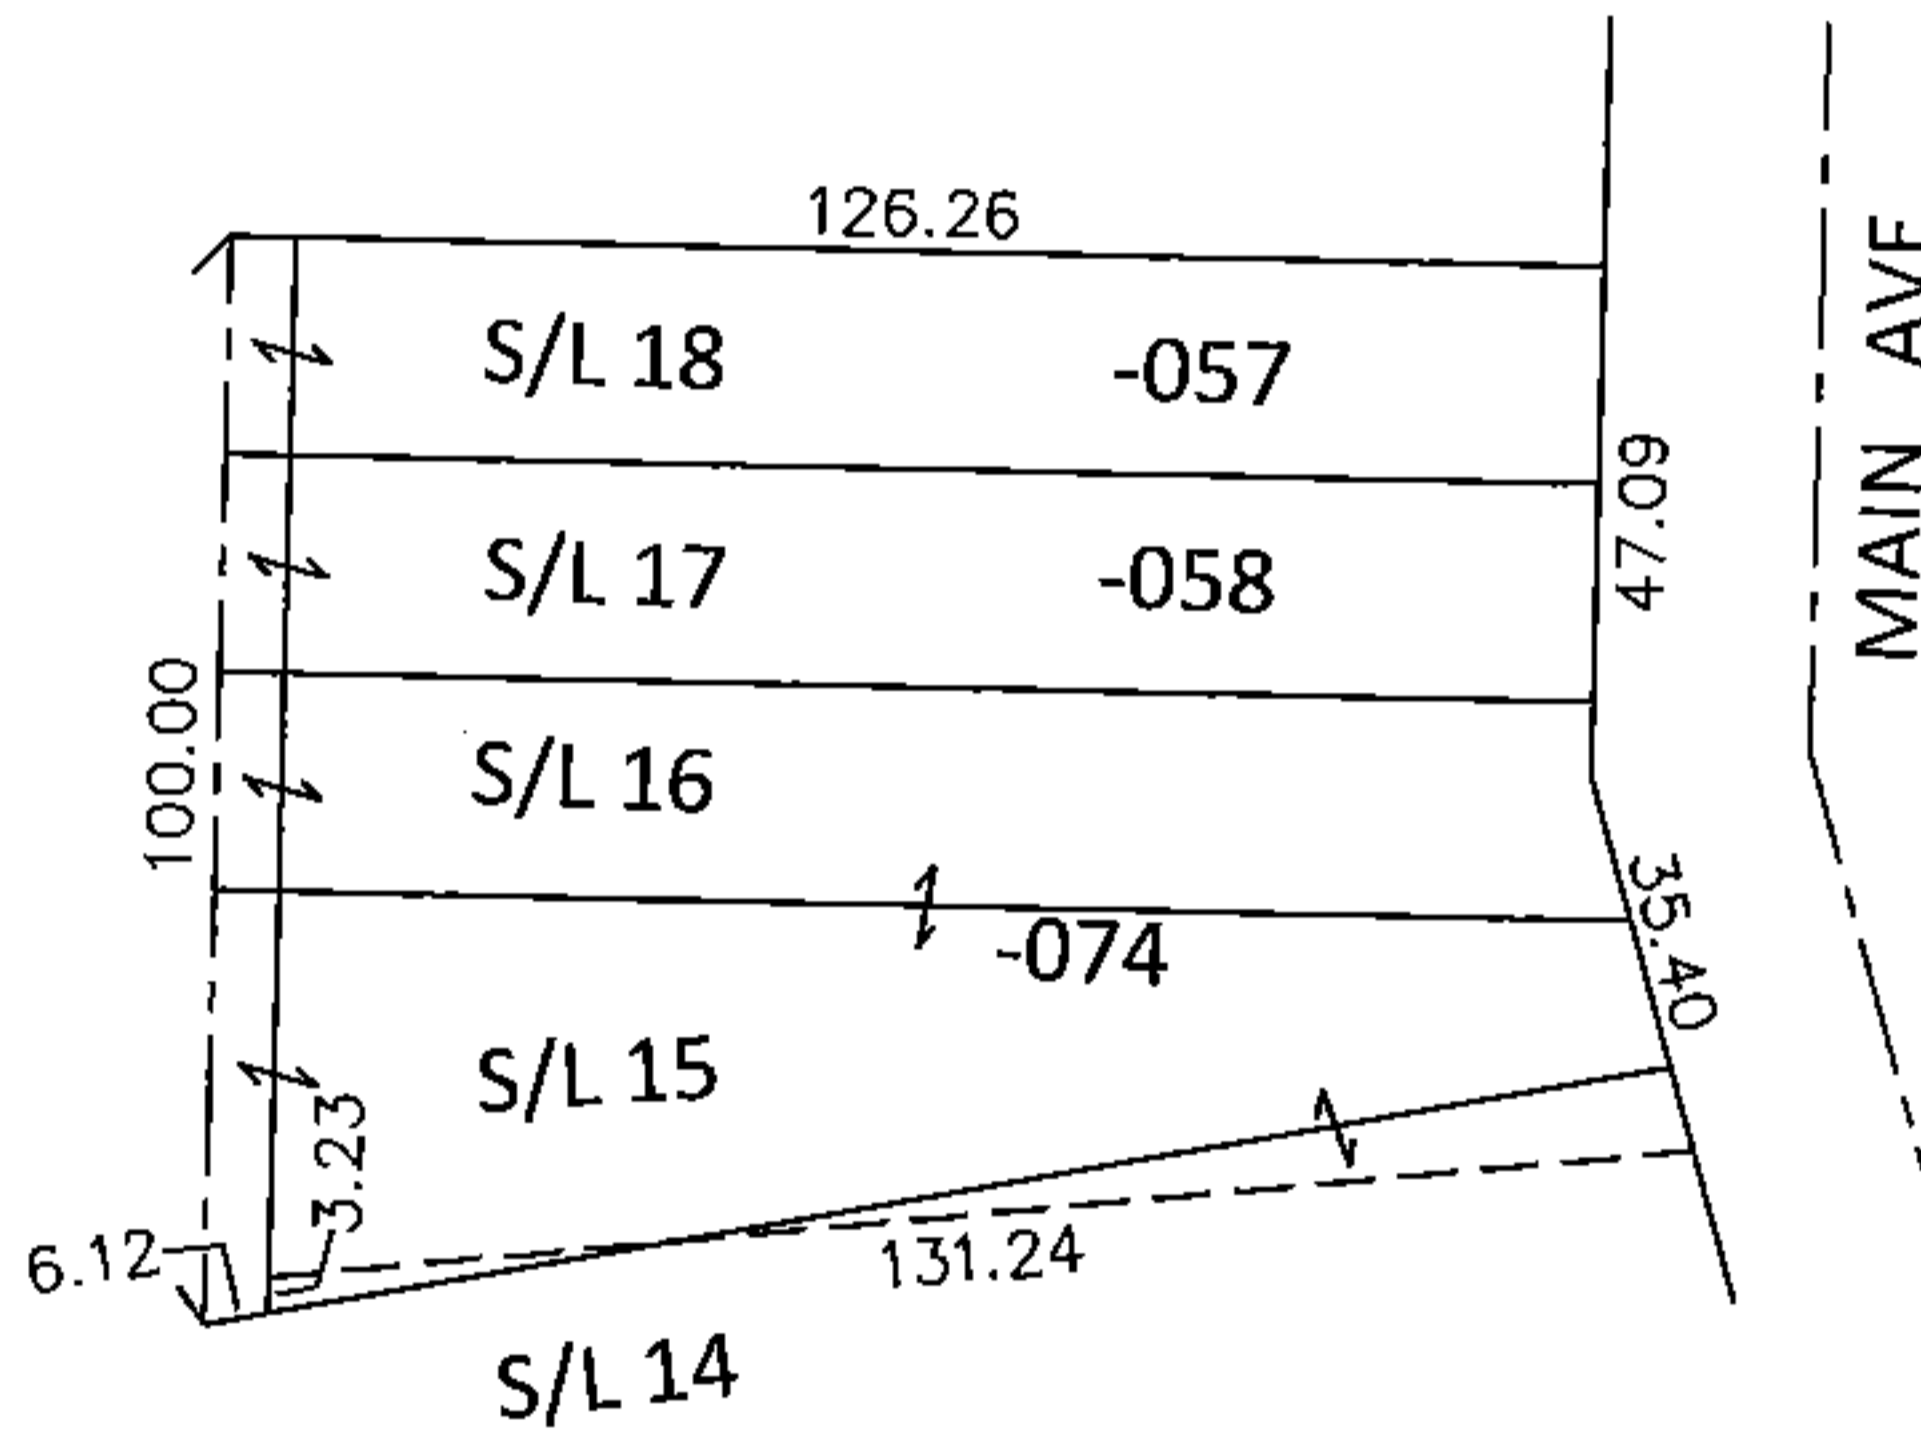


PARENT PARCEL: 07-00-008-111-057,-058,-074

CHILD PARCEL:

STARTING POINT: NORTHEAST CORNER OF S/L 18,BLOCK D IN RIDGEVILLE HEIGHTS (VOL.10 PG.11)

15-03265-D

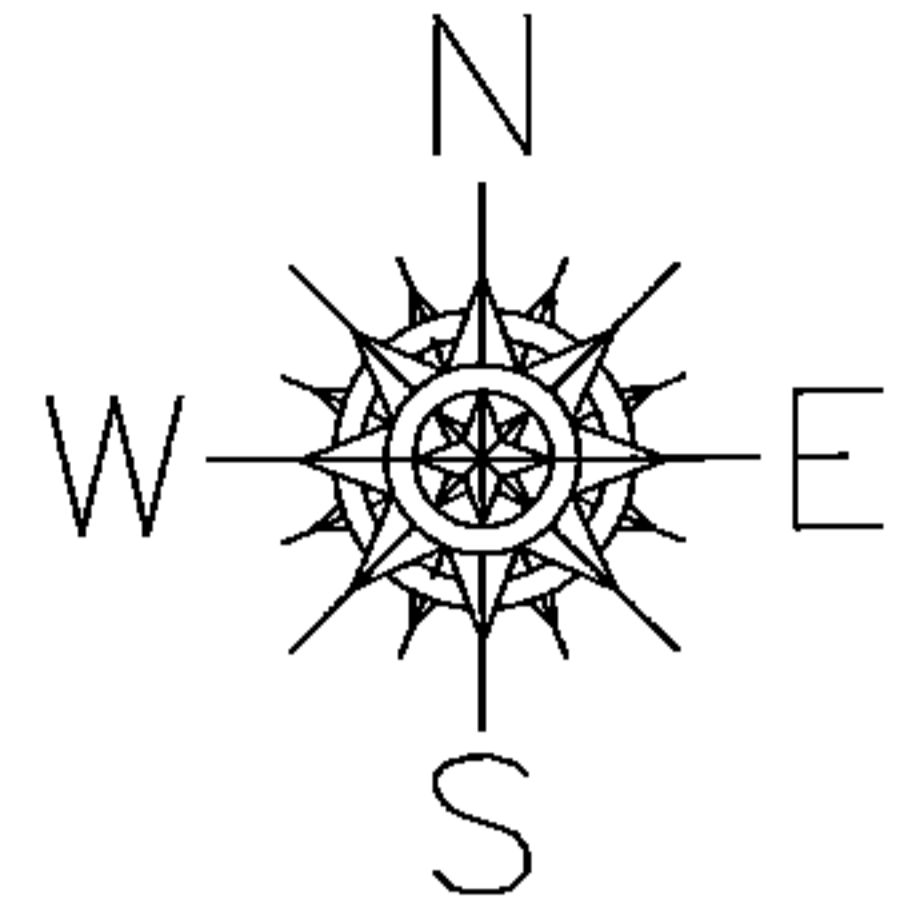

DEPTH CORRECTION


07-00-008-111-057
126.26
~~20 X 126~~

PER SURVEY BY D.HAYWOOD

FRONTAGE & DEPTH CORRECTION

07-00-008-111-074
42.54 X 137.36
~~34.56 X 136~~

PER SURVEY BY D.HAYWOOD

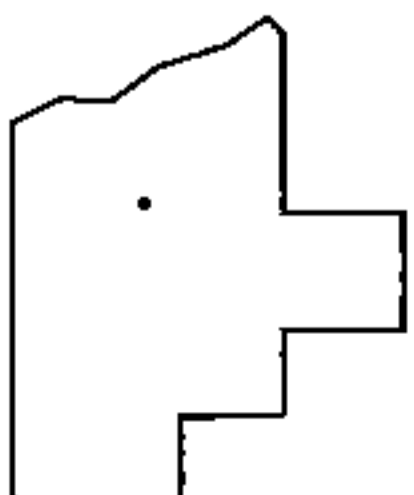

SPLITS/DEEDS PROCESSED

LORAIN COUNTY TAX MAP DEPARTMENT
226 MIDDLE AVE. ELYRIA, OHIO

SURVEYED BY: DALE R. HAYWOOD

CLOSURE: .01:10,000

MAP PAGE(S): 7-00-008-C

APPROVED BY: RRM DATE: 7-30-15

SCALE: 1"= 50' PRIOR INST.: 20150533642