
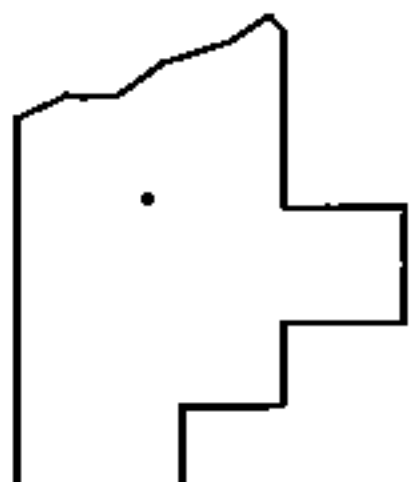
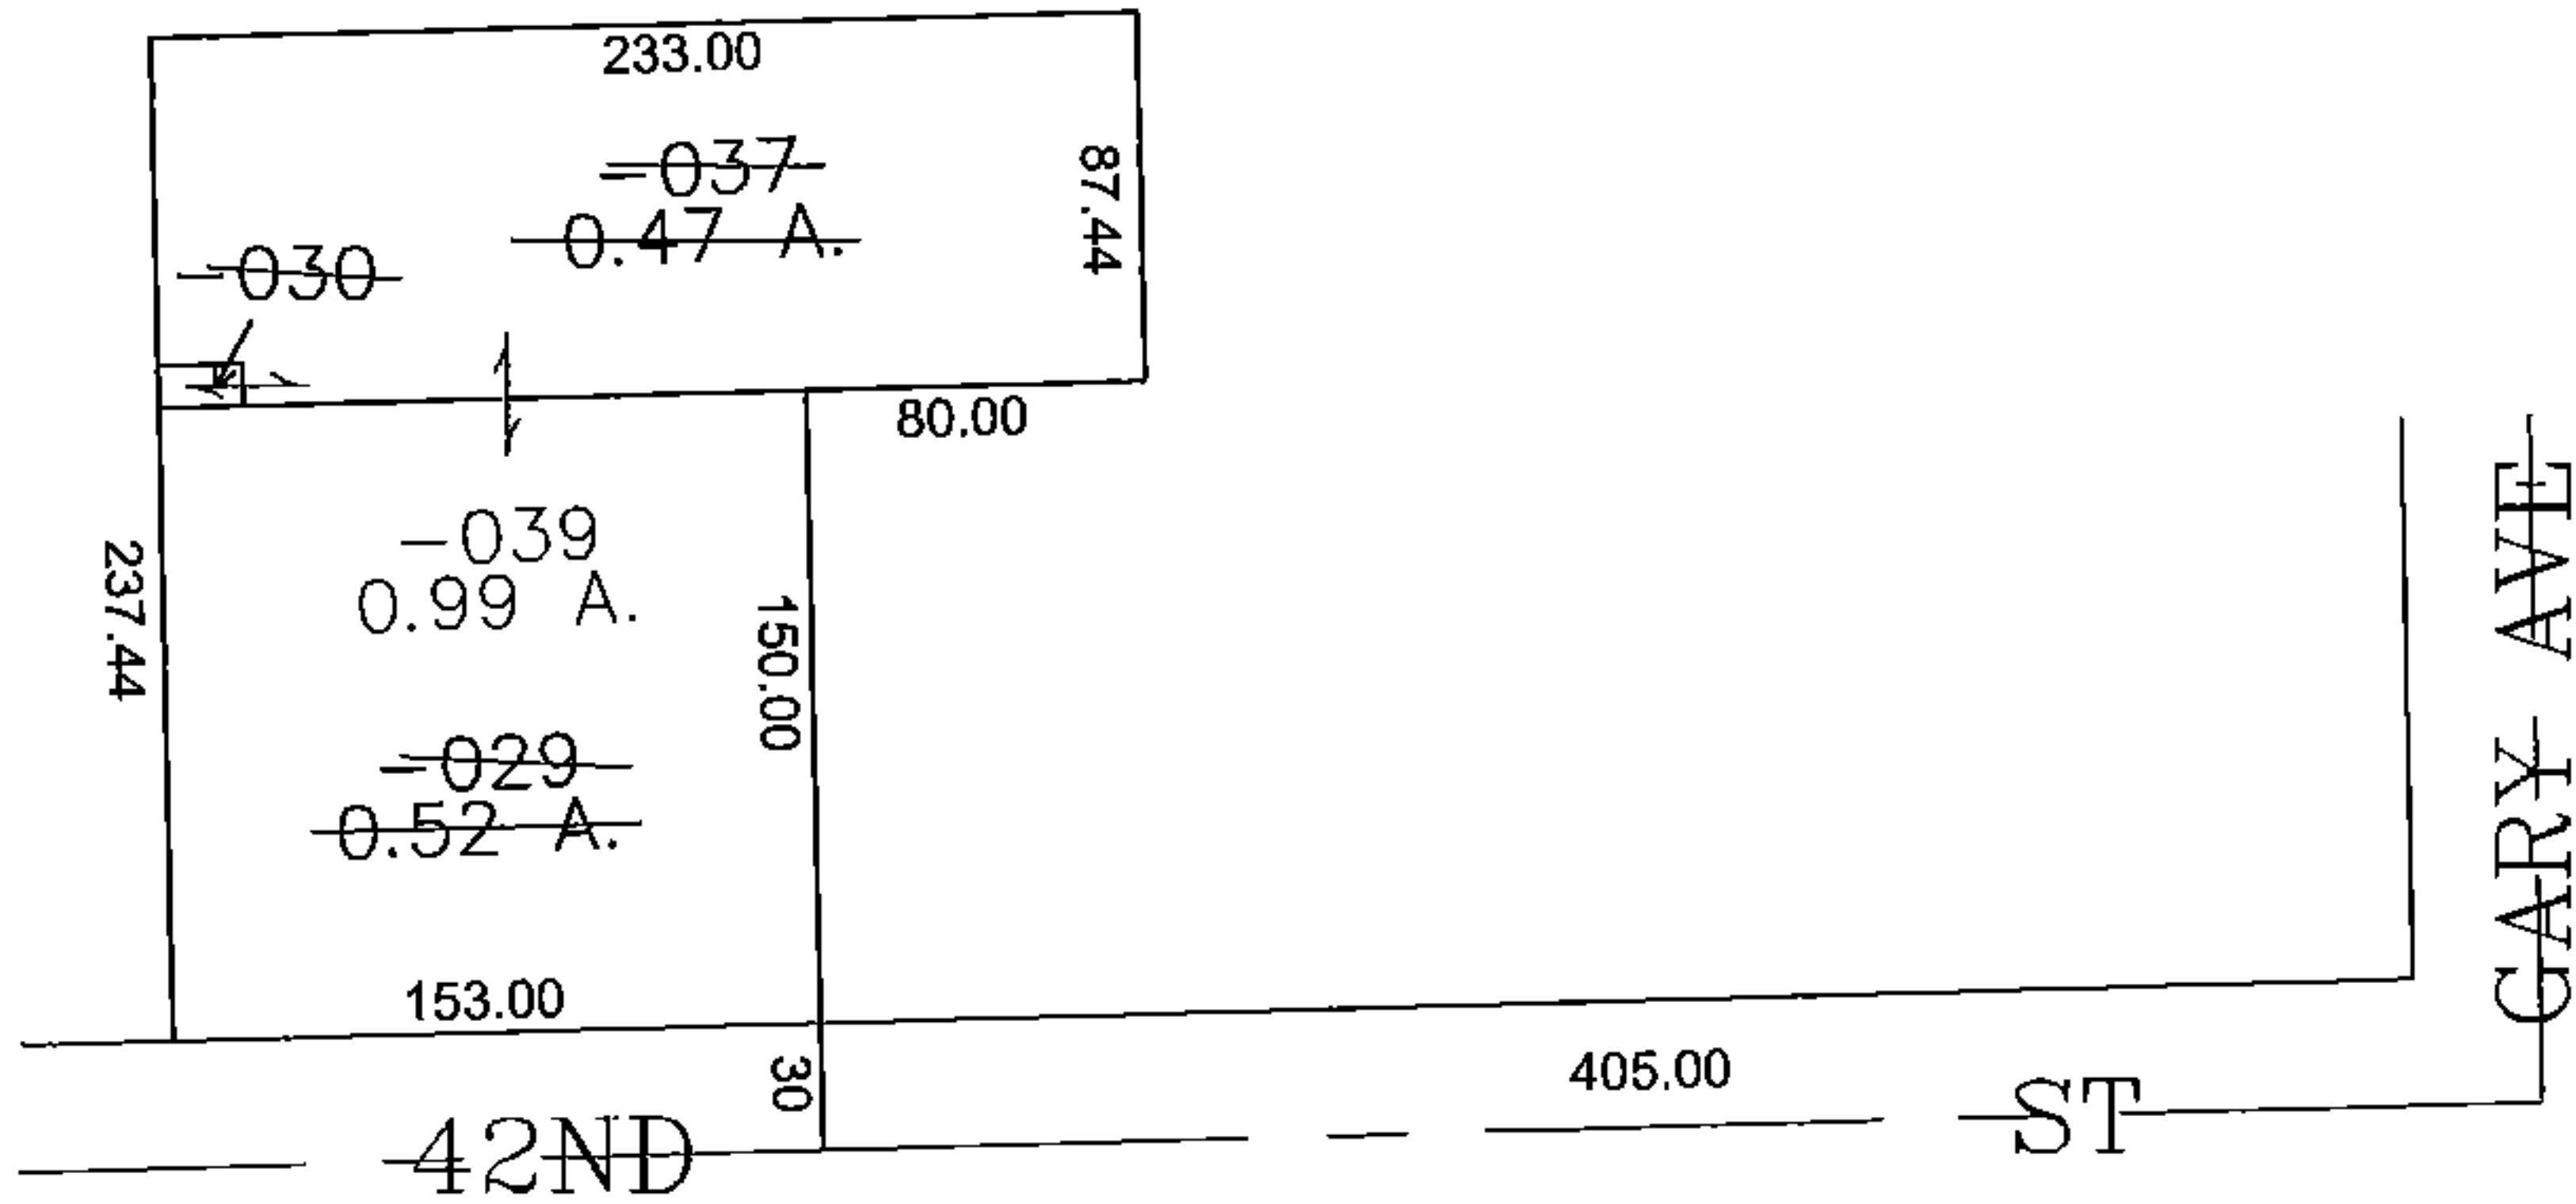


PARENT PARCEL: 03-00-099-114-030, 029, -037

CHILD PARCEL: 03-00-099-114-039

STARTING POINT: CENTERLINE OF 42ND ST & GARY AVE

14-03265

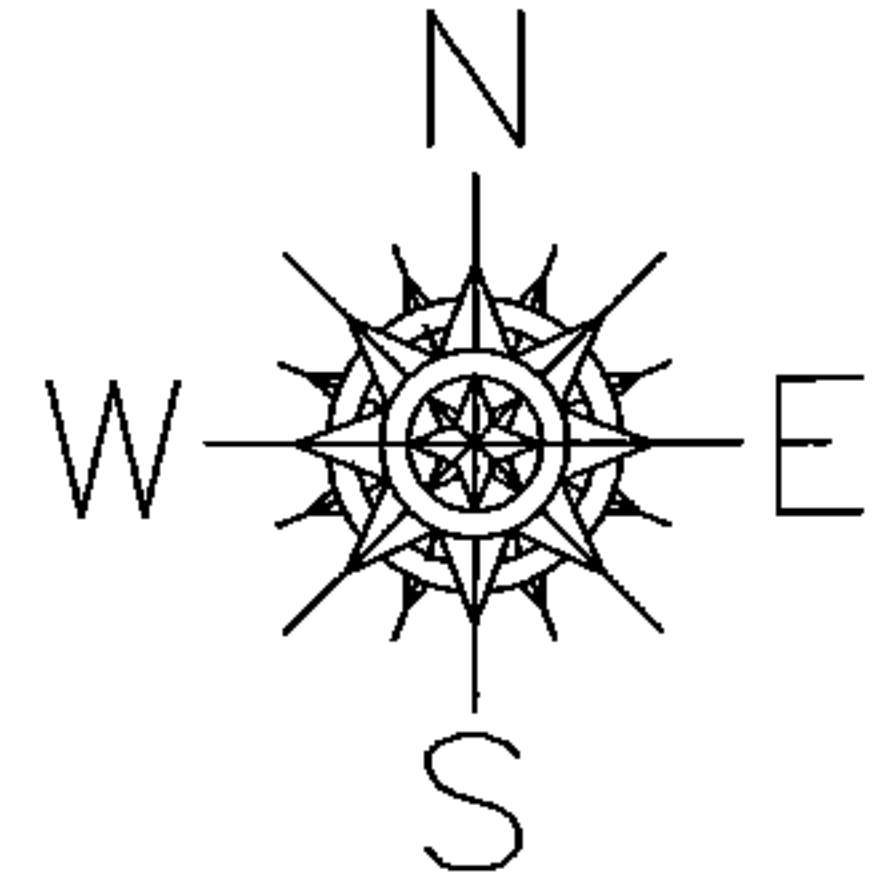

SPLITS/DEEDS PROCESSED

LORAIN COUNTY TAX MAP DEPARTMENT  
226 MIDDLE AVE. ELYRIA, OHIO

SURVEYED BY: BEMBA K JONES  
 CLOSURE: 0.00 : 10,000  
 MAP PAGE(S): 03-00-099-B  
 APPROVED BY: JAH DATE: 7/9/2014  
 SCALE: 1" = 100 PRIOR INSTRUMENT: 20140501283