

PARENT PARCEL: 07-00-004-101-006, 07-00-009-122-008, & -021

CHILD PARCEL: 07-00-004-900-003 & 07-00-009-900-009

STARTING POINT: PLAT VOL. 22 PG. 88, PLAT VOL. 23 PG. 5, & PLAT VOL. 23 PG. 6

15-03268-C

ADD TO DUPLICATE

07-00-004-900-003

2.55 A.

OWNER: CITY OF NORTH RIDGEVILLE

07-00-009-900-009

1.87 A.

OWNER: CITY OF NORTH RIDGEVILLE

DROP FROM DUP.

~~07-00-004-101-006~~

~~2.55 A.~~

~~OWNER: BARB INC.~~

~~07-00-009-122-008~~




~~60 X 287~~

~~OWNER: BARB INC.~~

~~07-00-009-122-021~~

~~1.38 A.~~

~~OWNER: BARB INC.~~

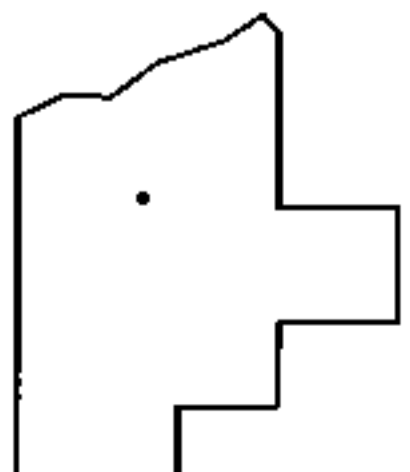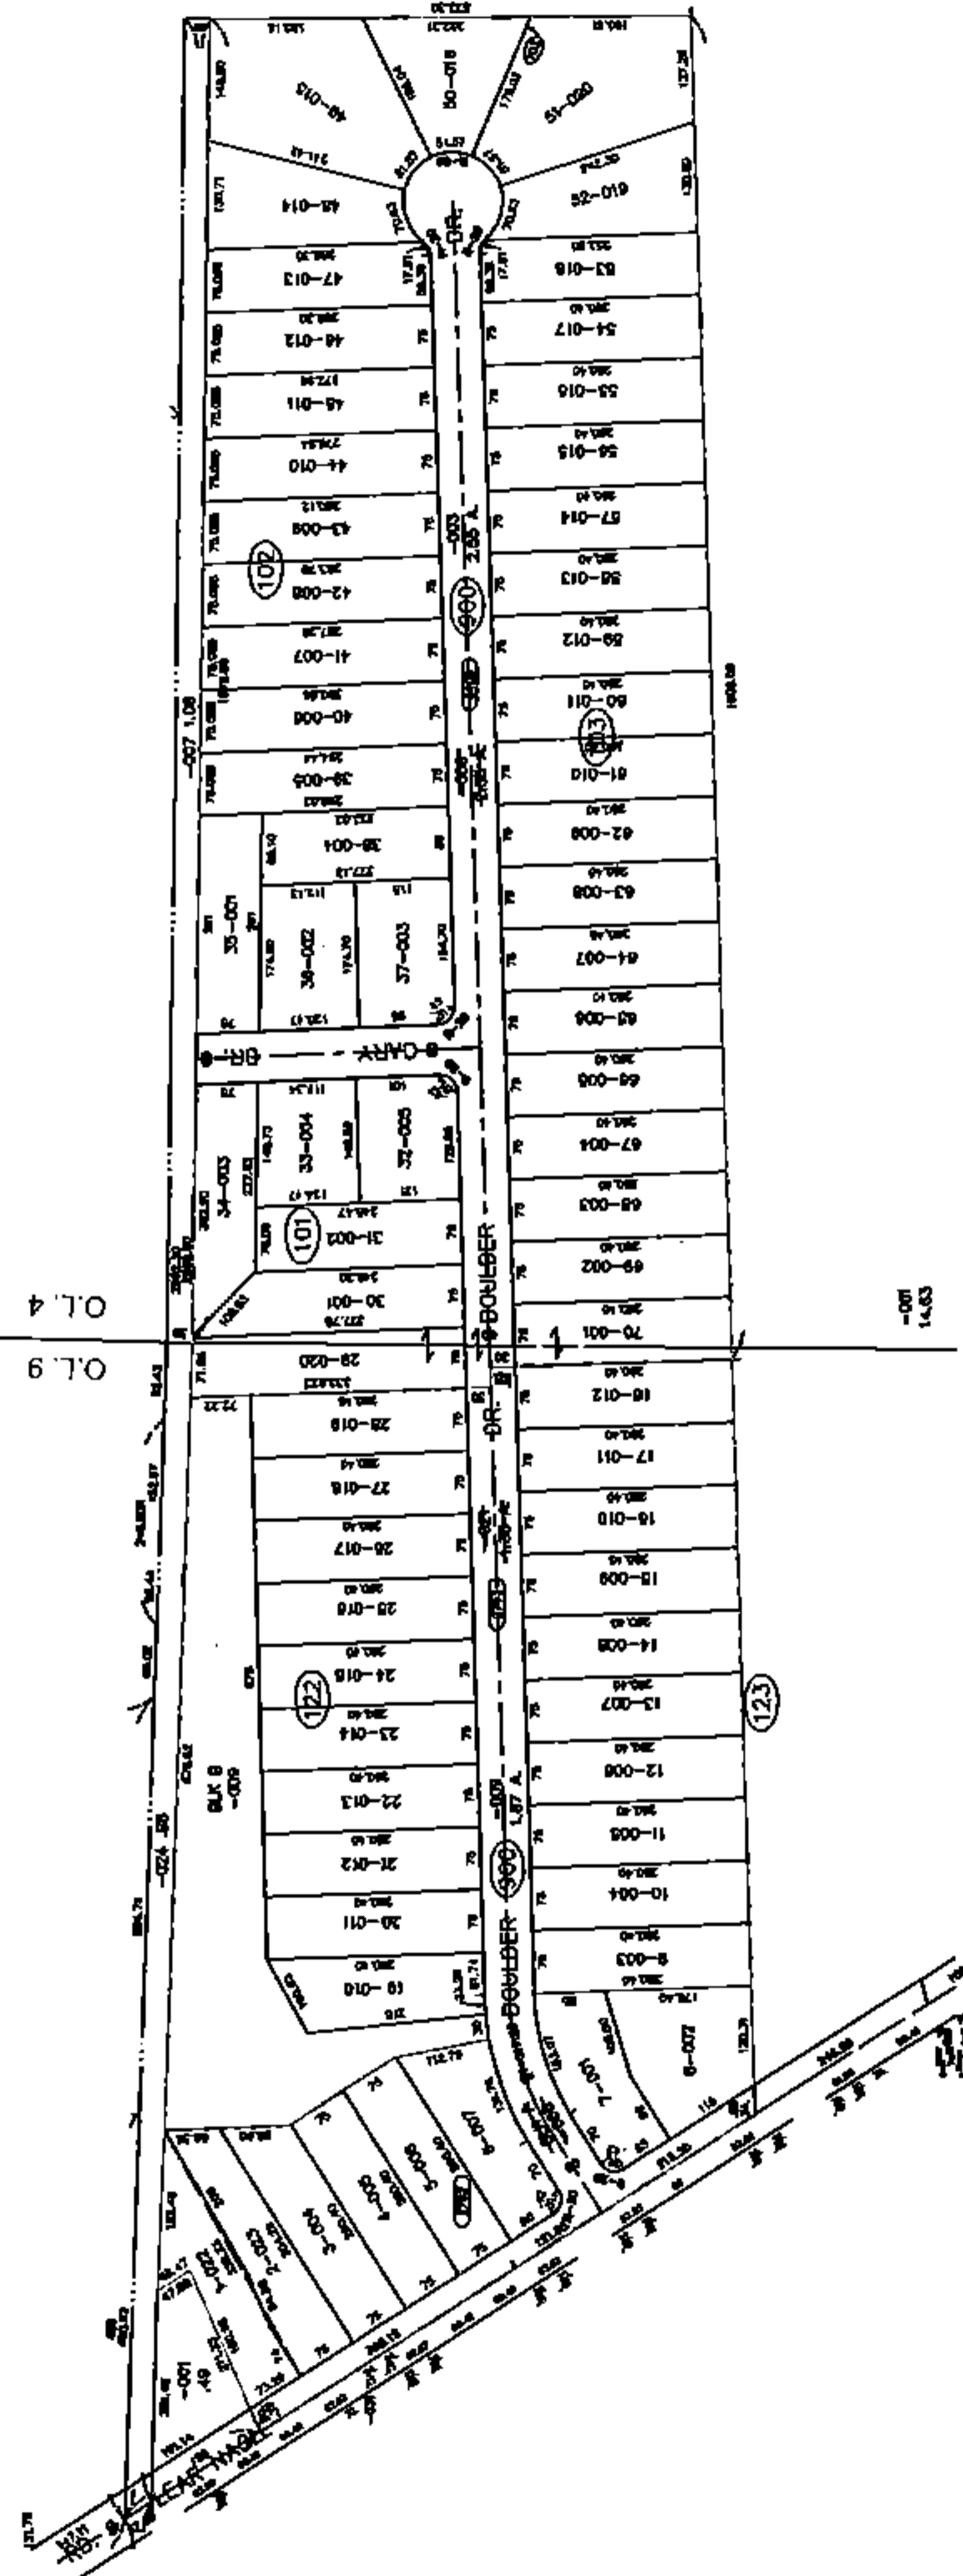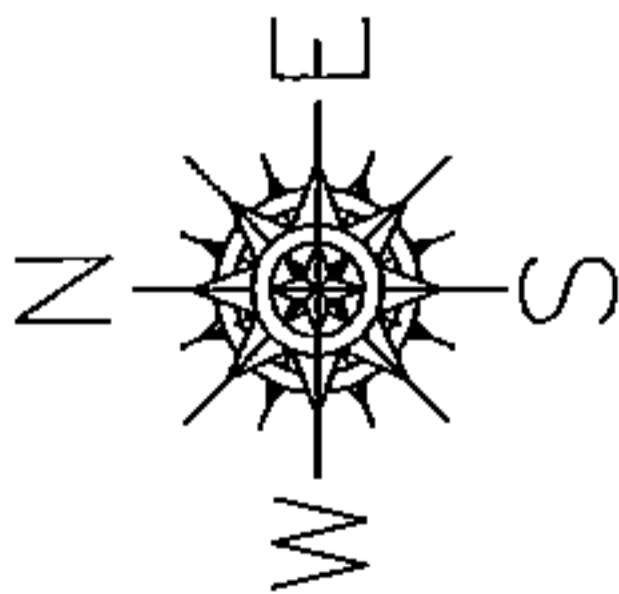

SPLITS/DEEDS PROCESSED

LORAIN COUNTY TAX MAP DEPARTMENT
226 MIDDLE AVE. ELYRIA, OHIO

SURVEYED BY: A.H. WUNDERLICH

CLOSURE: NA

MAP PAGE(S): 07-00-004 & -009

APPROVED BY: TJS DATE: 8/3/15

SCALE: 1"= 400 PRIOR INST.: DV XXXX/XXX