
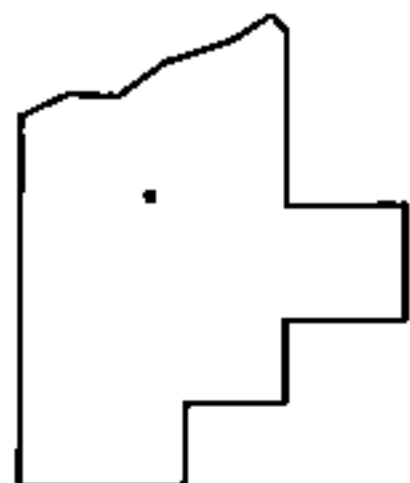
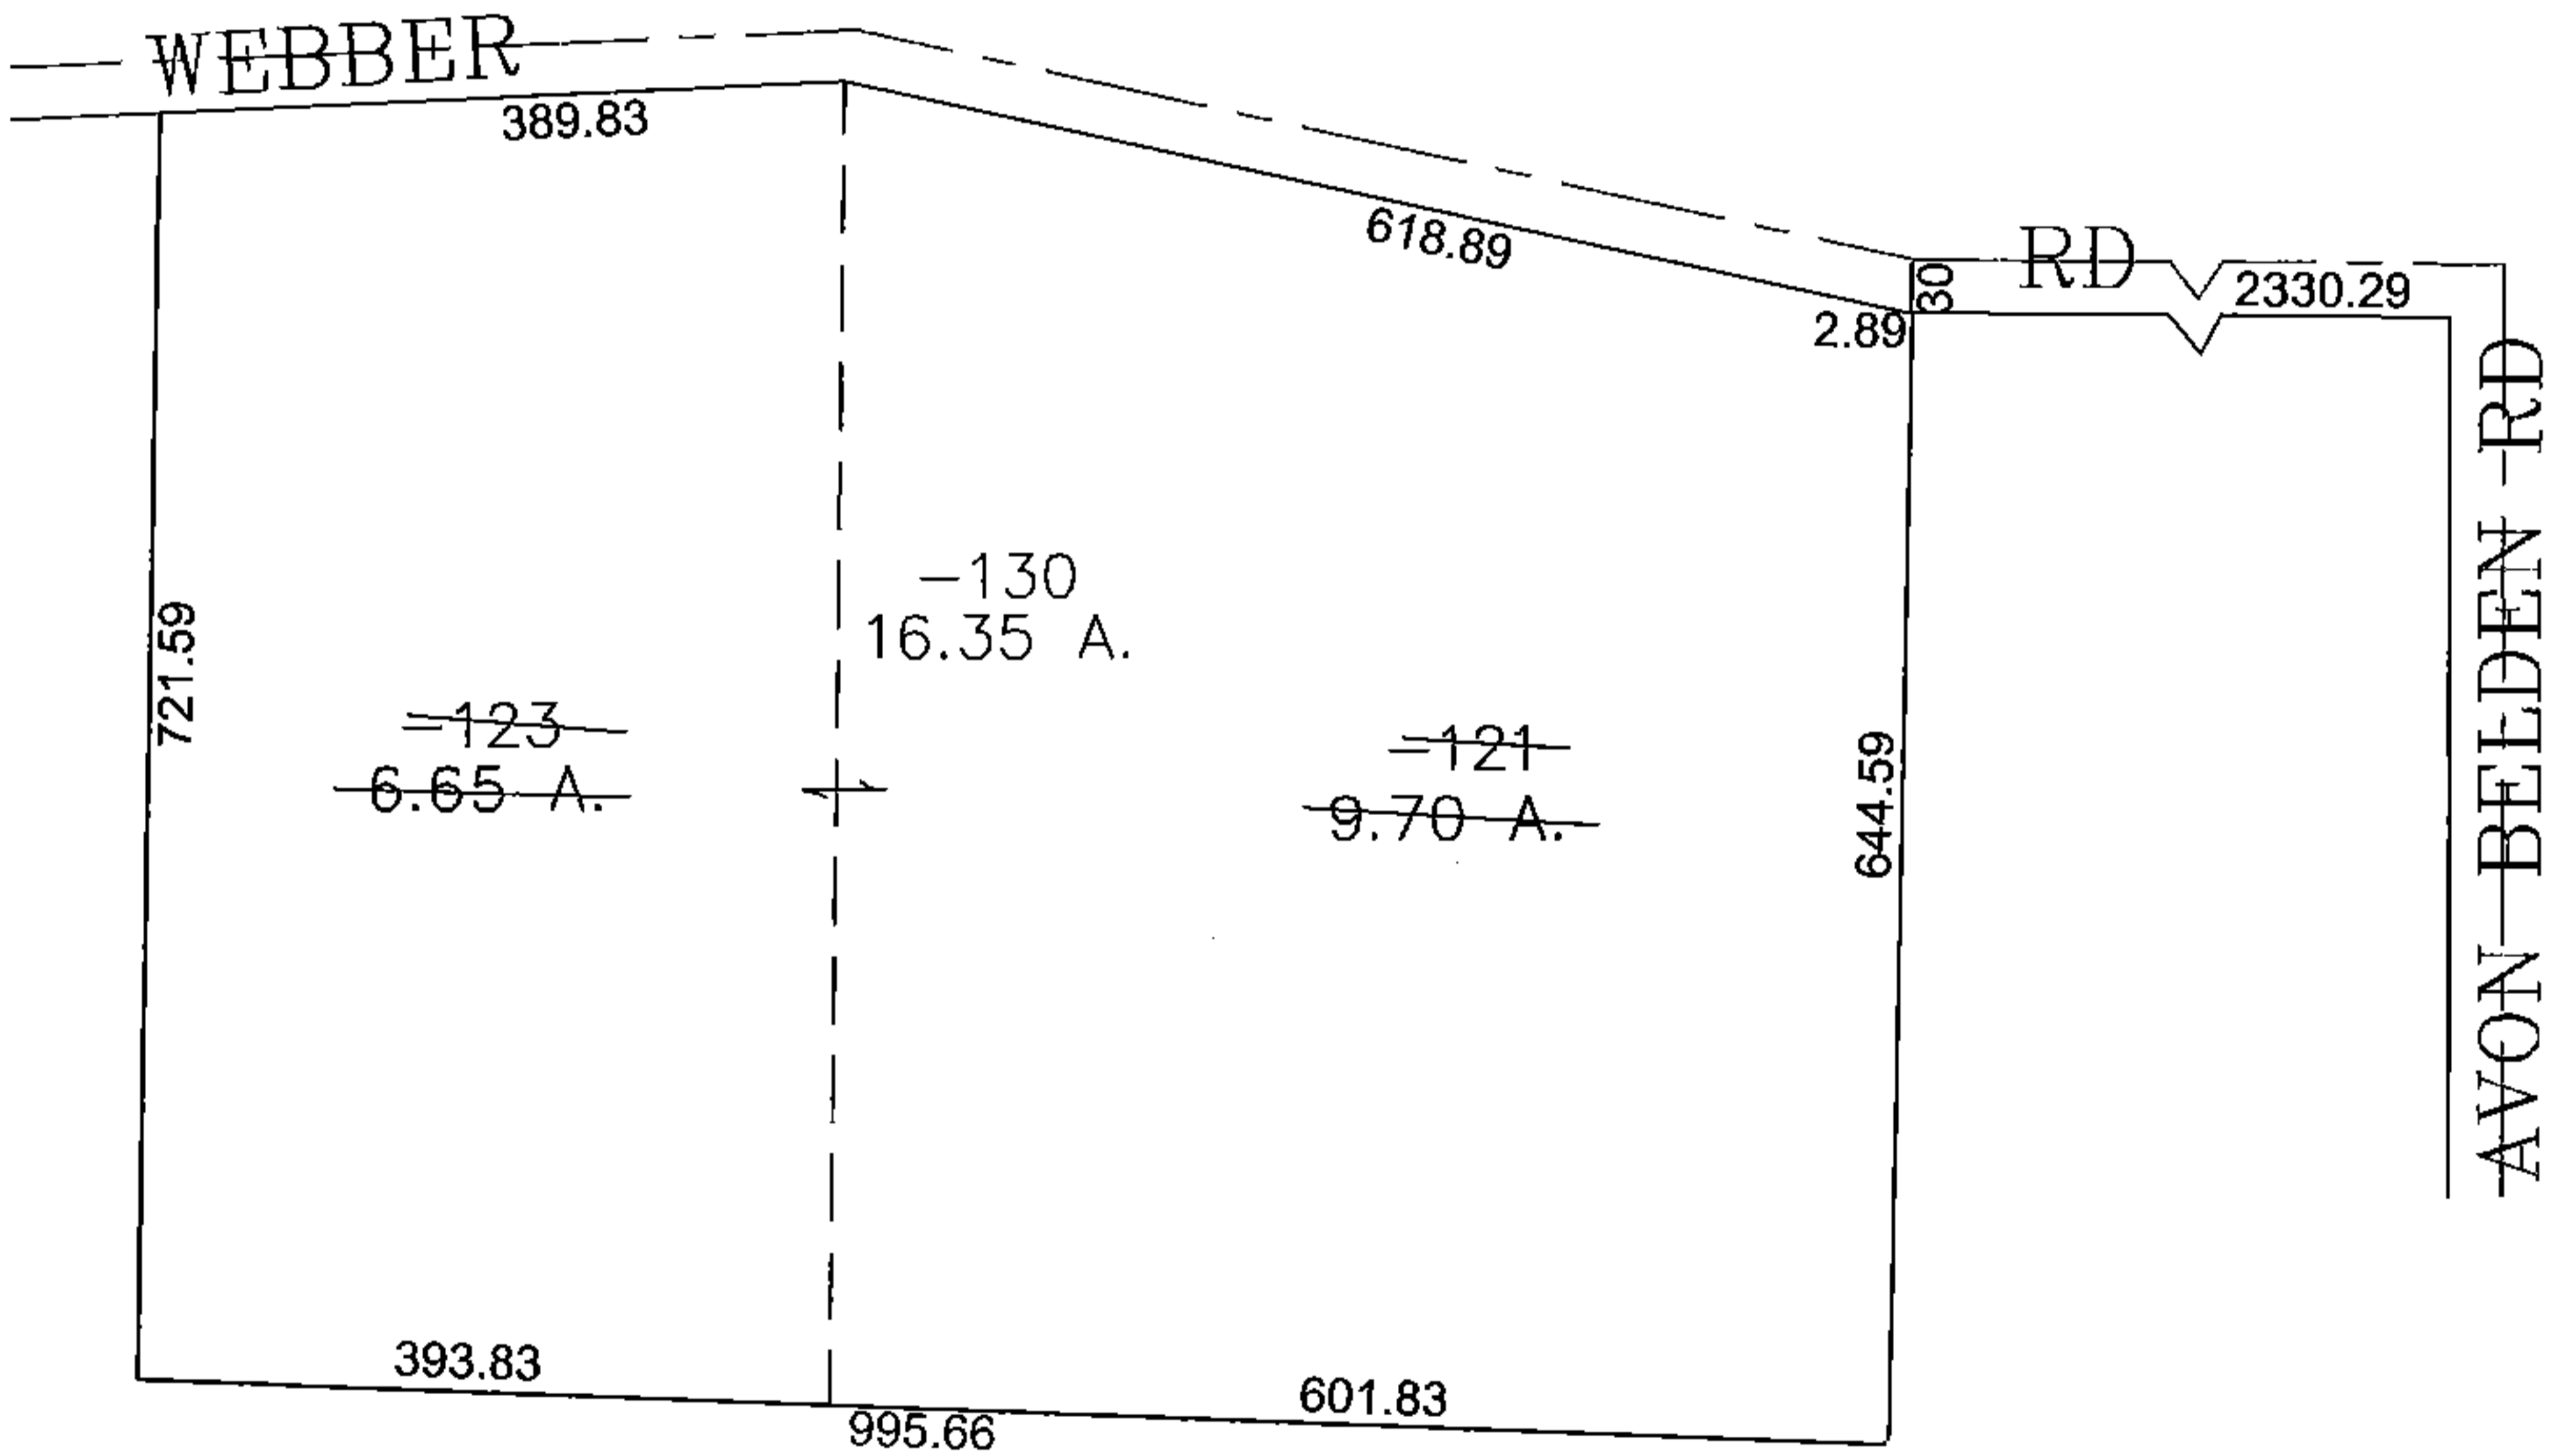


PARENT PARCEL: 04-00-008-104-123, -121

CHILD PARCEL: 04-00-008-104-130

STARTING POINT: CENTERLINE OF WEBBER RD & AVON BELDEN RD

14-03269

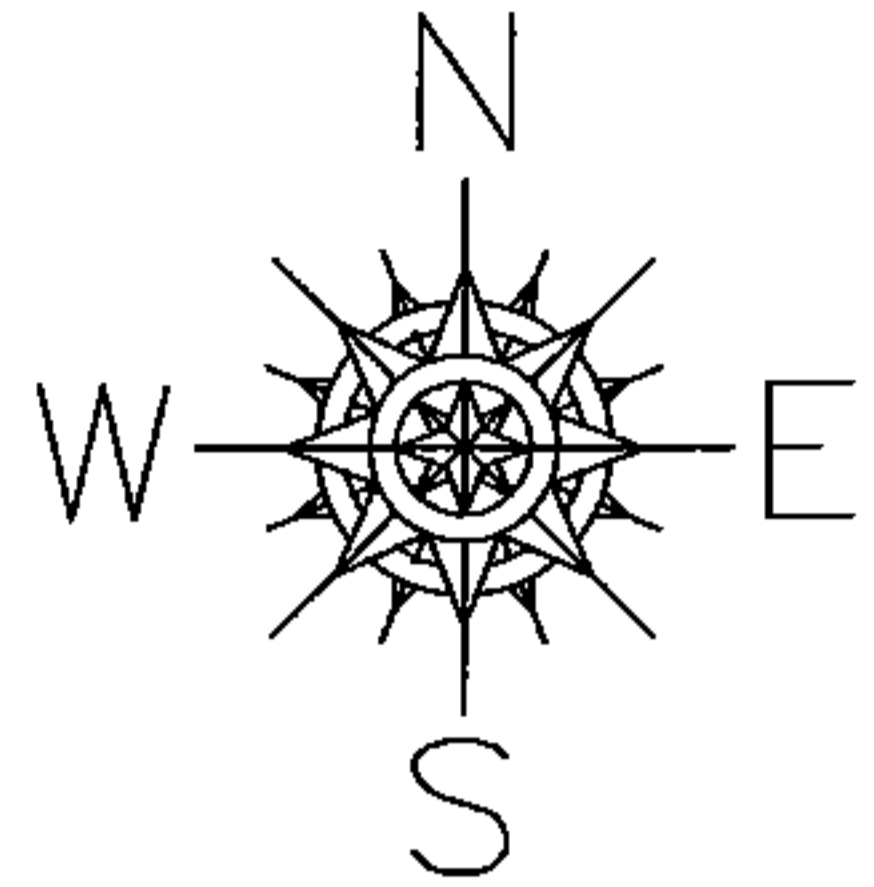

SPLITS/DEEDS PROCESSED
 LORAIN COUNTY TAX MAP DEPARTMENT
 226 MIDDLE AVE. ELYRIA, OHIO

SURVEYED BY: JAMES T SAYLER
 CLOSURE: 0.00 : 10.000
 MAP PAGE(S): 04-00-008-D
 APPROVED BY: JAH DATE: 7-31-2014
 SCALE: 1" = 200 PRIOR INSTRUMENT: 20140513336