
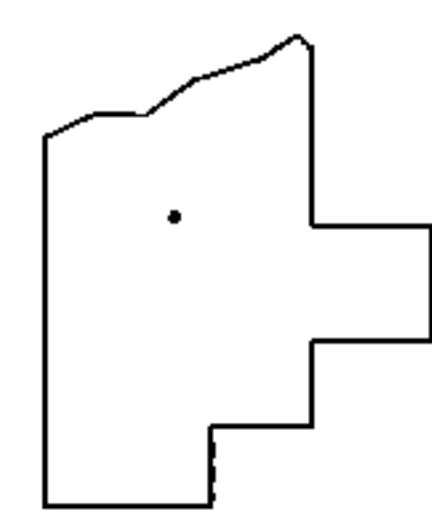


PARENT PARCEL: 02-01-006-110-019
 CHILD PARCEL: XX-XX-XXX-XXX-XXX
 STARTING POINT: WEST HALF OF S/L 197 IN ORIGINAL PLAT OF LORAIN VOL. J PG. 446

15-03270-C

FRONTAGE CORRECTION

02-01-006-110-019
~~30.50 X 157~~
 30.85 X 157.00
 CORR. PER DV 214/133

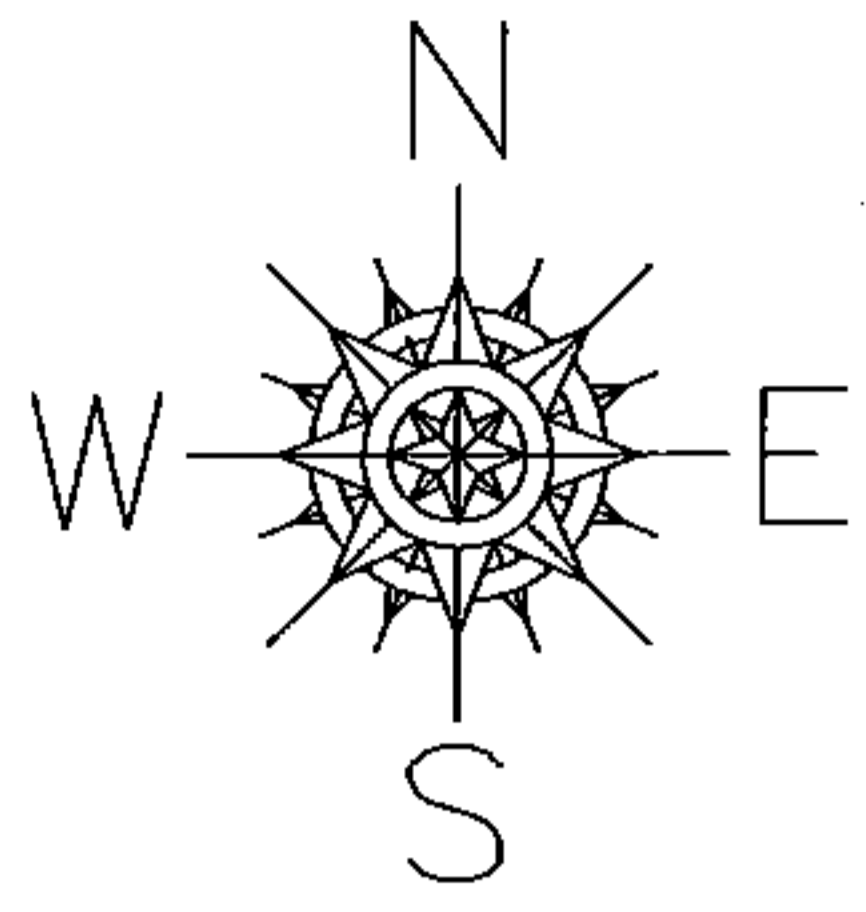

SPLITS/DEEDS PROCESSED
 LORAIN COUNTY TAX MAP DEPARTMENT
 226 MIDDLE AVE. ELYRIA, OHIO

SURVEYED BY: NA
 CLOSURE: NA
 MAP PAGE(S): 02-01-006
 APPROVED BY: TJS DATE: 8/5/15
 SCALE: 1"= 50' PRIOR INST.: DV 214/133