
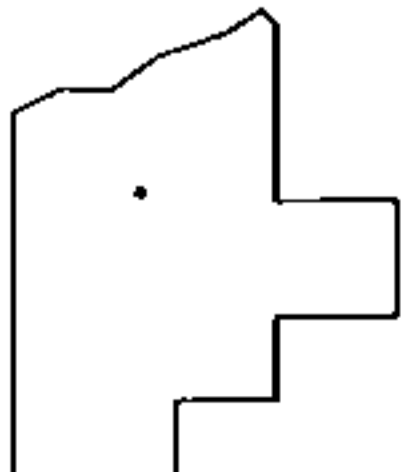


PARENT PARCEL: 04-00-003-103-043  
 CHILD PARCEL: 04-00-003-103-066 & -067  
 STARTING POINT: INT. SOUTH R.O.W. OF FRENCH CREEK RD. & CL OF NORTH LONG RD.

14-03270

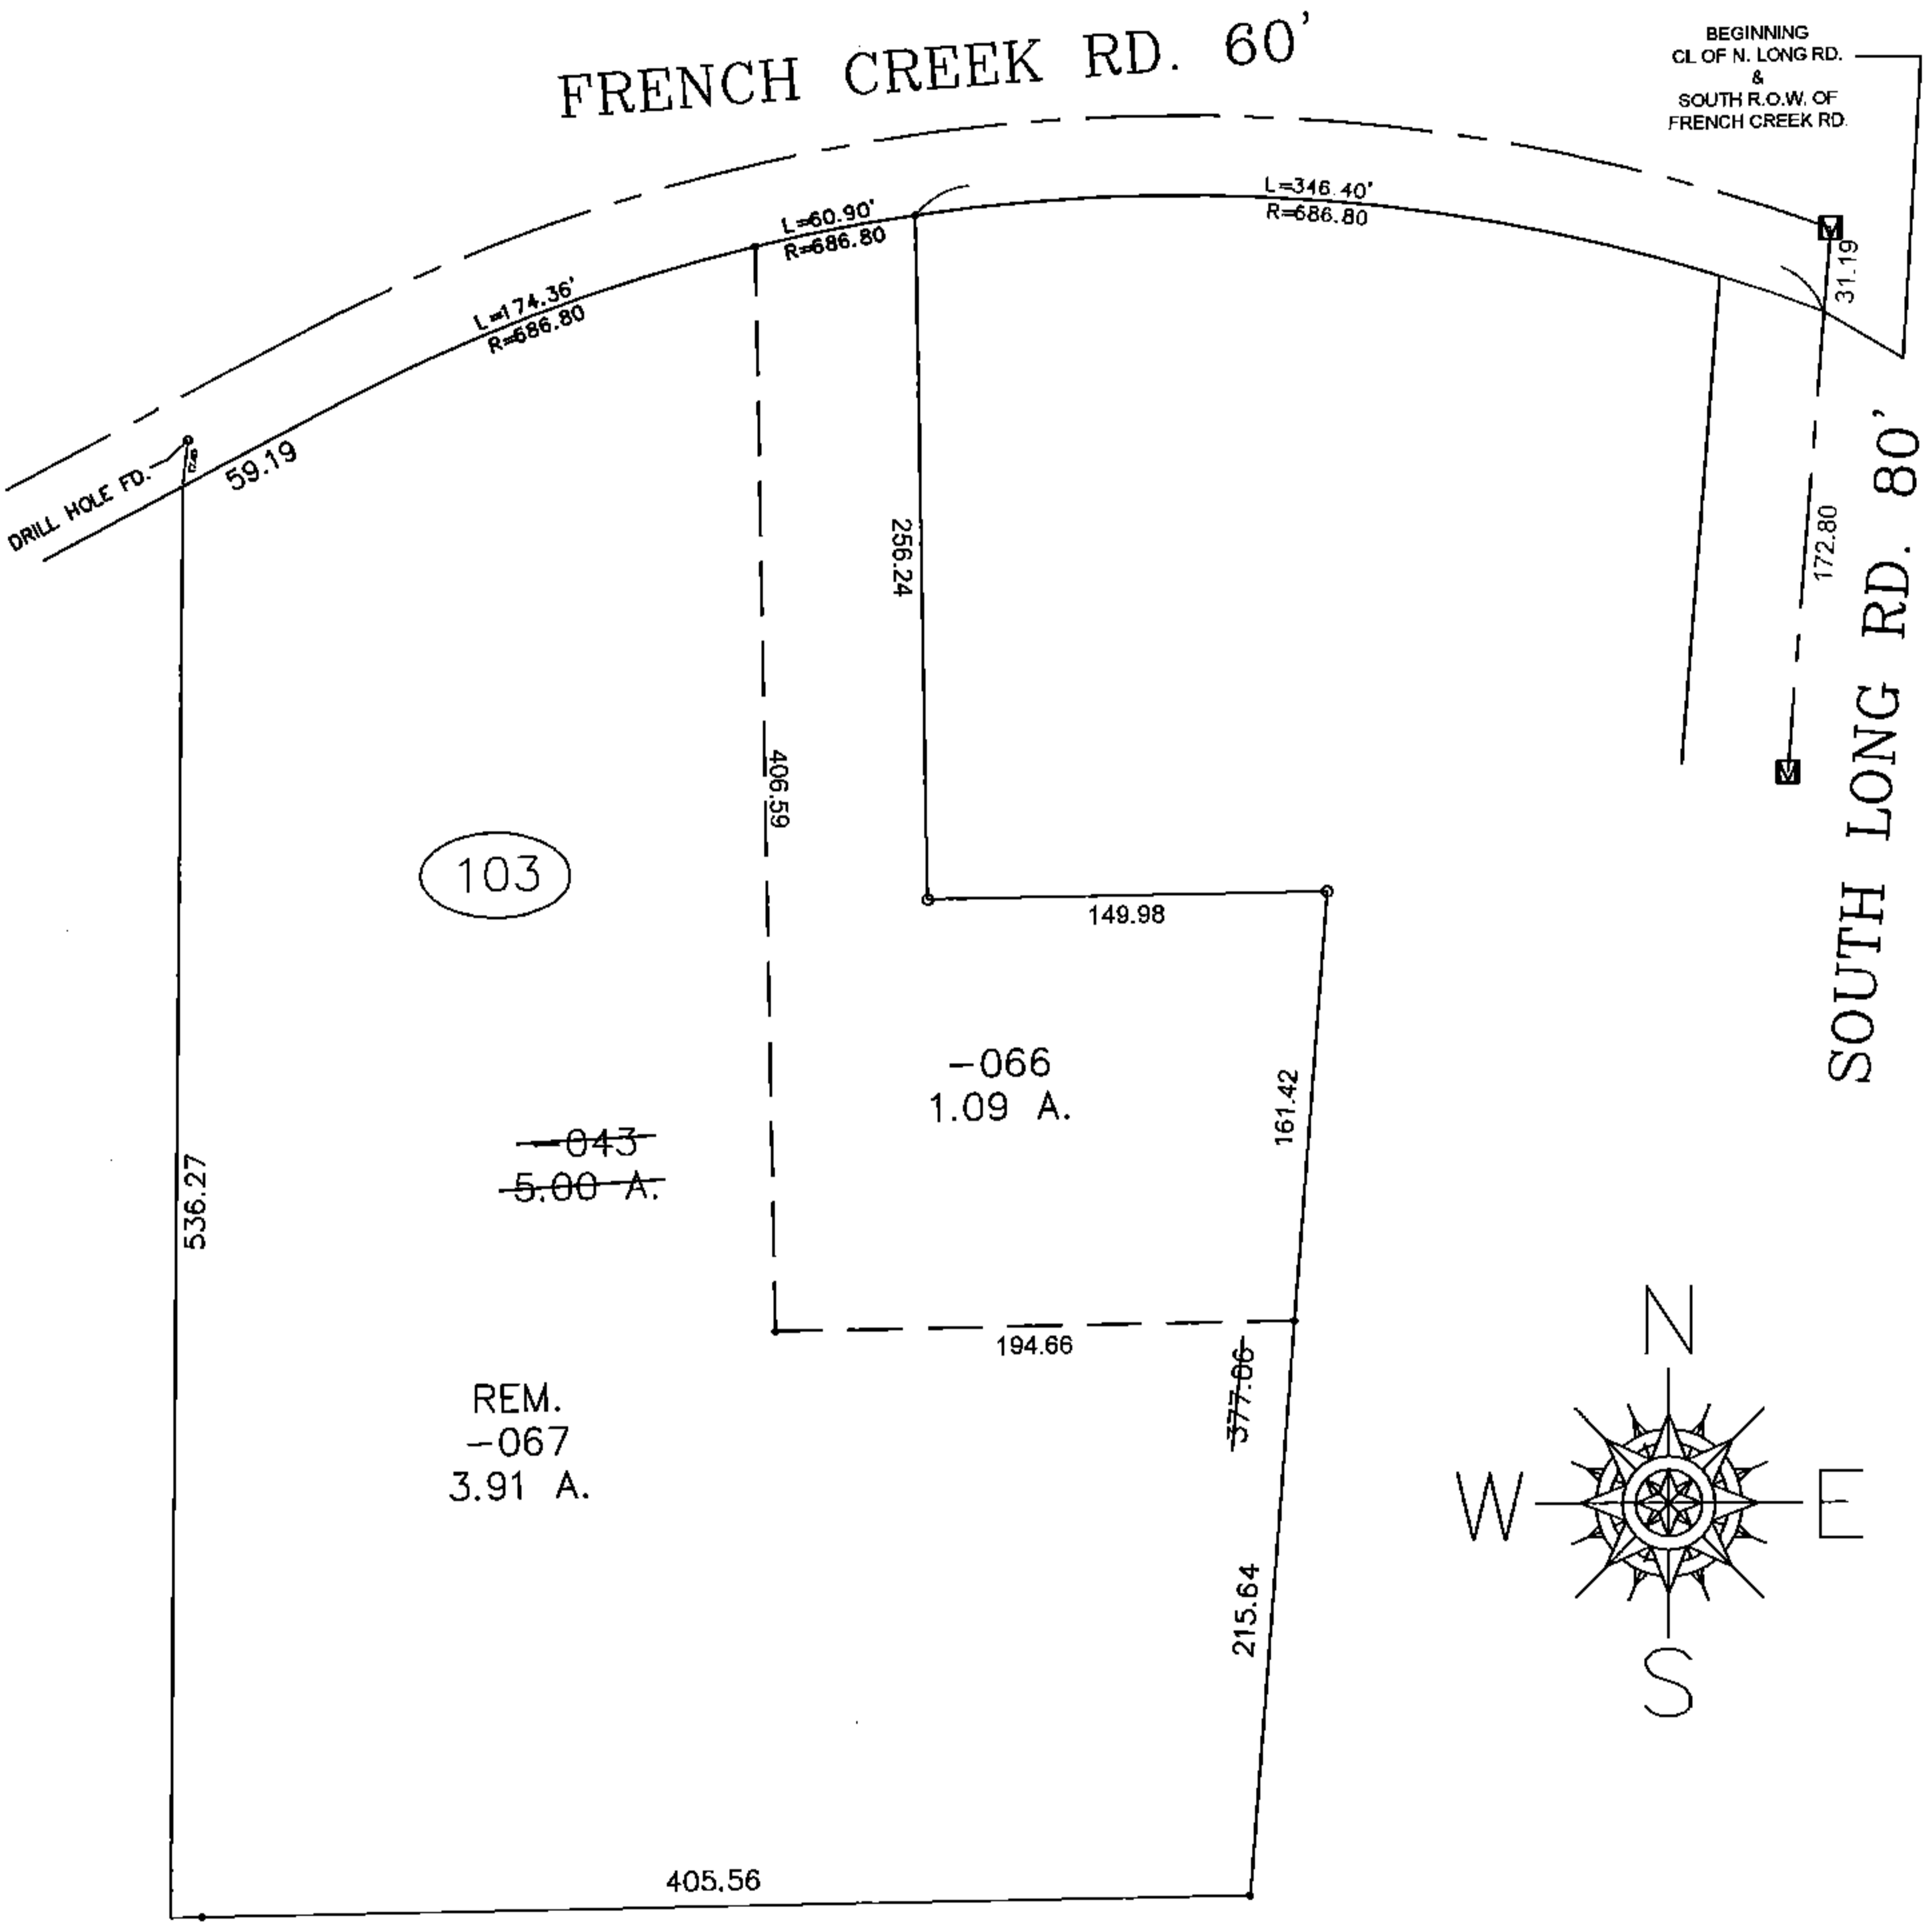

**SPLITS/DEEDS PROCESSED**  
 LORAIN COUNTY TAX MAP DEPARTMENT  
 226 MIDDLE AVE. ELYRIA, OHIO

SURVEYED BY: DALE R. HAYWOOD  
 CLOSURE: 0.01 : 10,000  
 MAP PAGE(S): 04-00-003  
 APPROVED BY: TJS DATE: 8/1/14  
 SCALE: 1" = 100' PRIOR INSTRUMENT: 20060147859