
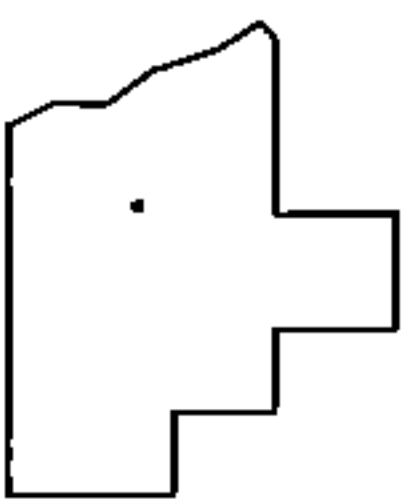
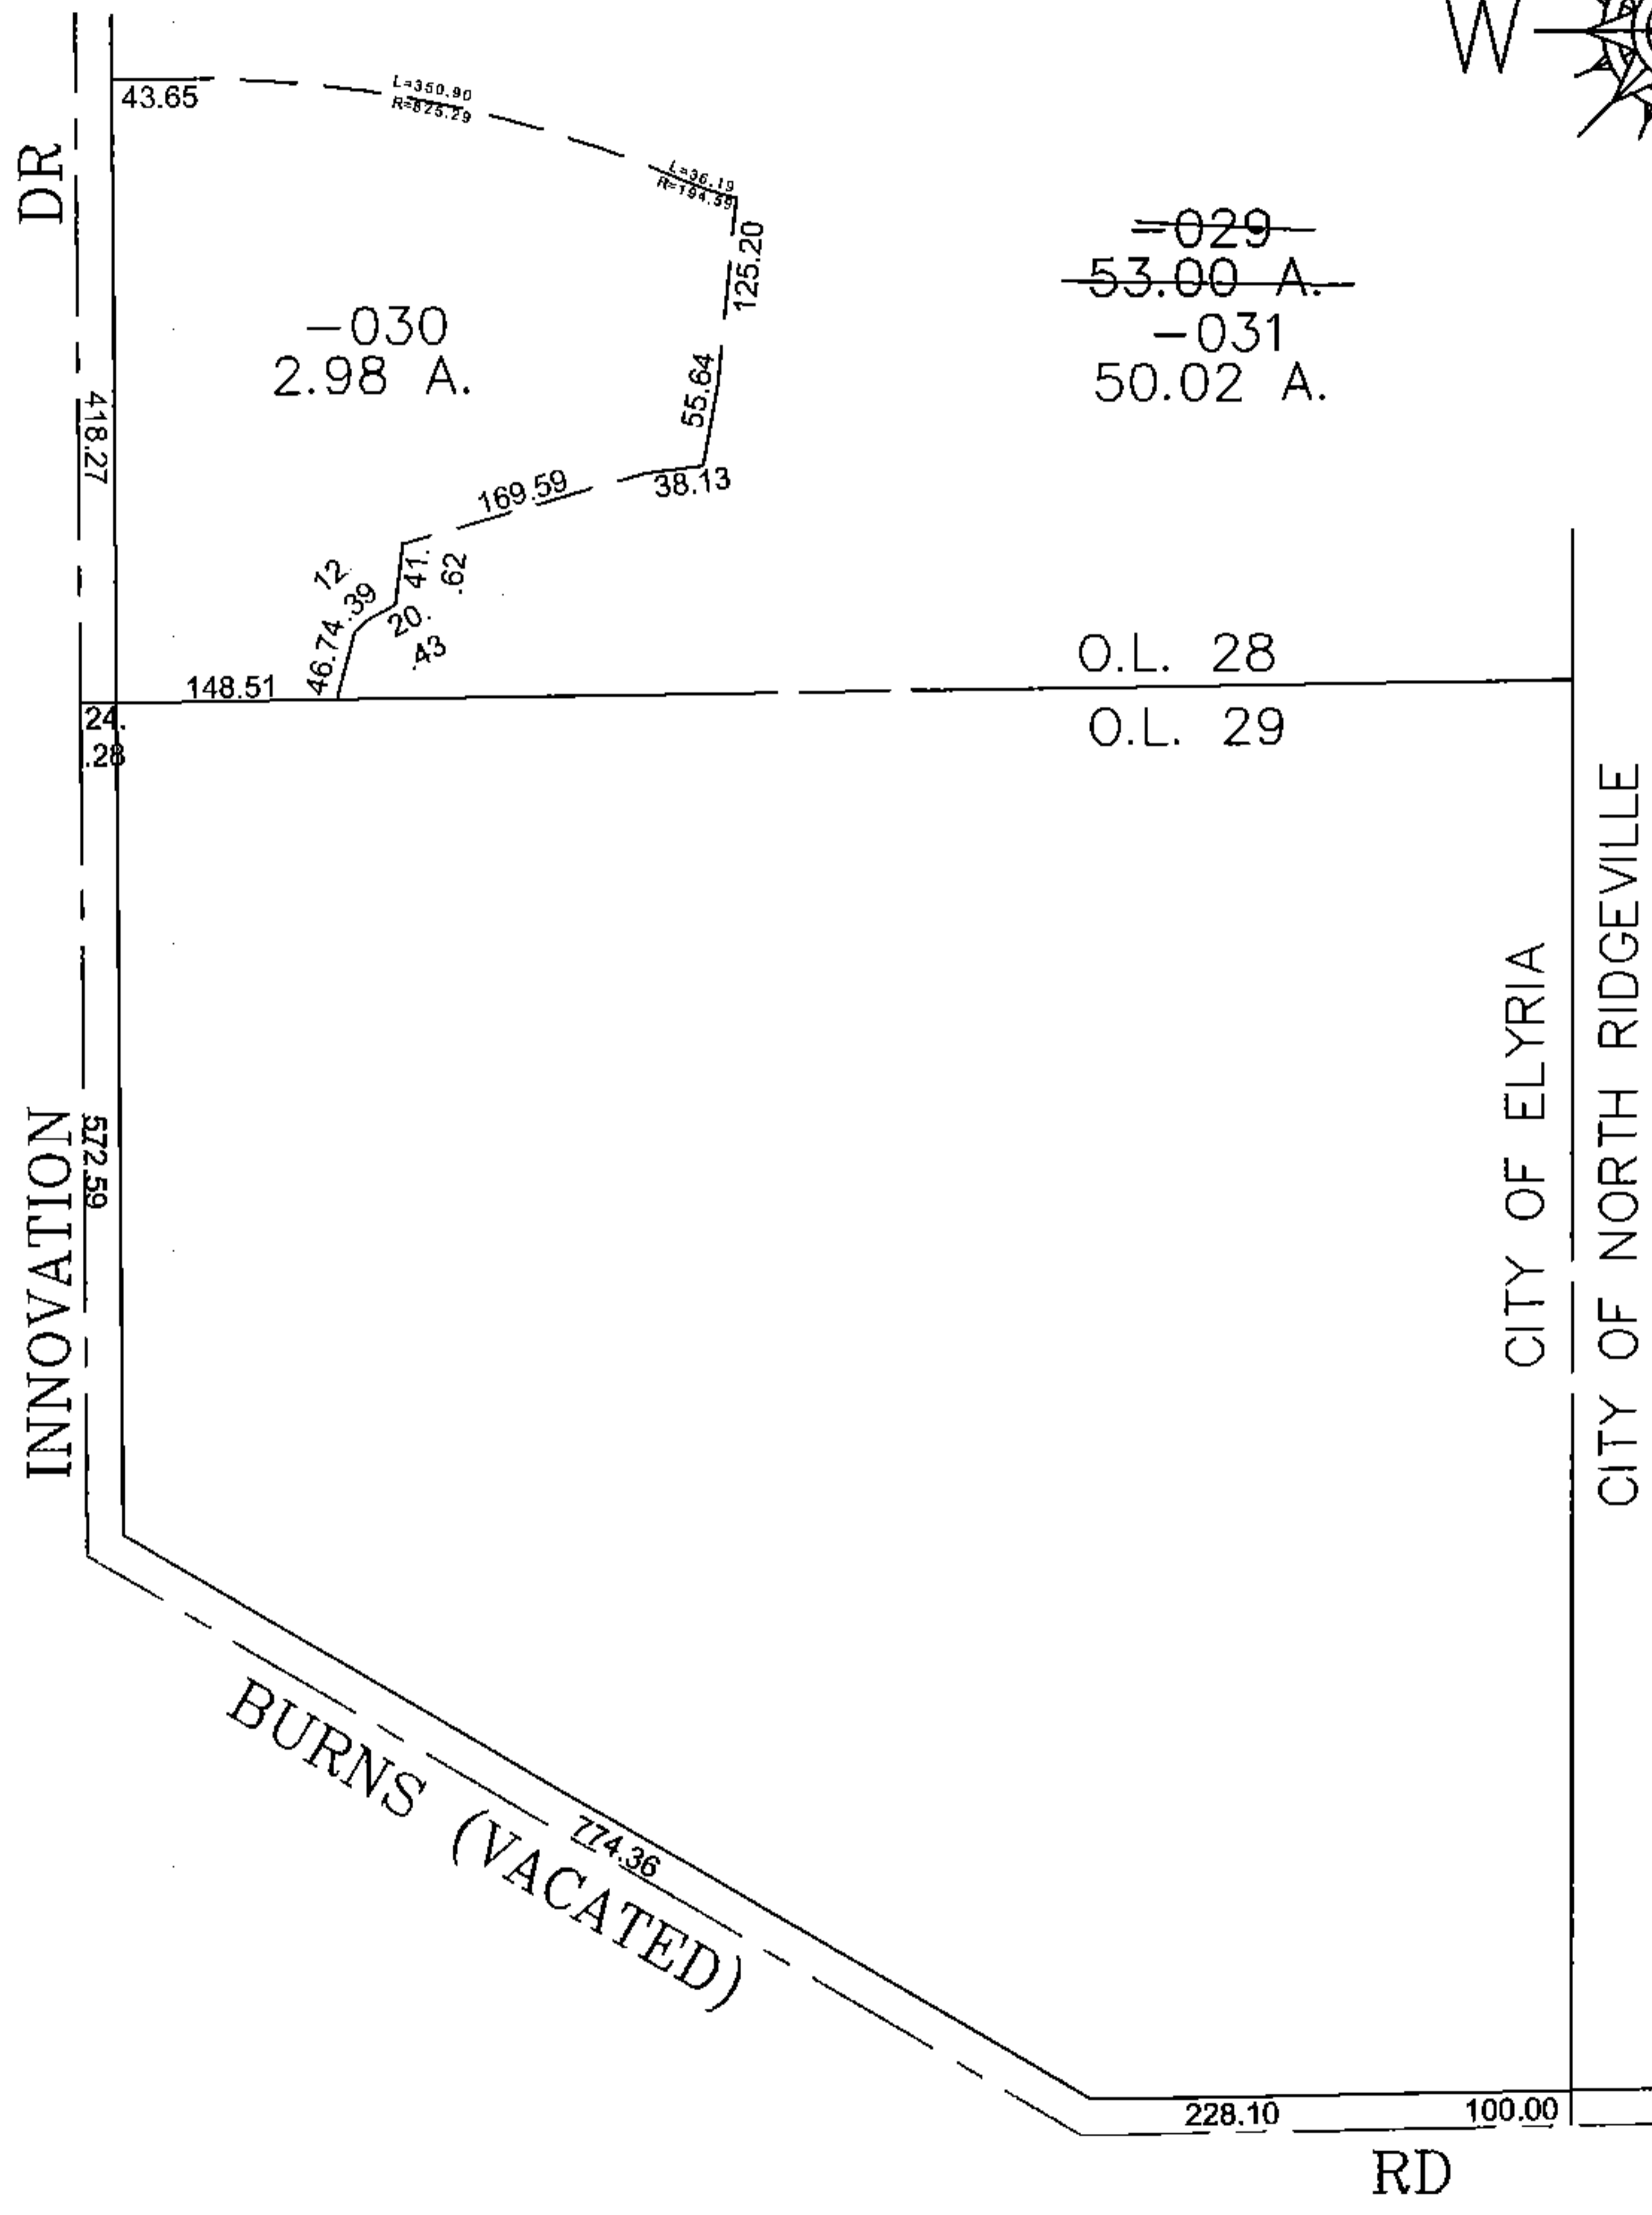


PARENT PARCEL: 06-23-028-000-029

CHILD PARCEL: 06-23-028-000-030, -031

STARTING POINT: CENTERLINE OF BURNS RD & O.L. 29 CITY OF ELYRIA

14-03272

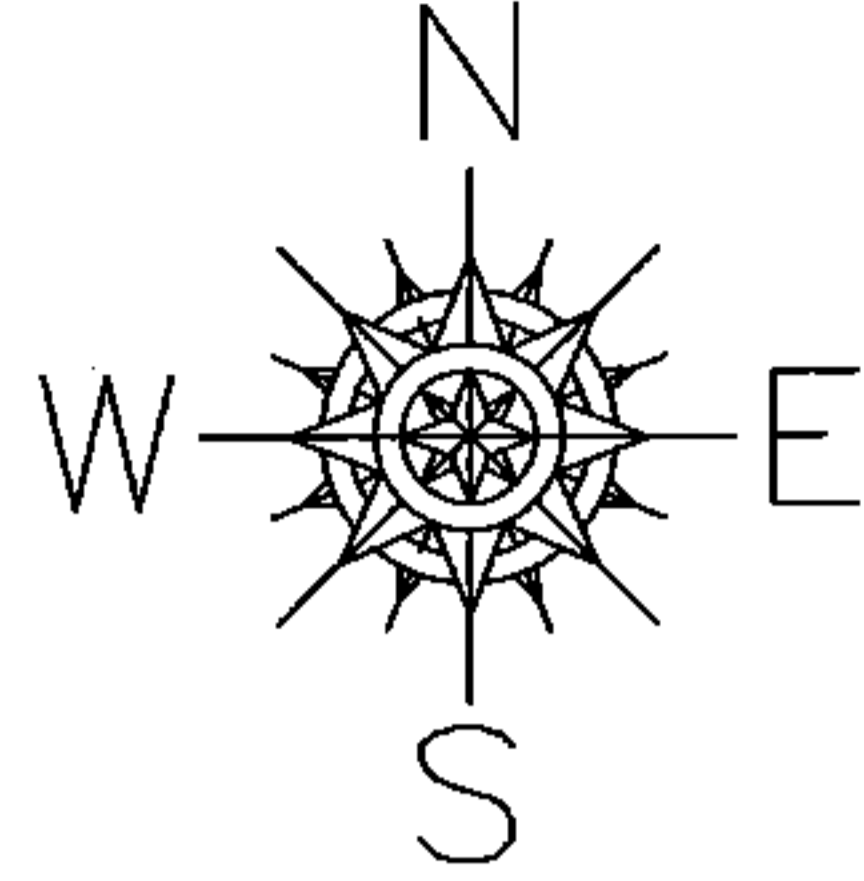

SPLITS/DEEDS PROCESSED
 LORAIN COUNTY TAX MAP DEPARTMENT
 226 MIDDLE AVE. ELYRIA, OHIO

SURVEYED BY: TREVOR BIXLER
 CLOSURE: 0.00 ; 10.000
 MAP PAGE(S): 6-35
 APPROVED BY: JAH DATE: 8-6-2014
 SCALE: 1" = 200 PRIOR INSTRUMENT: DV 886/258