
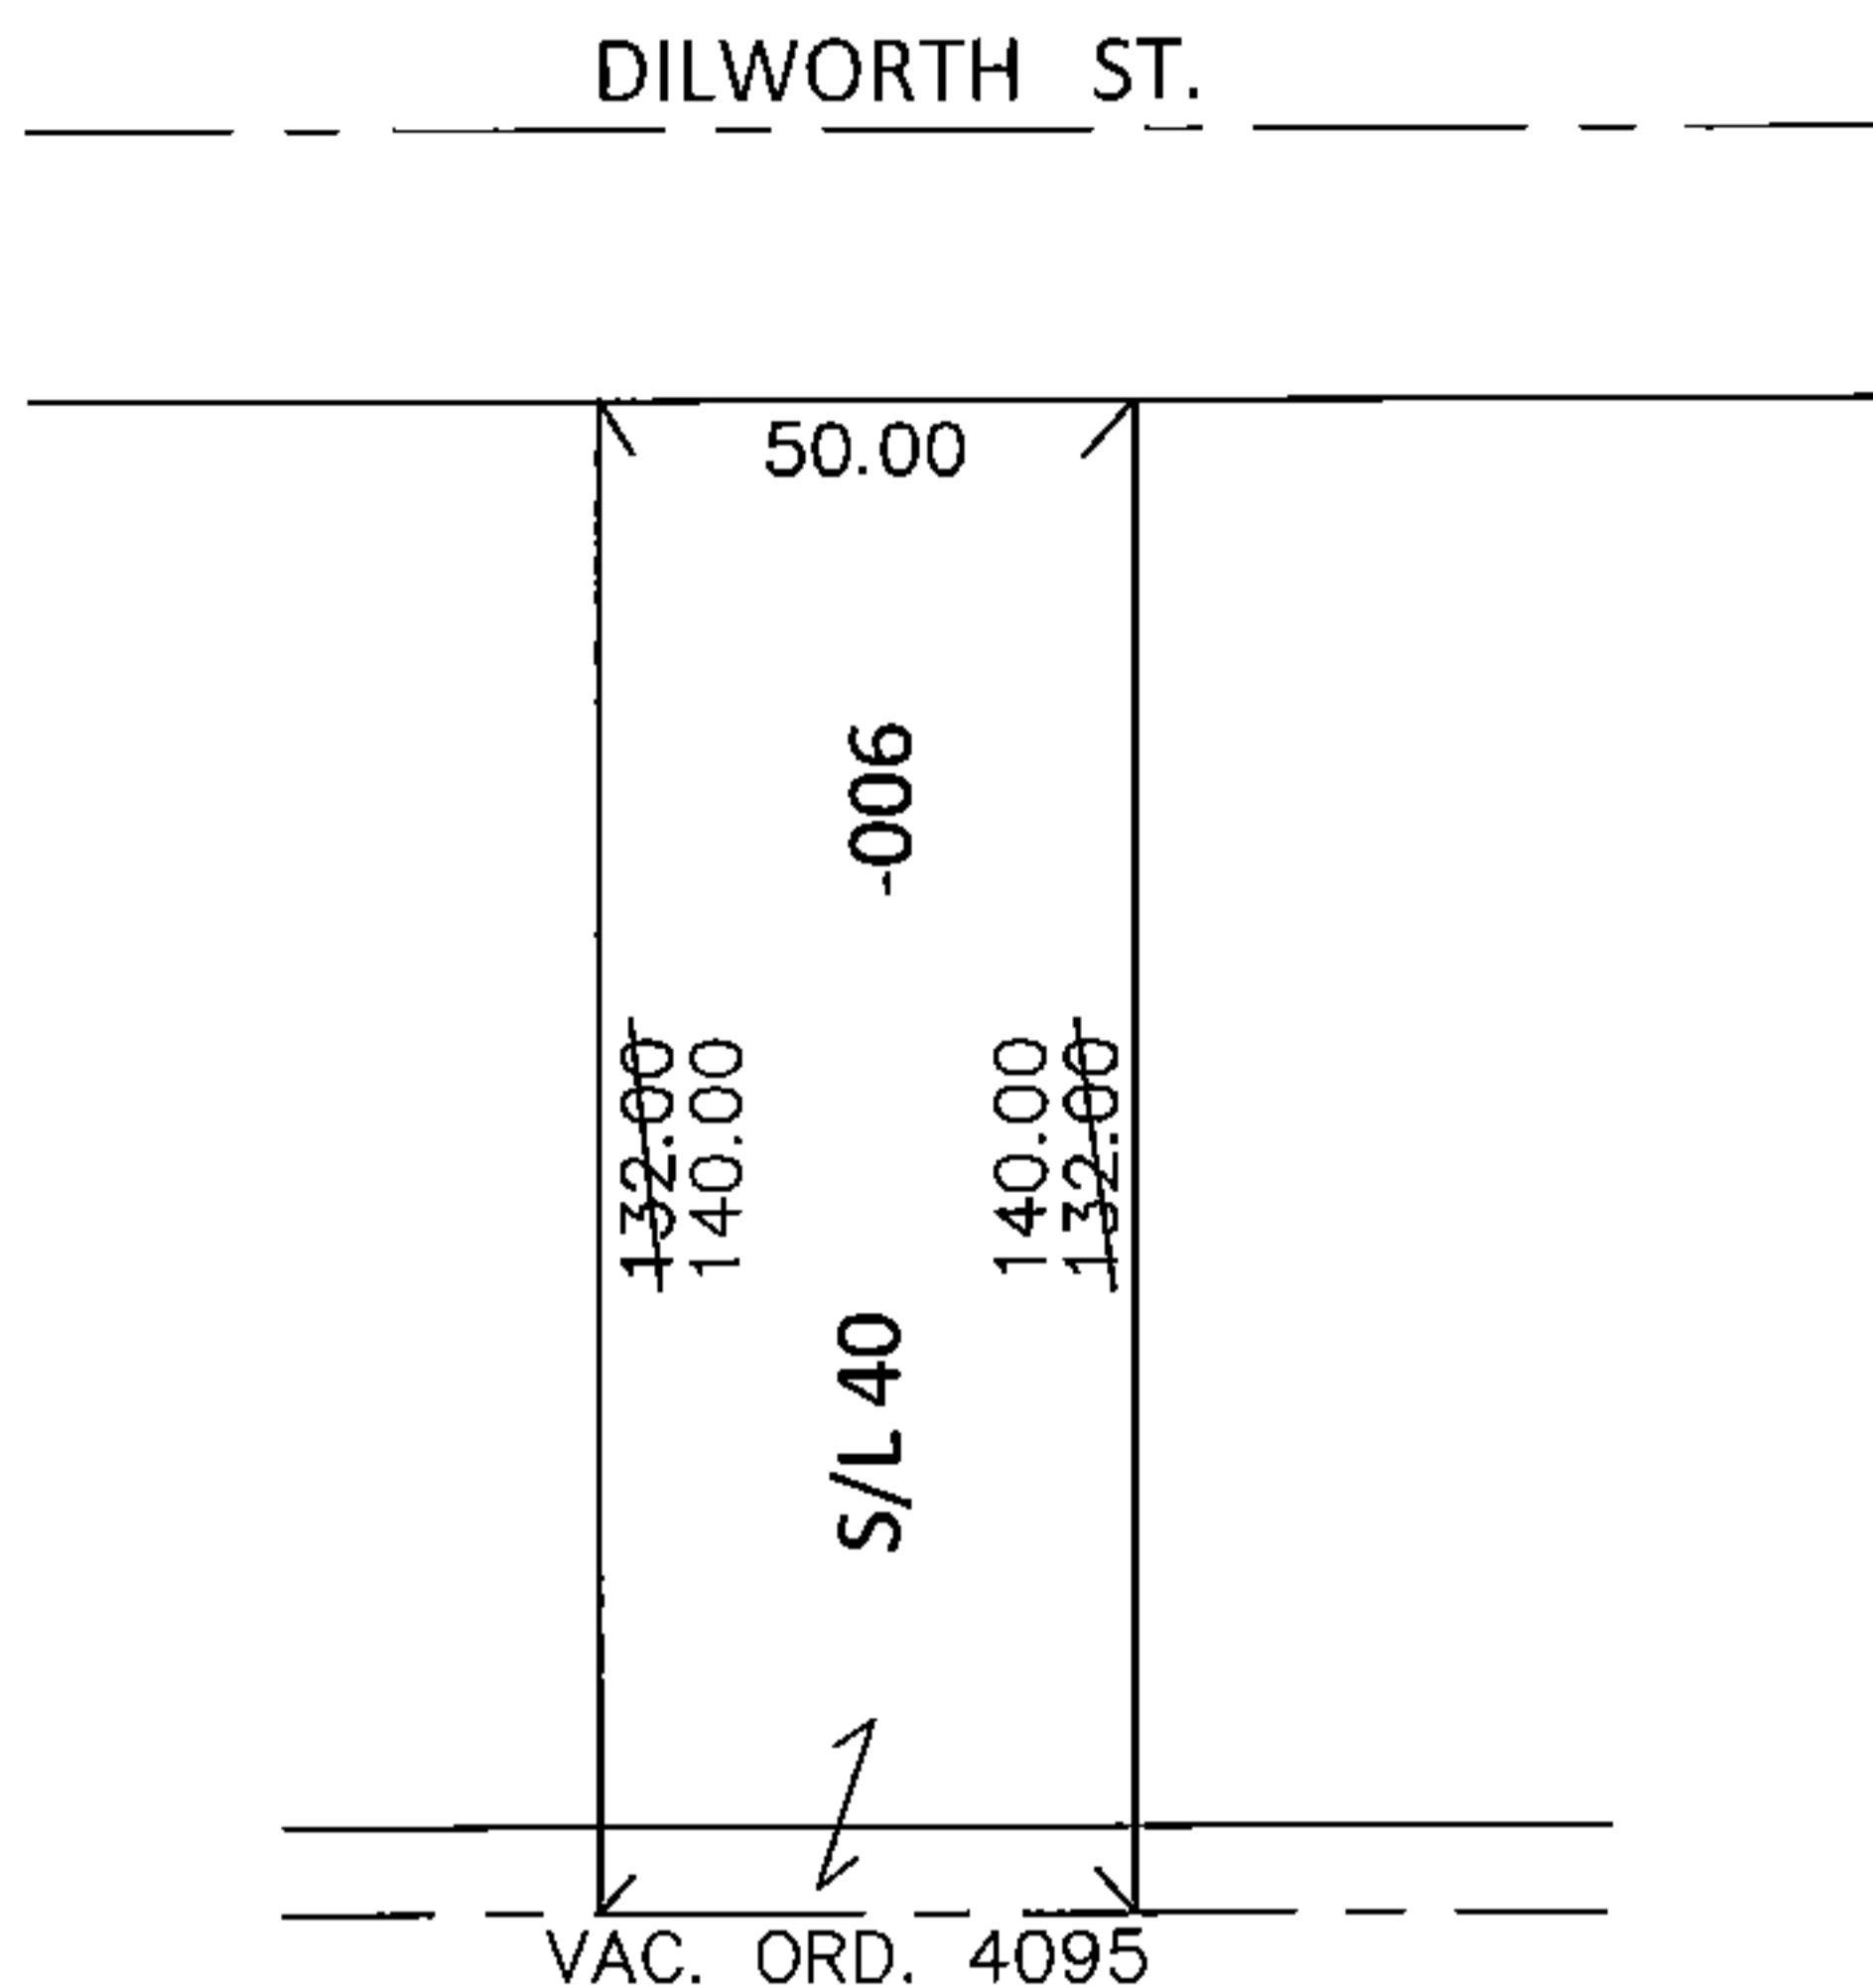


PARENT PARCEL: 06-25-037-103-006

CHILD PARCEL: _____

STARTING POINT: S/L 40 IN DILWORTH'S EAST (VOL.6 PG.32)

15-03274-C

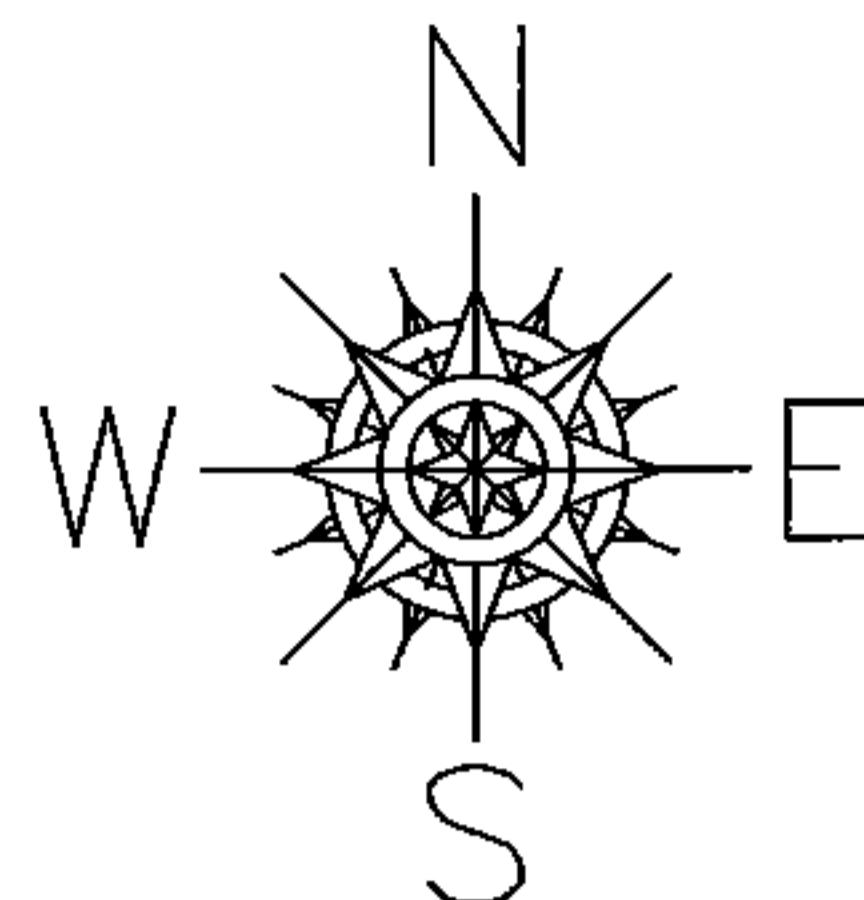


DEPTH CORRECTION

06-25-037-103-006

140

50 X ~~132~~

CORR. PER. DEED & ORD. 4095

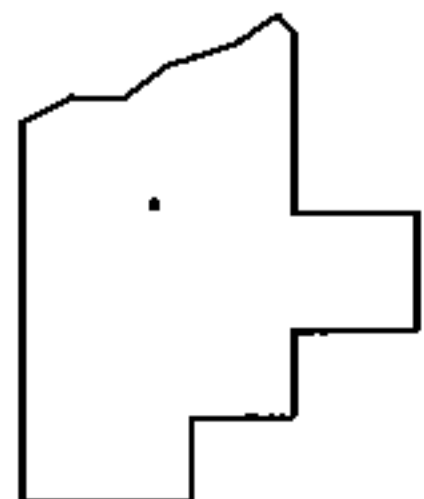

SPLITS/DEEDS PROCESSED

LORAIN COUNTY TAX MAP DEPARTMENT
226 MIDDLE AVE. ELYRIA, OHIO

SURVEYED BY: N/A

CLOSURE: N/A

MAP PAGE(S): 6-86

APPROVED BY: RRM DATE: 8-10-15

SCALE: 1"= 50' PRIOR INST.: 20150553677