


PARENT PARCEL: 04-00-023-101-050 & -051


CHILD PARCEL: 04-00-023-101-052 THRU -056

STARTING POINT: CL OF EMORY DR. & CL OF JAYCOX RD.

14-03274

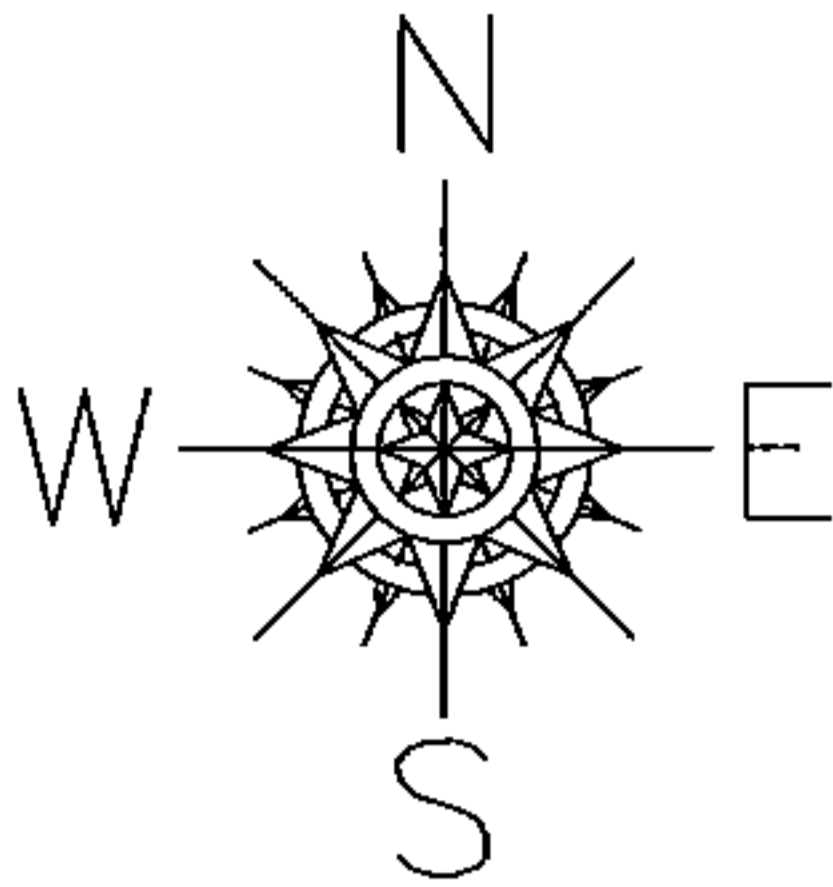

DETROIT RD. (S.R. 254" 66')

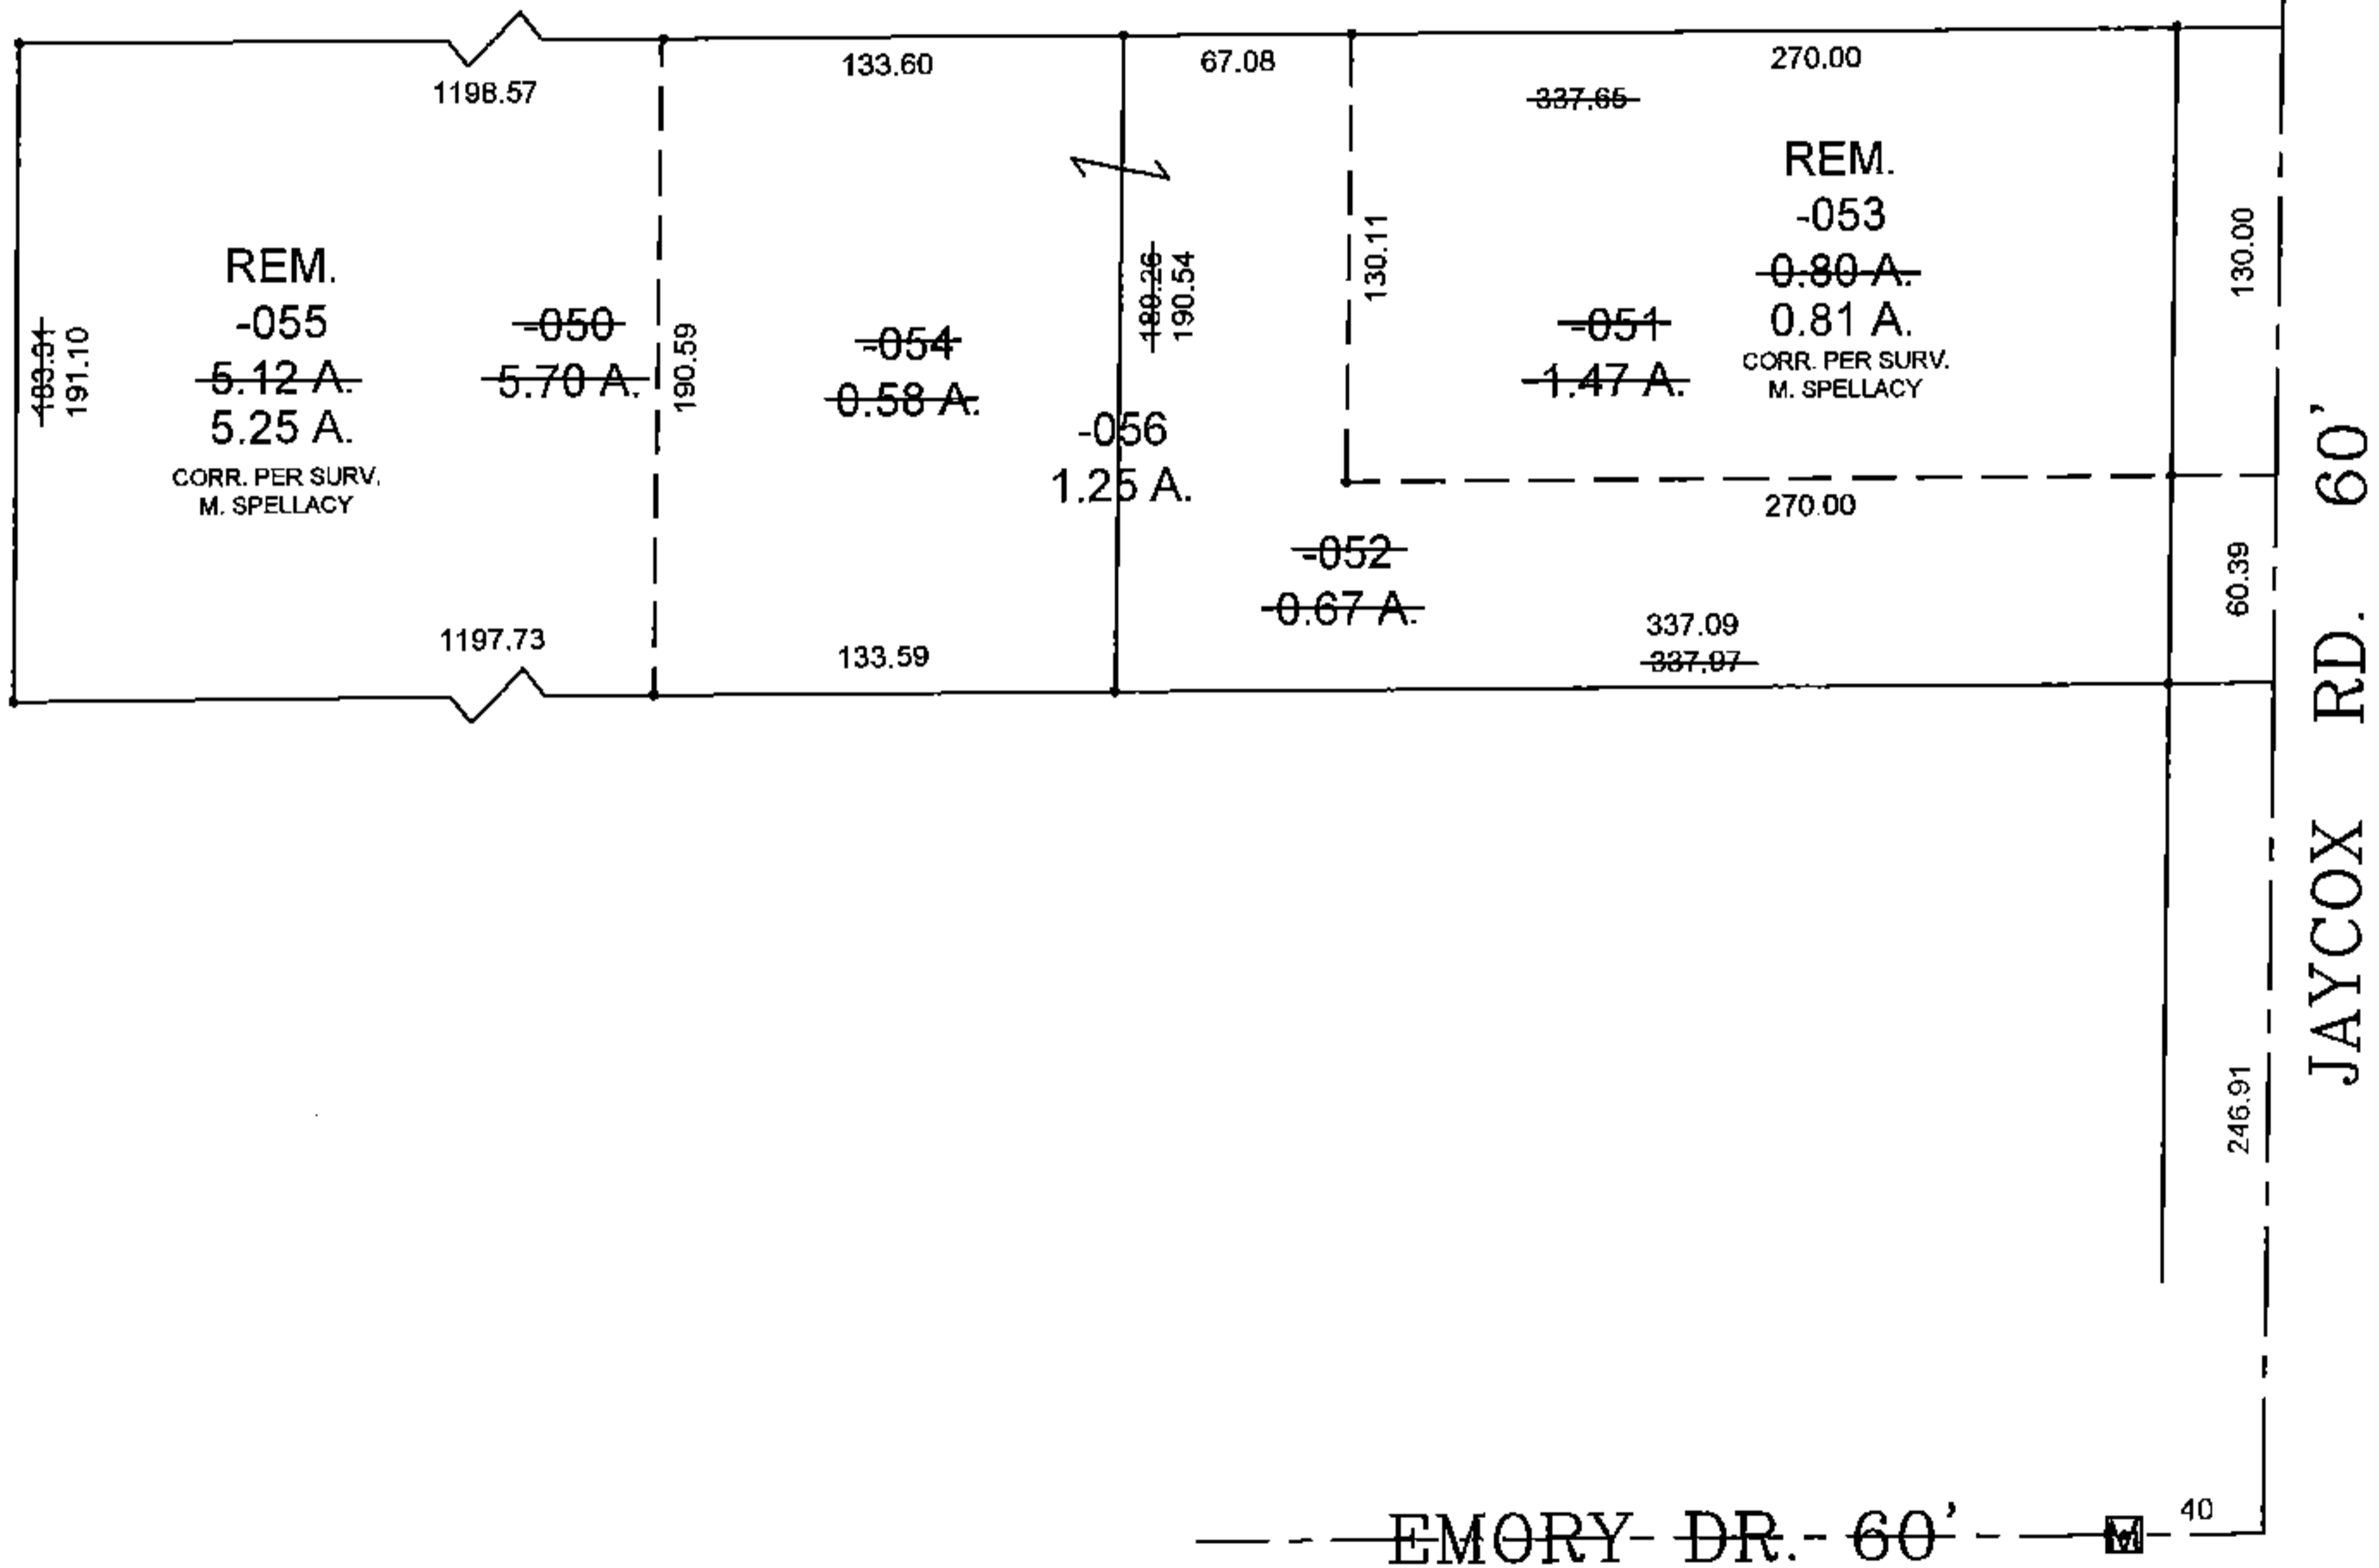

PRIOR INSTRUMENT: 20130488532

PRIOR INSTRUMENT: 20080276715

SPLITS/DEEDS PROCESSED

LORAIN COUNTY TAX MAP DEPARTMENT  
226 MIDDLE AVE. ELYRIA, OHIO

SURVEYED BY: MICHAEL P. SPELLACY

CLOSURE: 0.01 : 10,000

MAP PAGE(S): 04-00-023-A & B

APPROVED BY: TJS DATE: 8/13/14

SCALE: 1" = 100'