


PARENT PARCEL: 01-00-029-000-032



CHILD PARCEL: _____

STARTING POINT: SOUTHWEST CORNER OF LAND CONVEYED TO FRANK & HELENA NORTHHEIM (DV 104/57)

15-03275-A

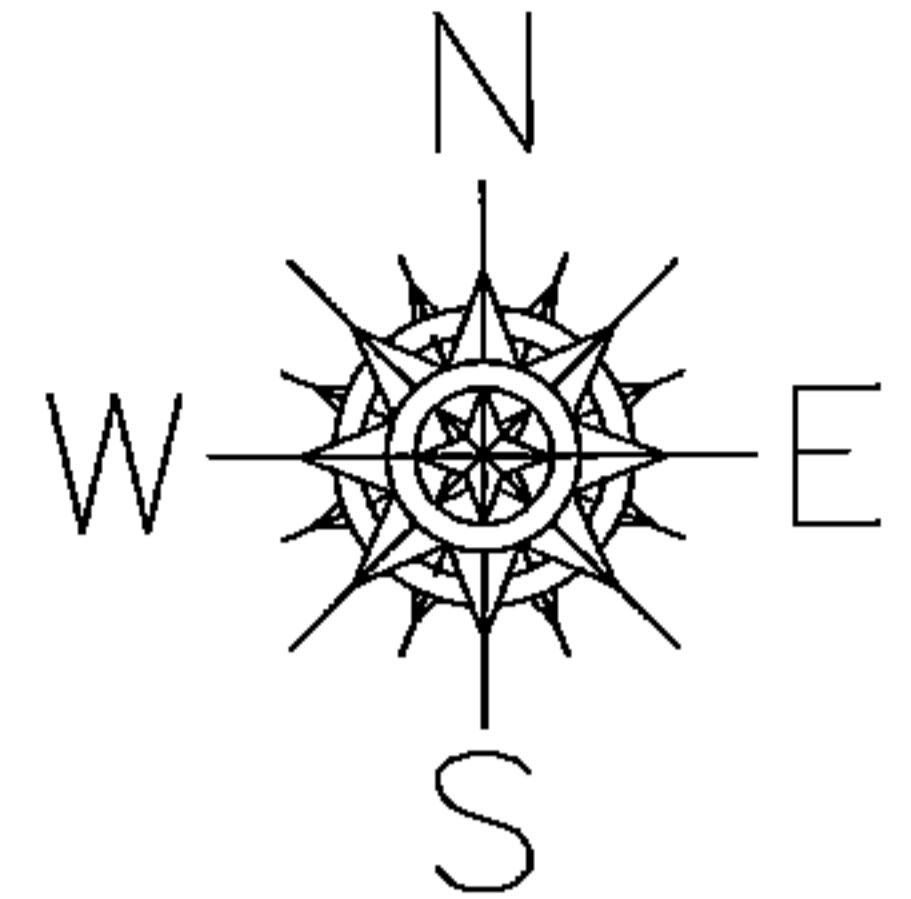

ROUTE 2

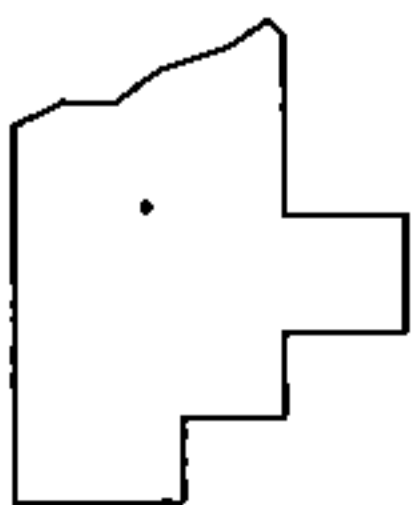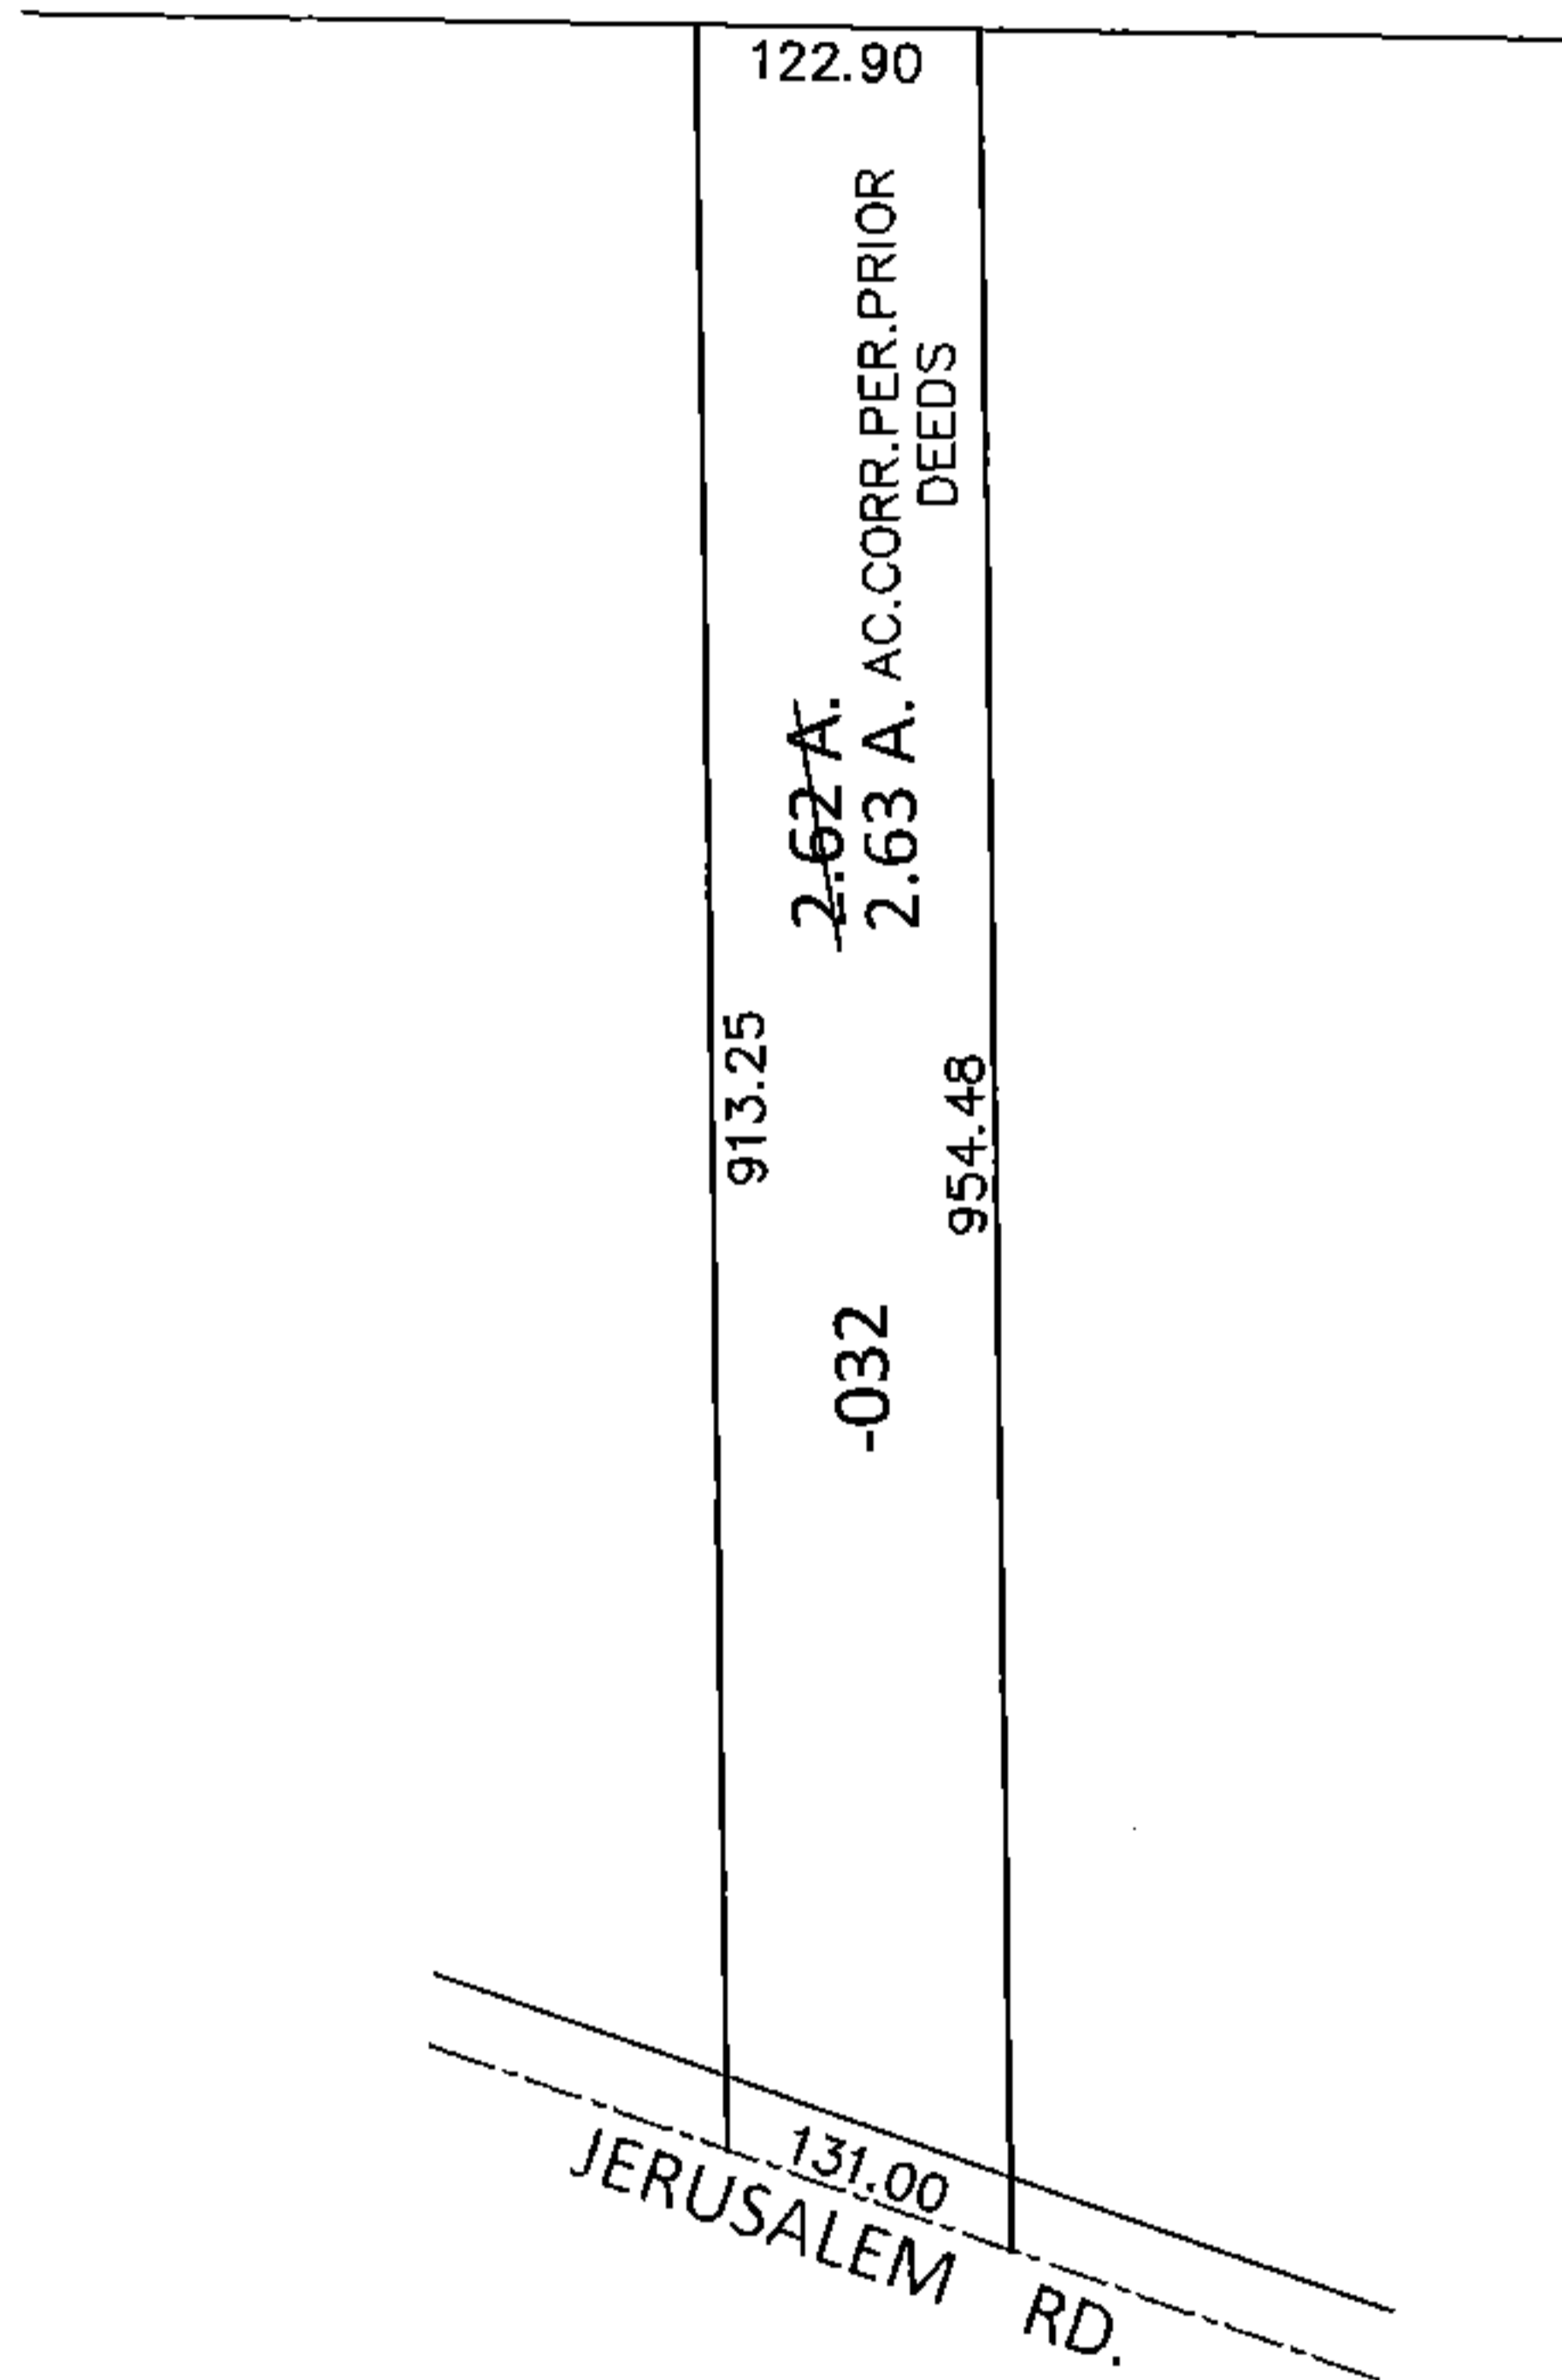

SPLITS/DEEDS PROCESSED

LORAIN COUNTY TAX MAP DEPARTMENT
226 MIDDLE AVE. ELYRIA, OHIO

SURVEYED BY: N/A

CLOSURE: .01:10,000

MAP PAGE(S): 1-00-029-B

APPROVED BY: RRM DATE: 8-10-15

SCALE: 1" = 200 PRIOR INST.: 20150543137