



PARENT PARCEL: \*\*SEE BELOW

CHILD PARCEL: \*SEE BELOW


STARTING POINT: CENTERLINE OF MILAN-ELYRIA RD & BECHTEL RD

14-03275

- \*\*05-00-068-000-012
- 05-00-073-000-025
- 05-00-073-000-016
- 05-00-067-000-003
- 05-00-074-000-001
- 05-00-075-000-006, -005
- 05-00-075-000-011
- 05-00-073-000-037
- 05-00-073-000-038
- 05-00-073-000-039

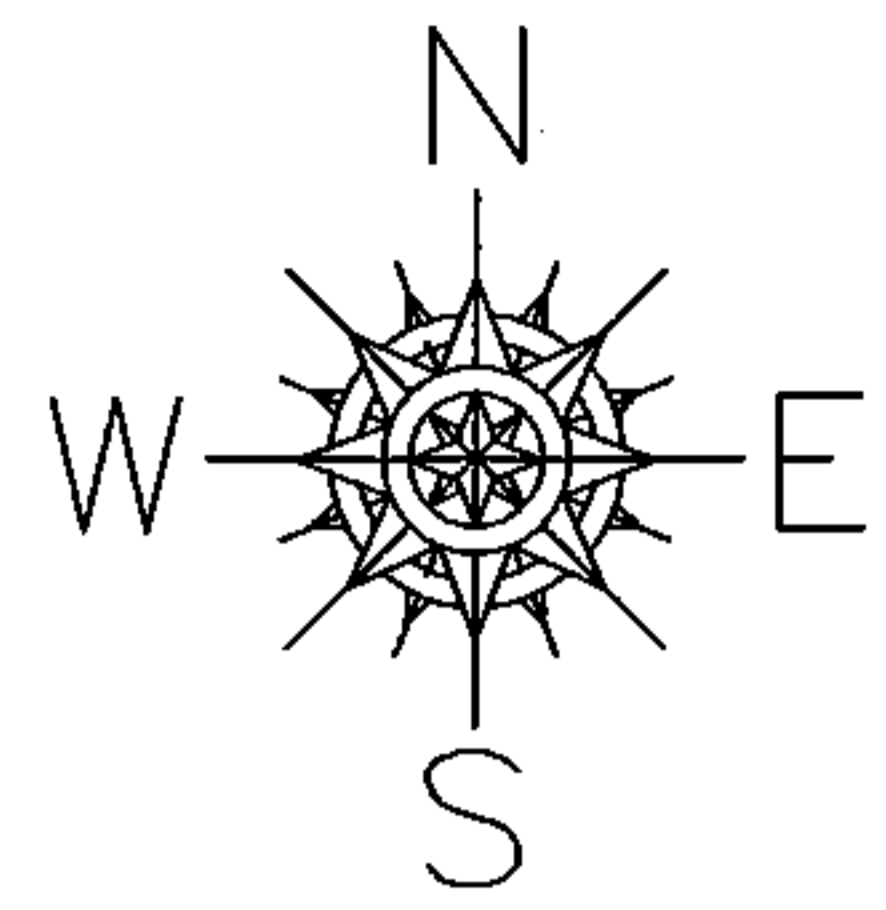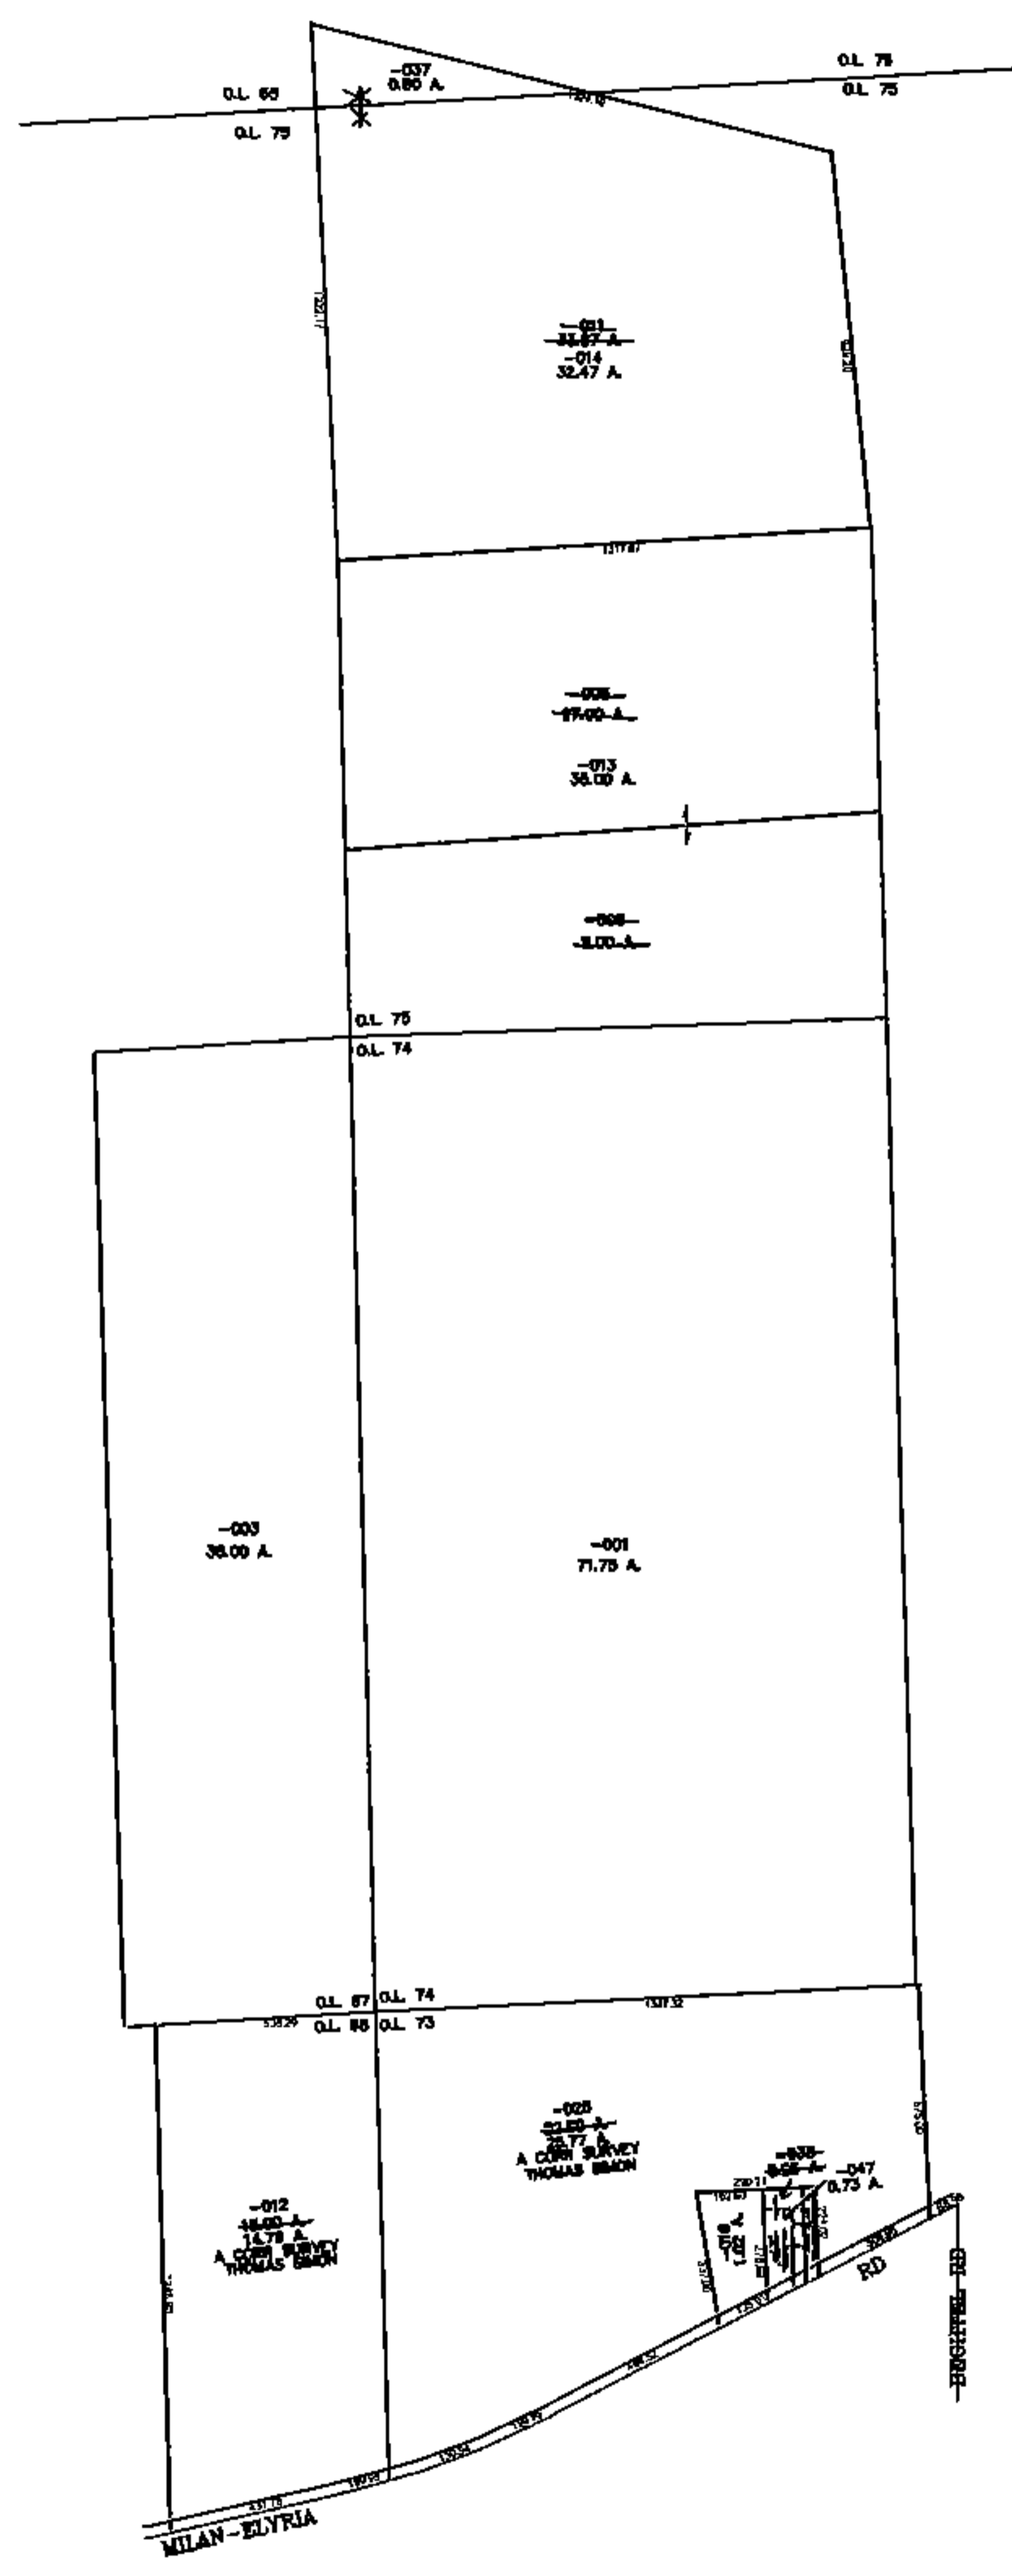

- \*05-00-075-000-013
- 05-00-075-000-014
- 05-00-076-000-037
- 05-00-073-000-047

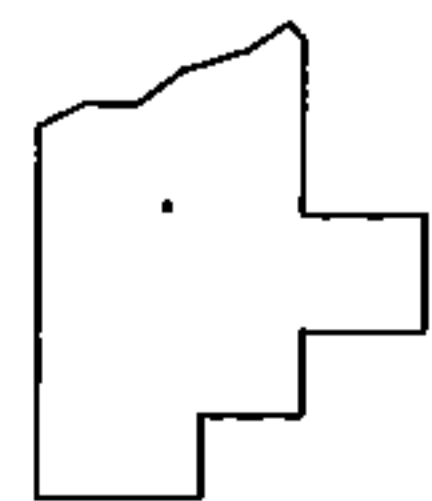

**SPLITS/DEEDS PROCESSED**

LORAIN COUNTY TAX MAP DEPARTMENT  
226 MIDDLE AVE. ELYRIA, OHIO

SURVEYED BY: THOMAS SIMON  
 CLOSURE: 0.00 : 10.000  
 MAP PAGE(S): 5-H  
 APPROVED BY: JAH DATE: 8-25-2014  
 SCALE: 1" = 800 PRIOR INSTRUMENT: 20140515580