
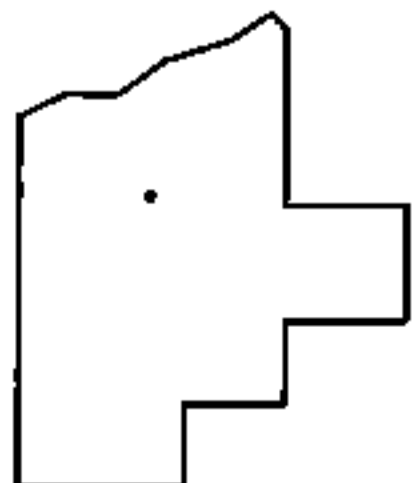
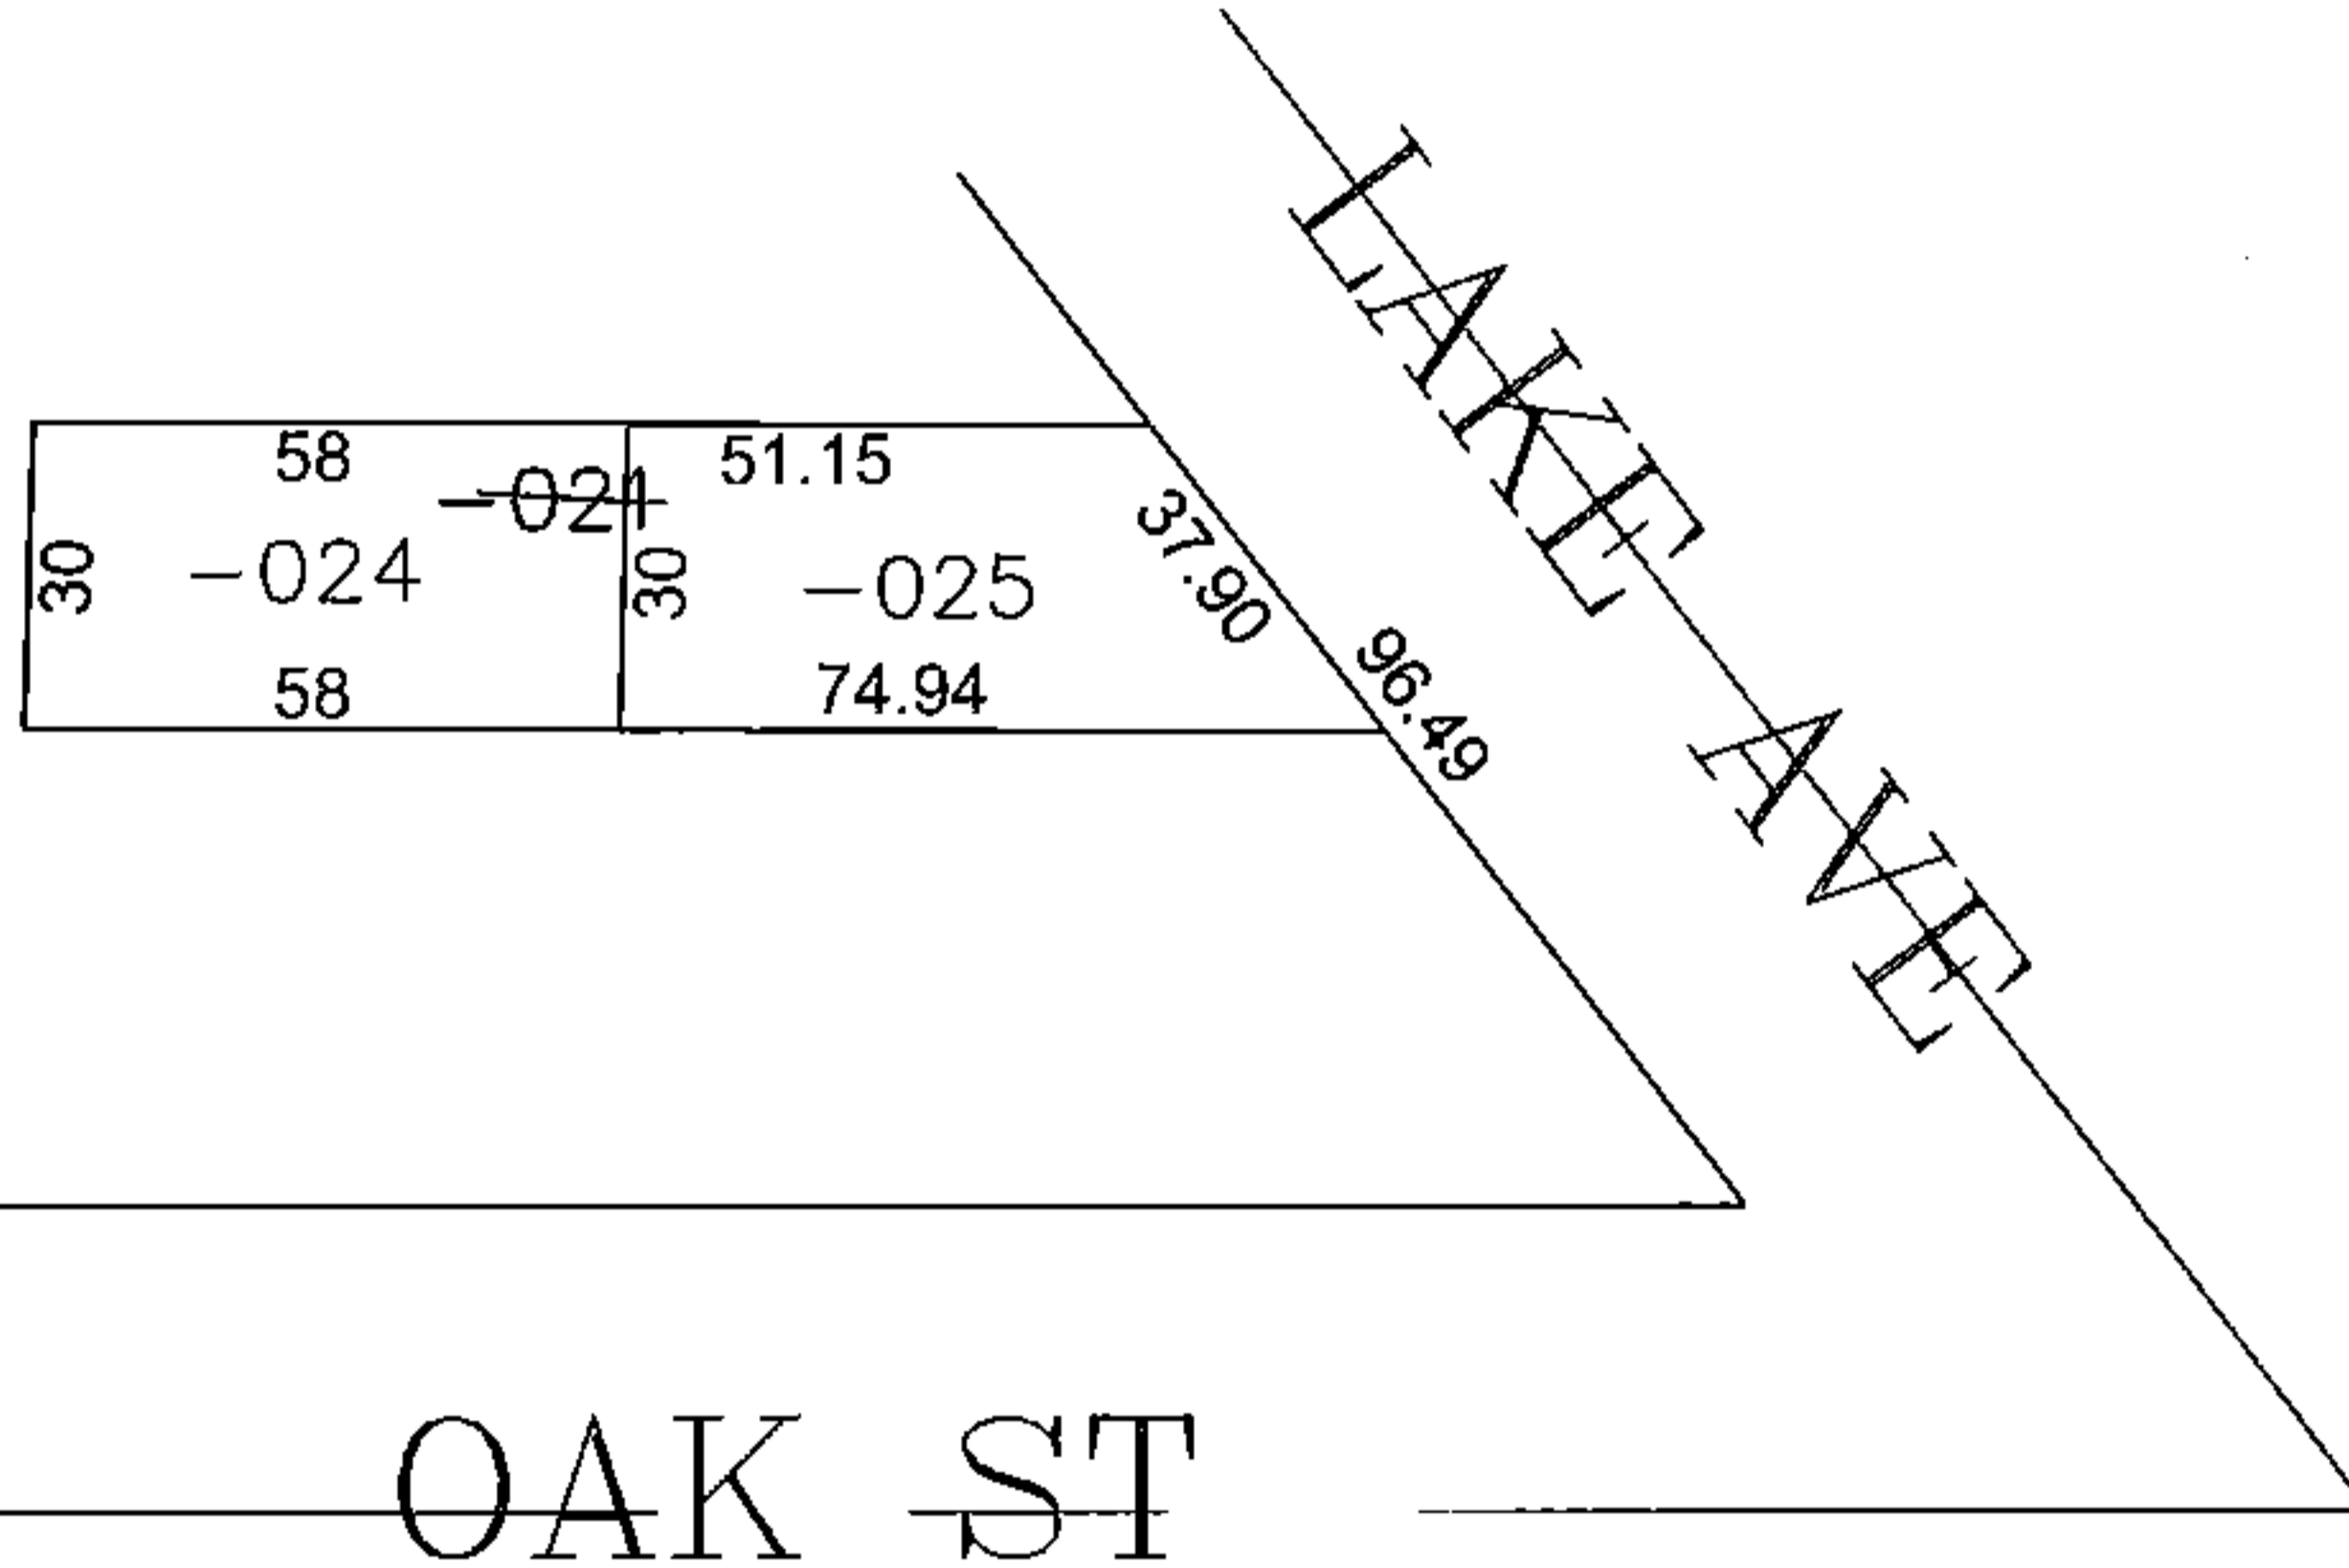


PARENT PARCEL: 06-24-083-101-021

CHILD PARCEL: 06-24-083-101-024, -025

STARTING POINT: RIGHT OF WAY LINE OF LAKE AVE & OAK ST

14-03276

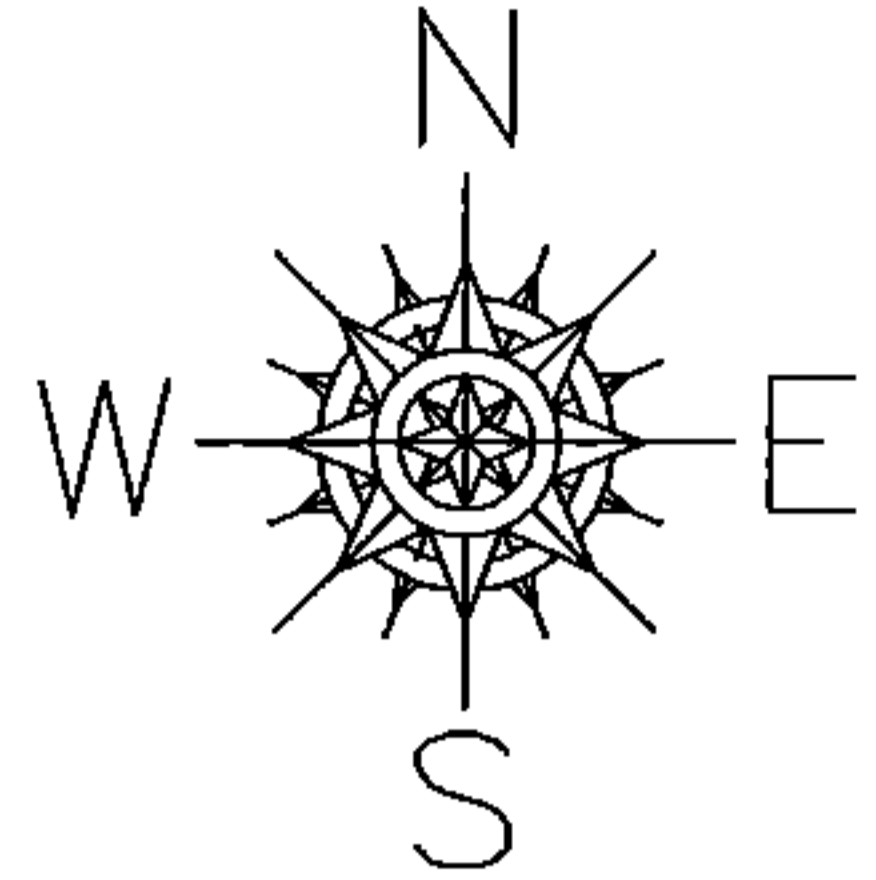

SPLITS/DEEDS PROCESSED

LORAIN COUNTY TAX MAP DEPARTMENT
226 MIDDLE AVE. ELYRIA, OHIO

SURVEYED BY: DANE HAPONER

CLOSURE: 0.00 : 10,000

MAP PAGE(S): 6-80

APPROVED BY: JAH DATE: 8/20/2014

SCALE: 1" = 50' PRIOR INST.: DV 815/60