
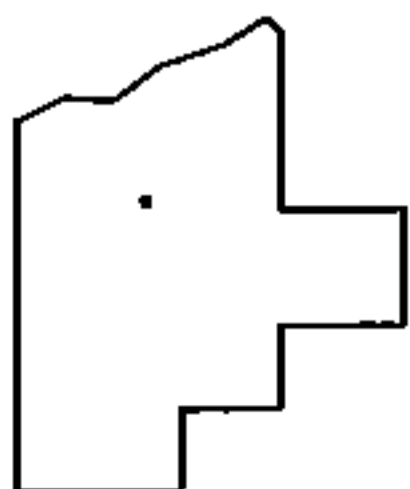
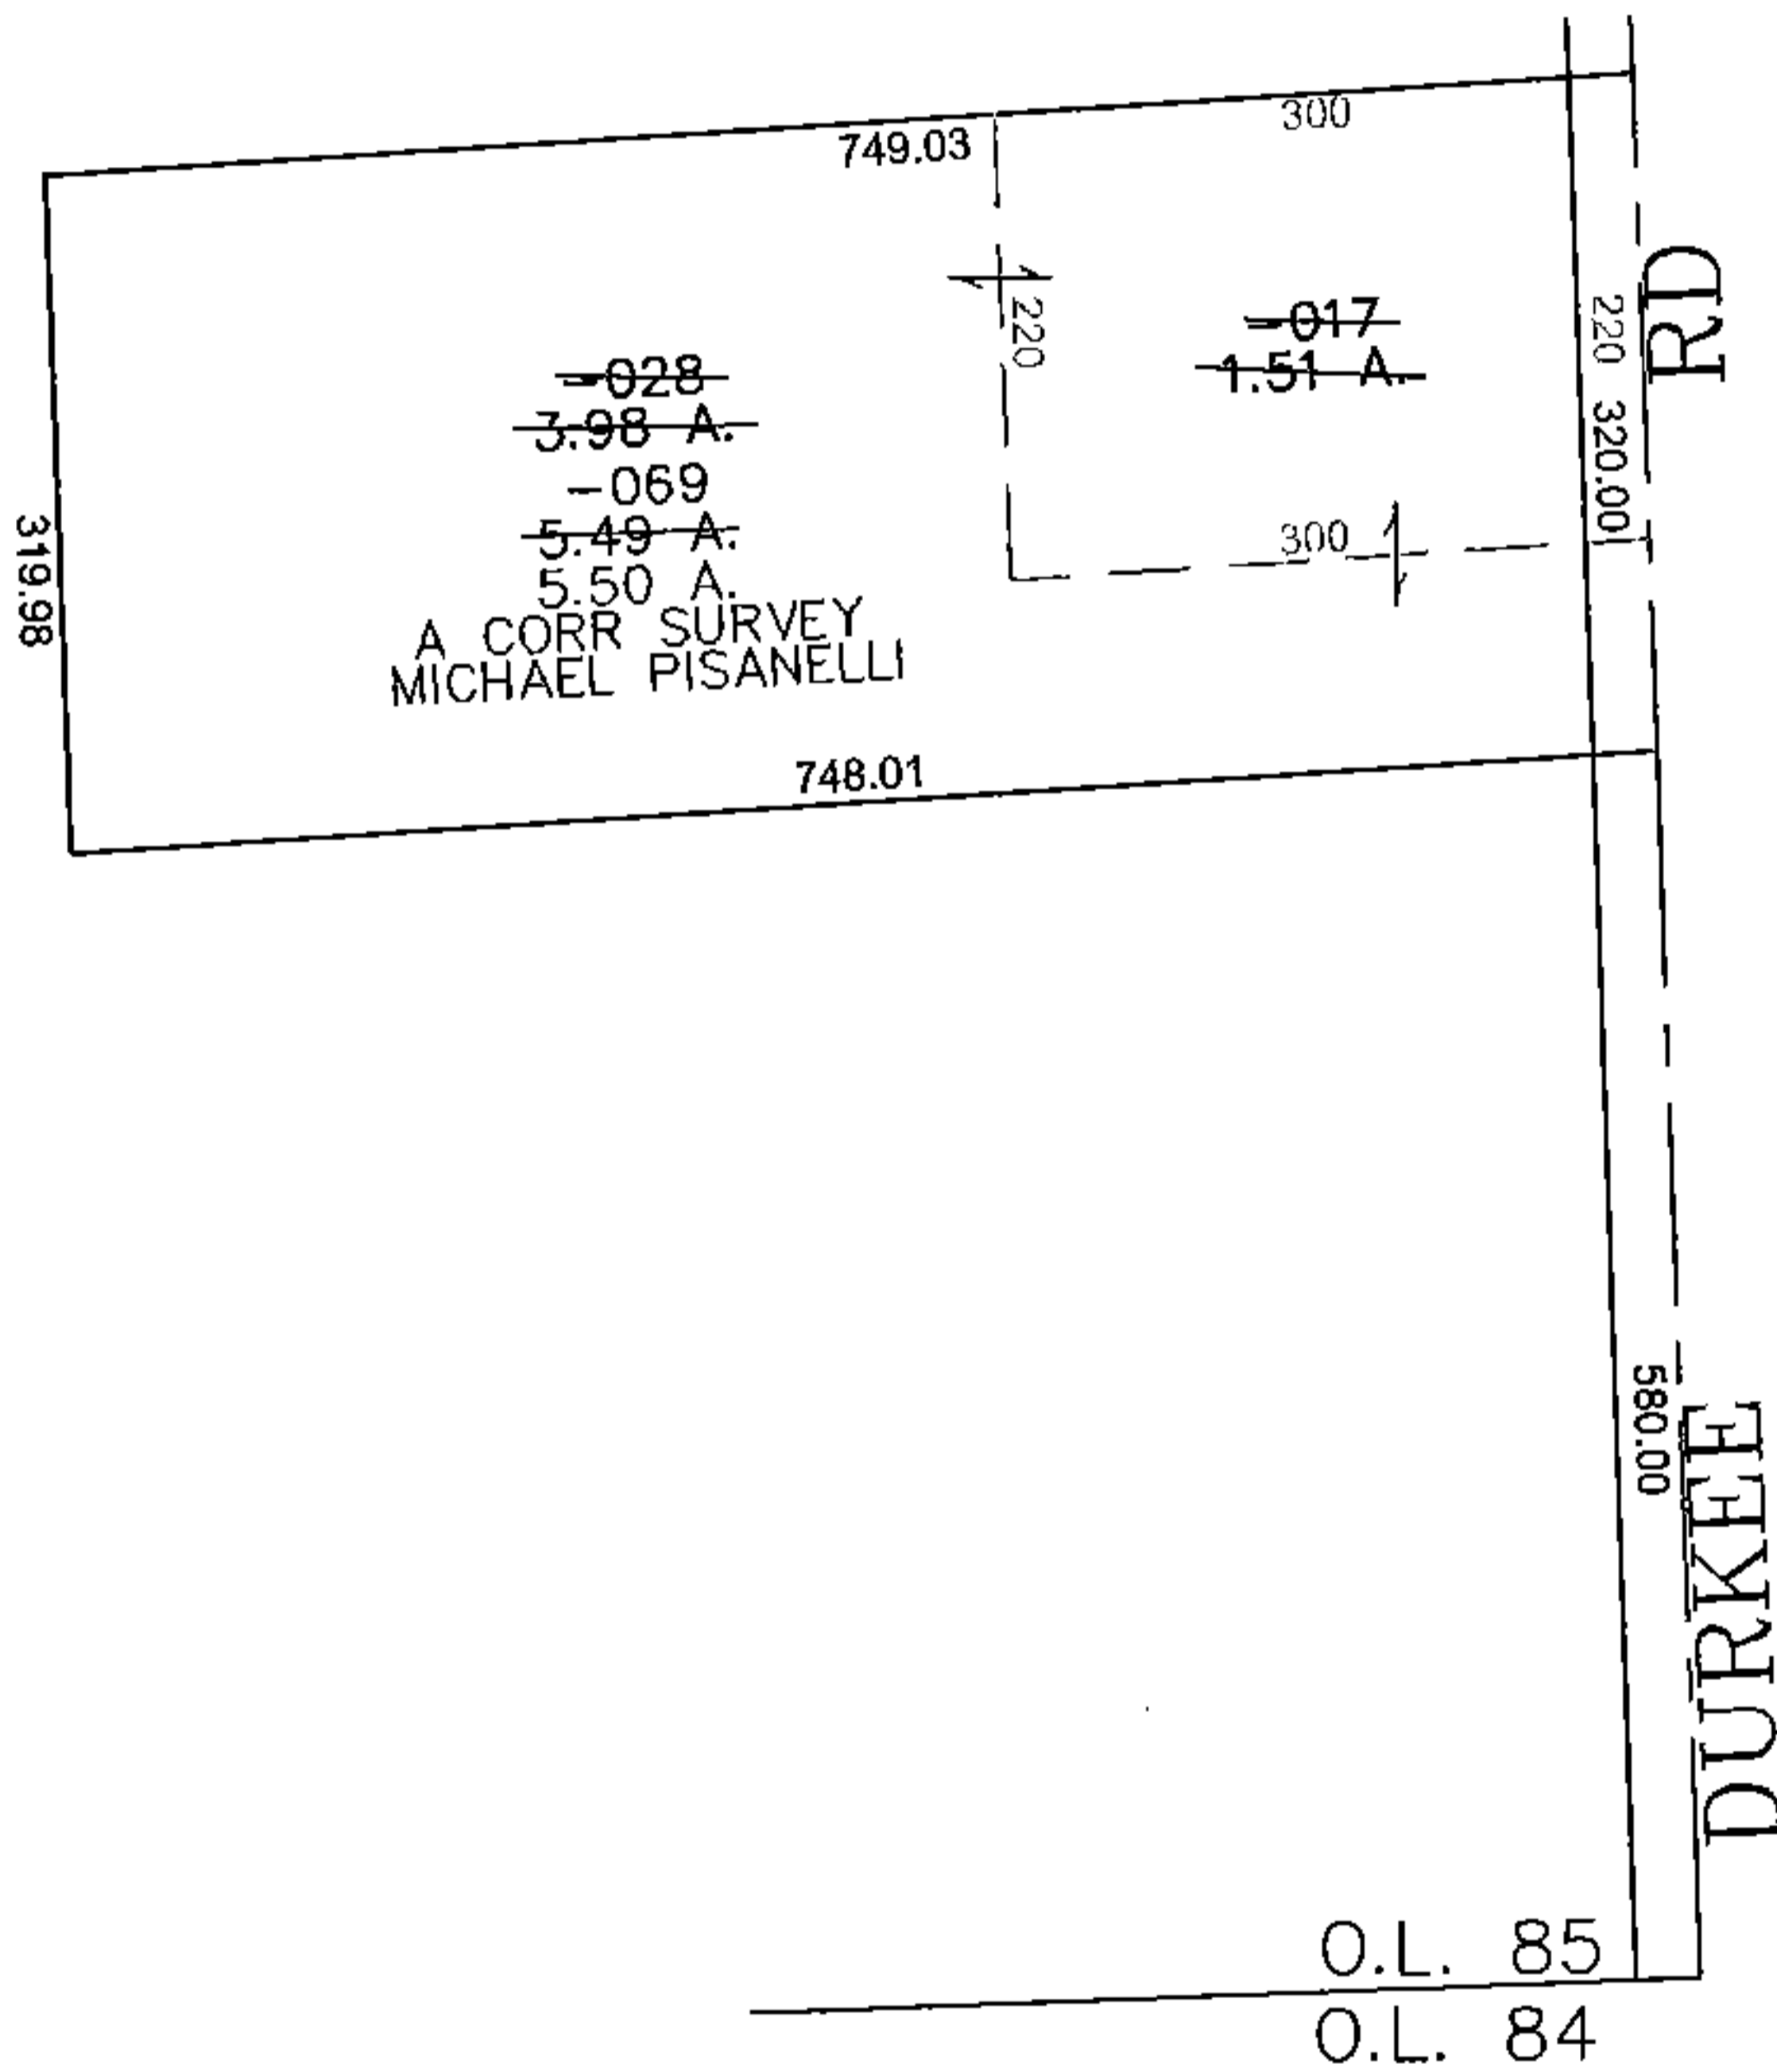


PARENT PARCEL: 11-00-085-000-017, -028

CHILD PARCEL: 11-00-085-000-069

STARTING POINT: CENTERLINE OF DURKEE RD & O.L. 85

14-03278

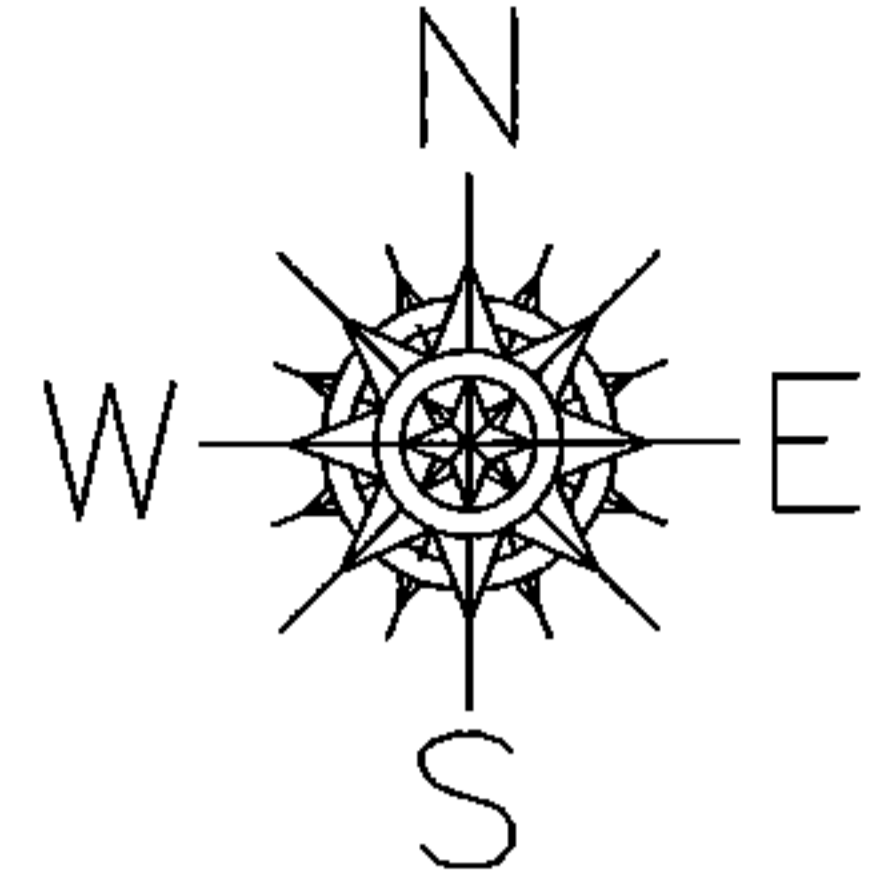

**SPLITS/DEEDS PROCESSED**  
**LORAIN COUNTY TAX MAP DEPARTMENT**  
 226 MIDDLE AVE. ELYRIA, OHIO

SURVEYED BY: MICHAEL PISANELLI  
 CLOSURE: 0.00 : 10.000  
 MAP PAGE(S): 11-E NORTH  
 APPROVED BY: JAH DATE: 8/27/2014  
 SCALE: 1" = 200 PRIOR INSTRUMENT: 2001070147