
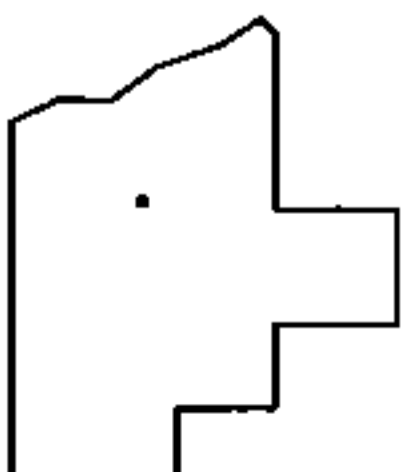
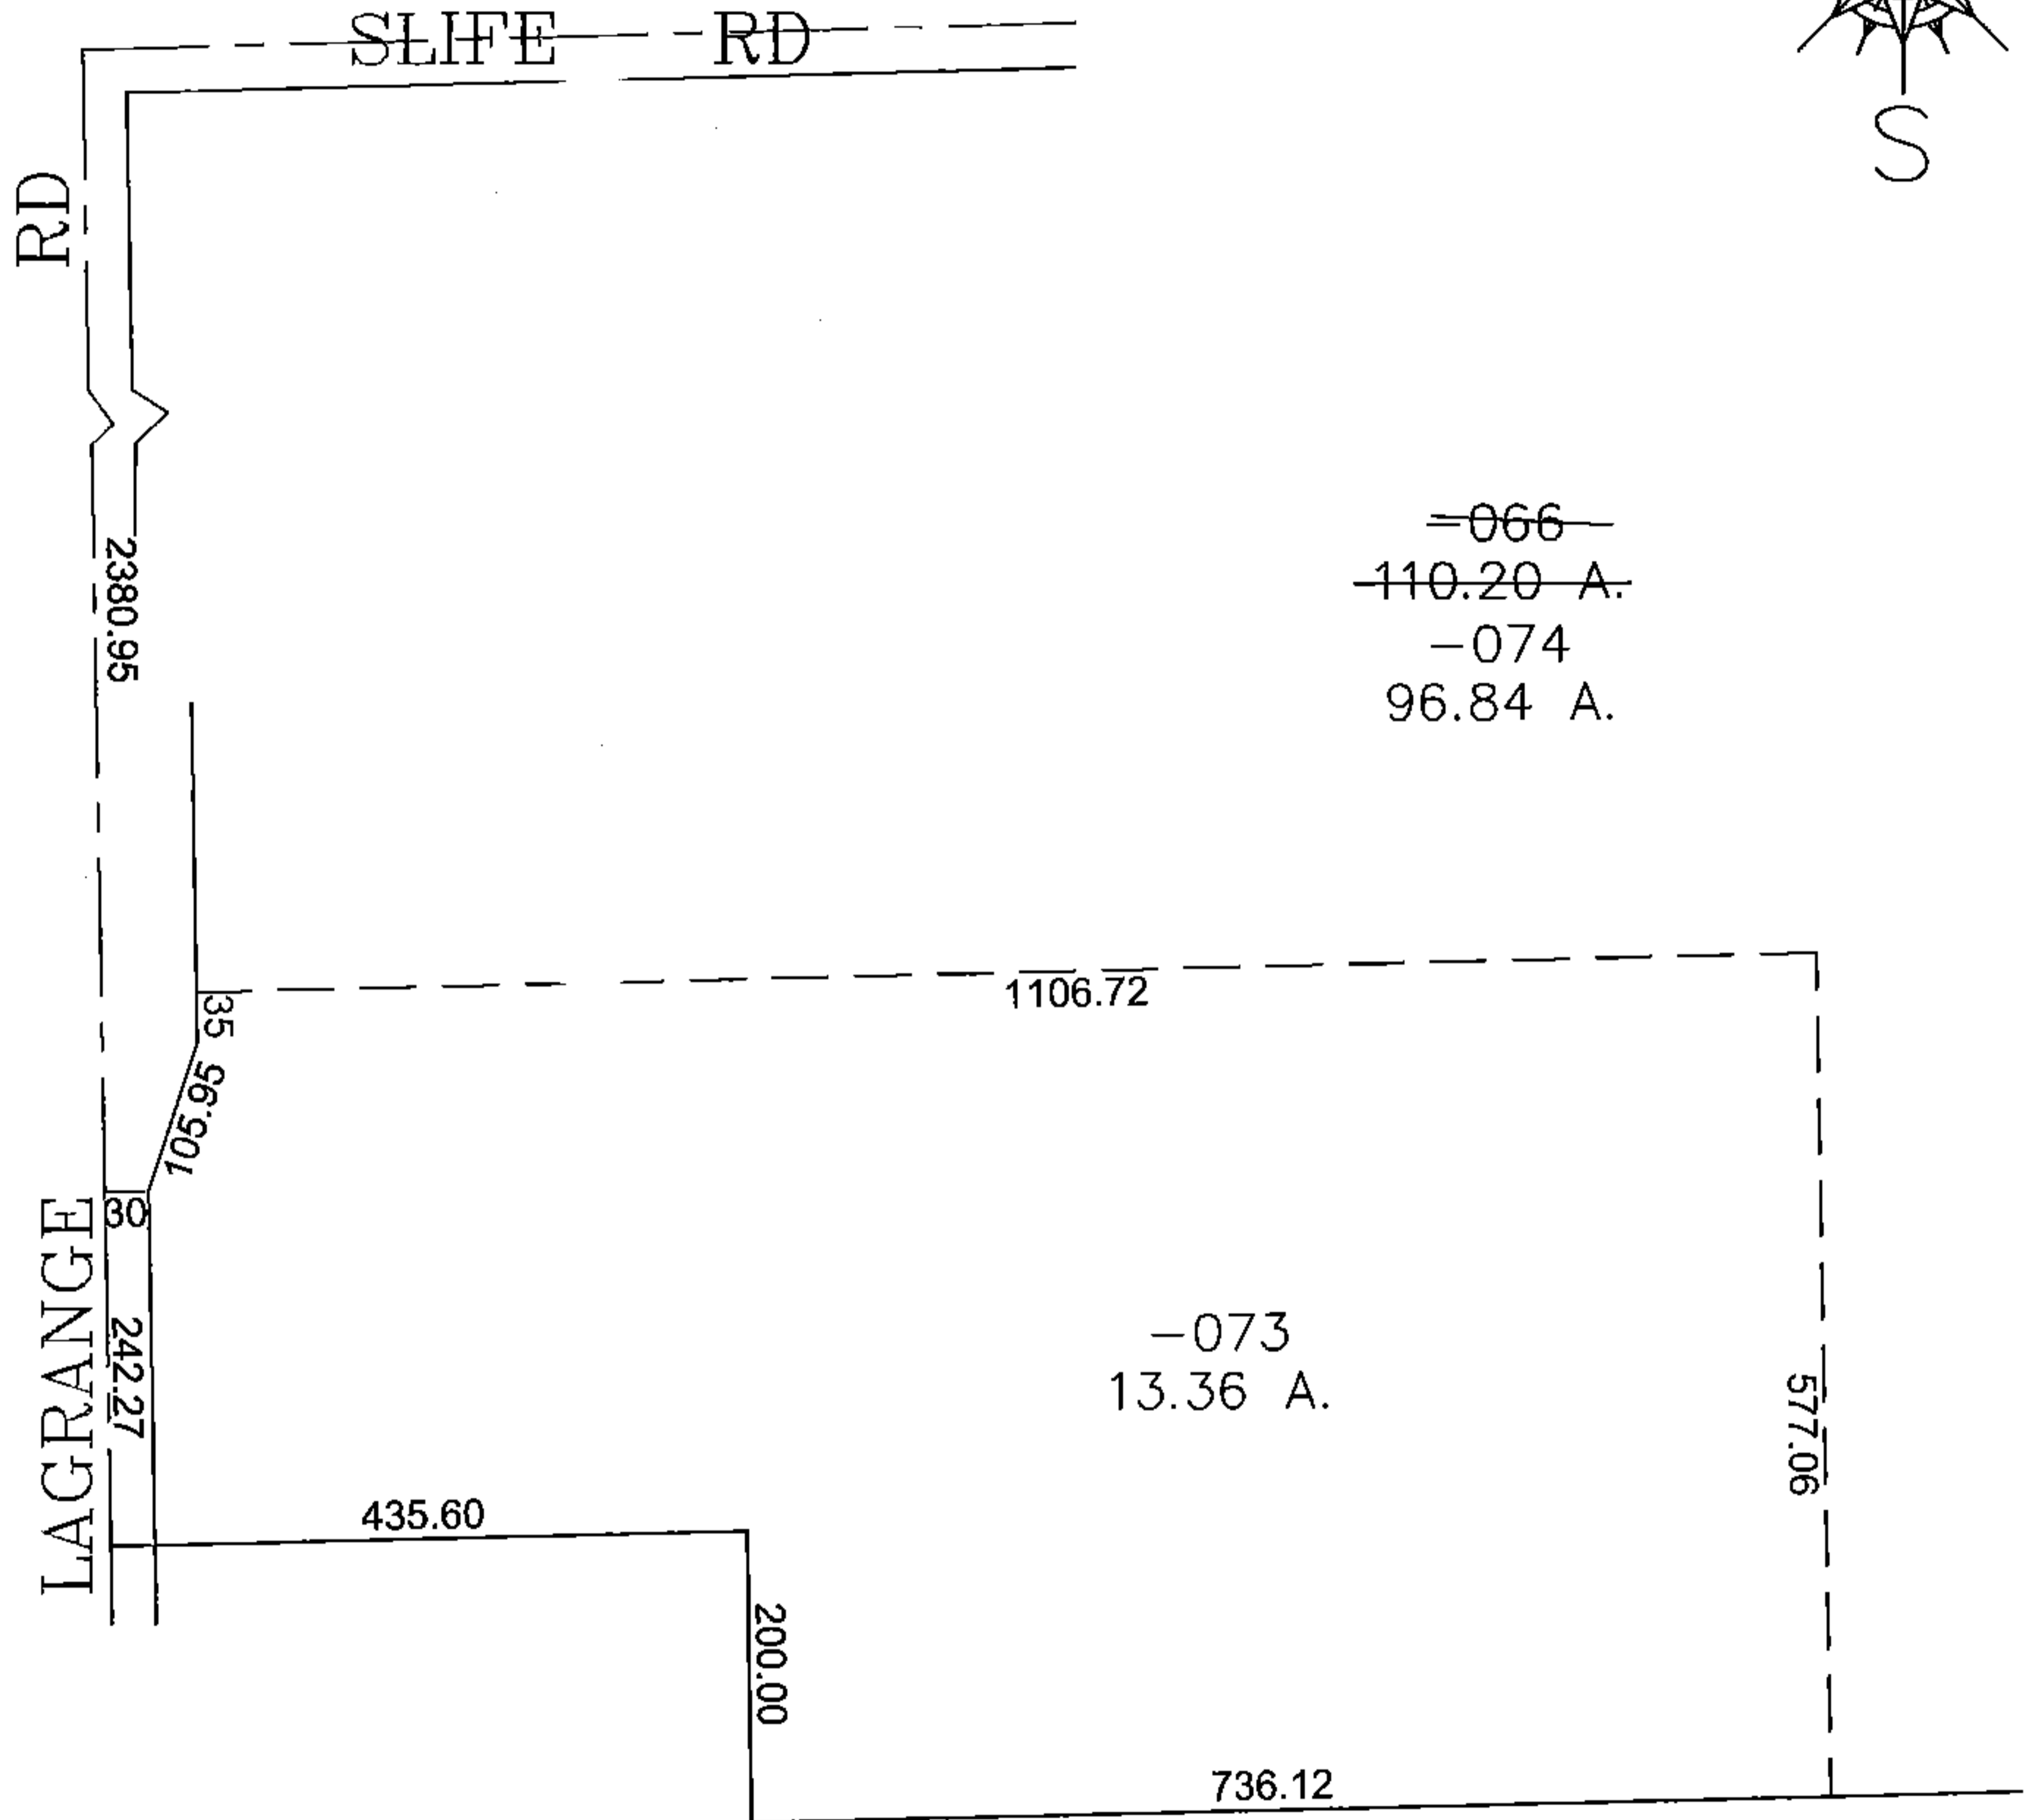


PARENT PARCEL: 10-00-018-102-066

CHILD PARCEL: 10-00-018-102-073, -074

STARTING POINT: CENTERLINE OF LAGRANGE RD & SLIFE RD

14-03279

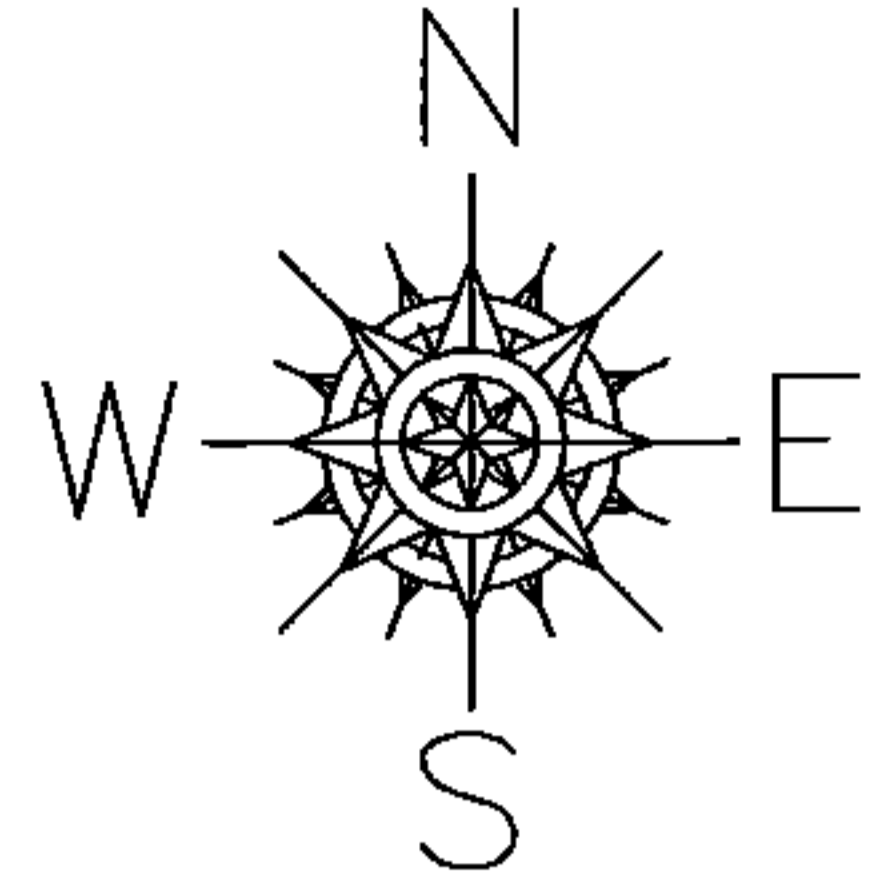

**SPLITS/DEEDS PROCESSED**  
 LORAIN COUNTY TAX MAP DEPARTMENT  
 226 MIDDLE AVE. ELYRIA, OHIO

SURVEYED BY: DALE HAYWOOD  
 CLOSURE: 0.00 : 10,000  
 MAP PAGE(S): 10-00-018-A  
 APPROVED BY: JAH DATE: 8/27/2014  
 SCALE: 1" = 200' PRIOR INSTRUMENT: 20140507110