
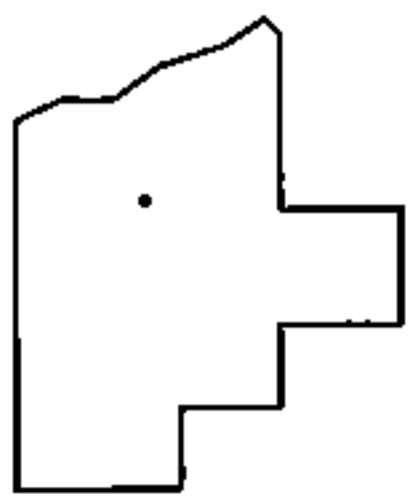
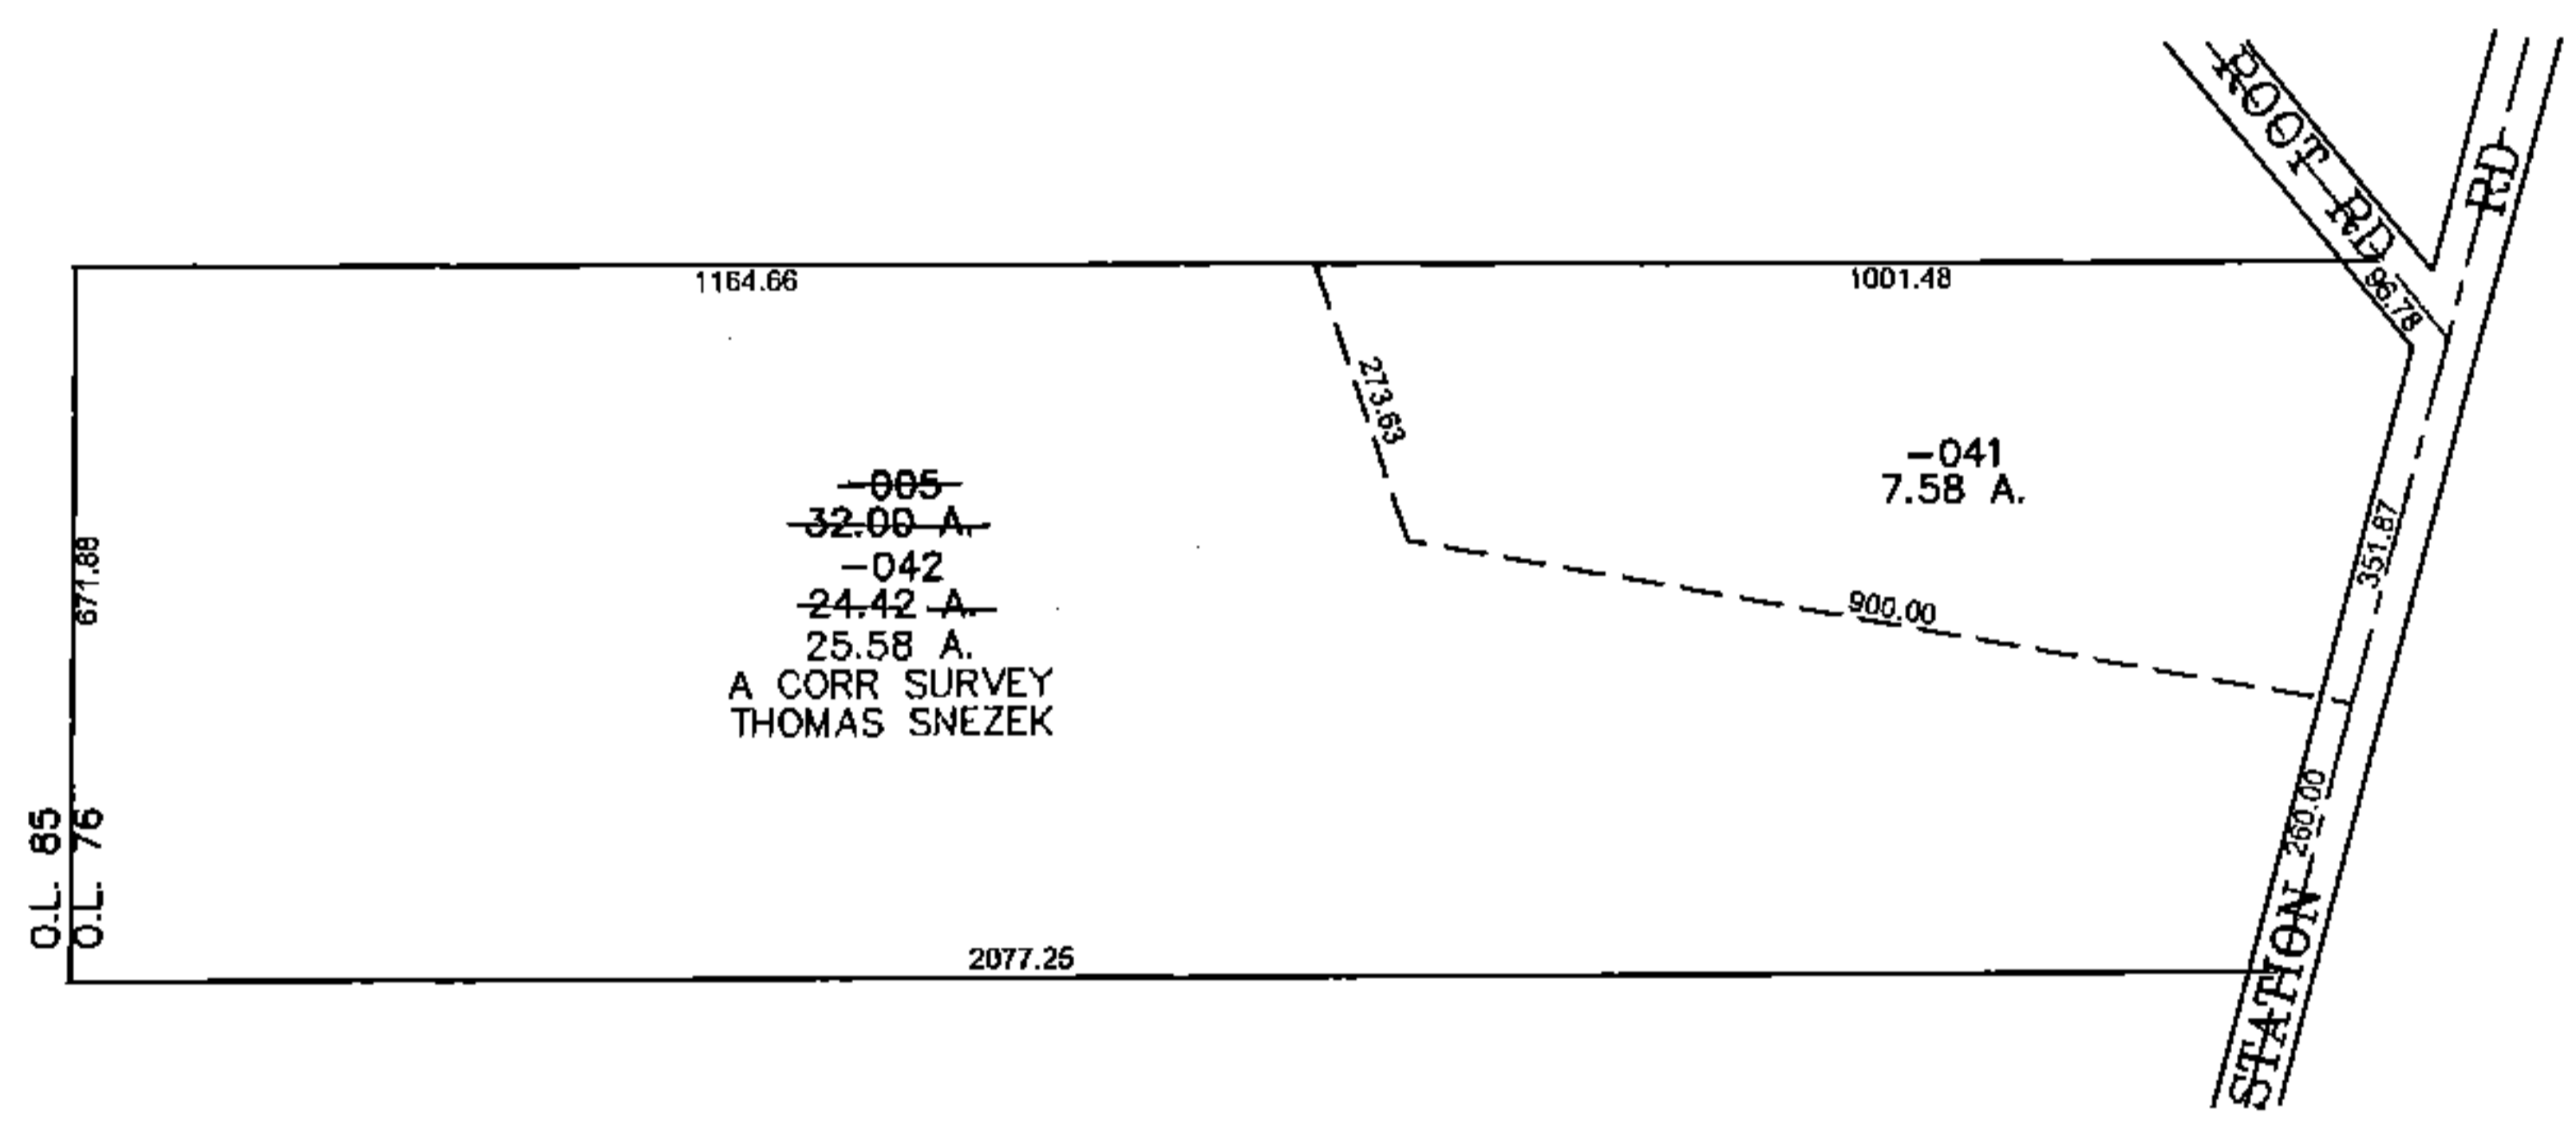


PARENT PARCEL: 12-00-076-101-005  
CHILD PARCEL: 12-00-076-101-041, -042  
STARTING POINT: CENTERLINE OF ROOT RD & STATION RD

**14-03280**

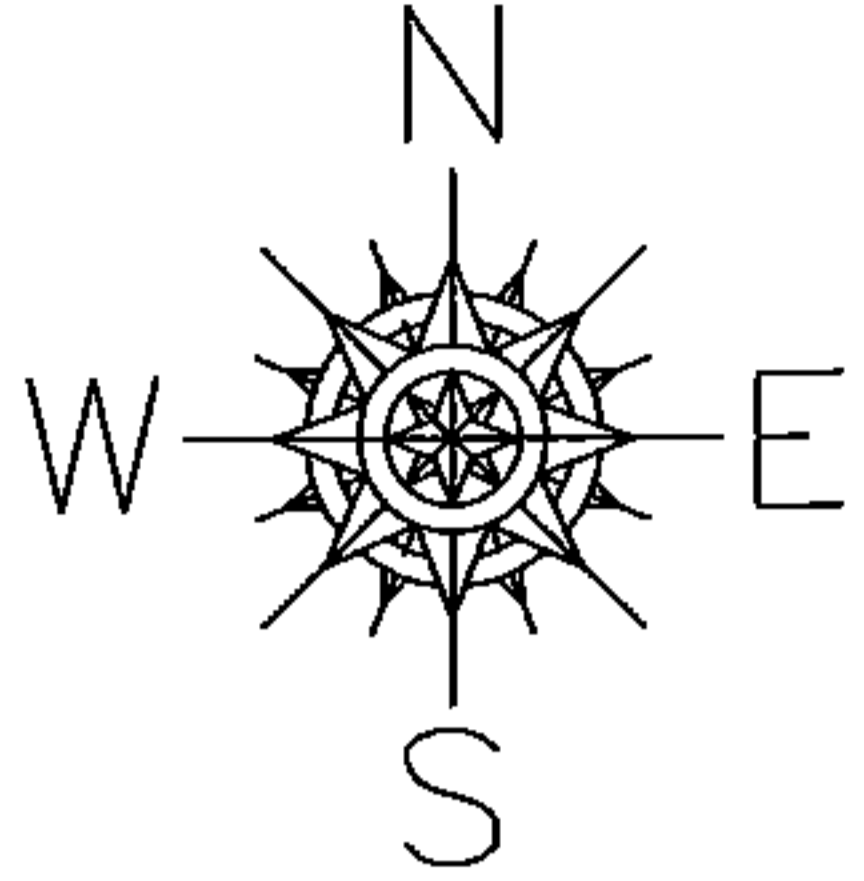

**SPLITS/DEEDS PROCESSED**  
LORAIN COUNTY TAX MAP DEPARTMENT  
226 MIDDLE AVE. ELYRIA, OHIO

SURVEYED BY: THOMAS SNEZEK  
CLOSURE: 0.00 : 10,000  
MAP PAGE(S): 12-00-076-A, B  
APPROVED BY: JAH DATE: 8/28/2014  
SCALE: 1"= 400 PRIOR INST.: 20140513280