
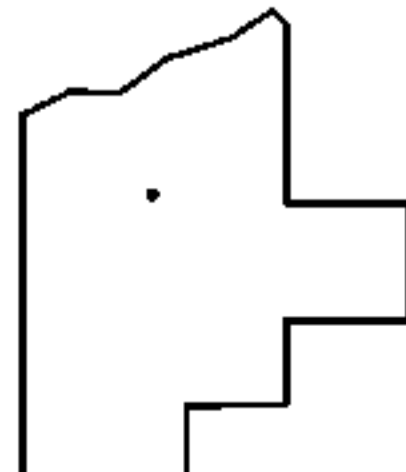
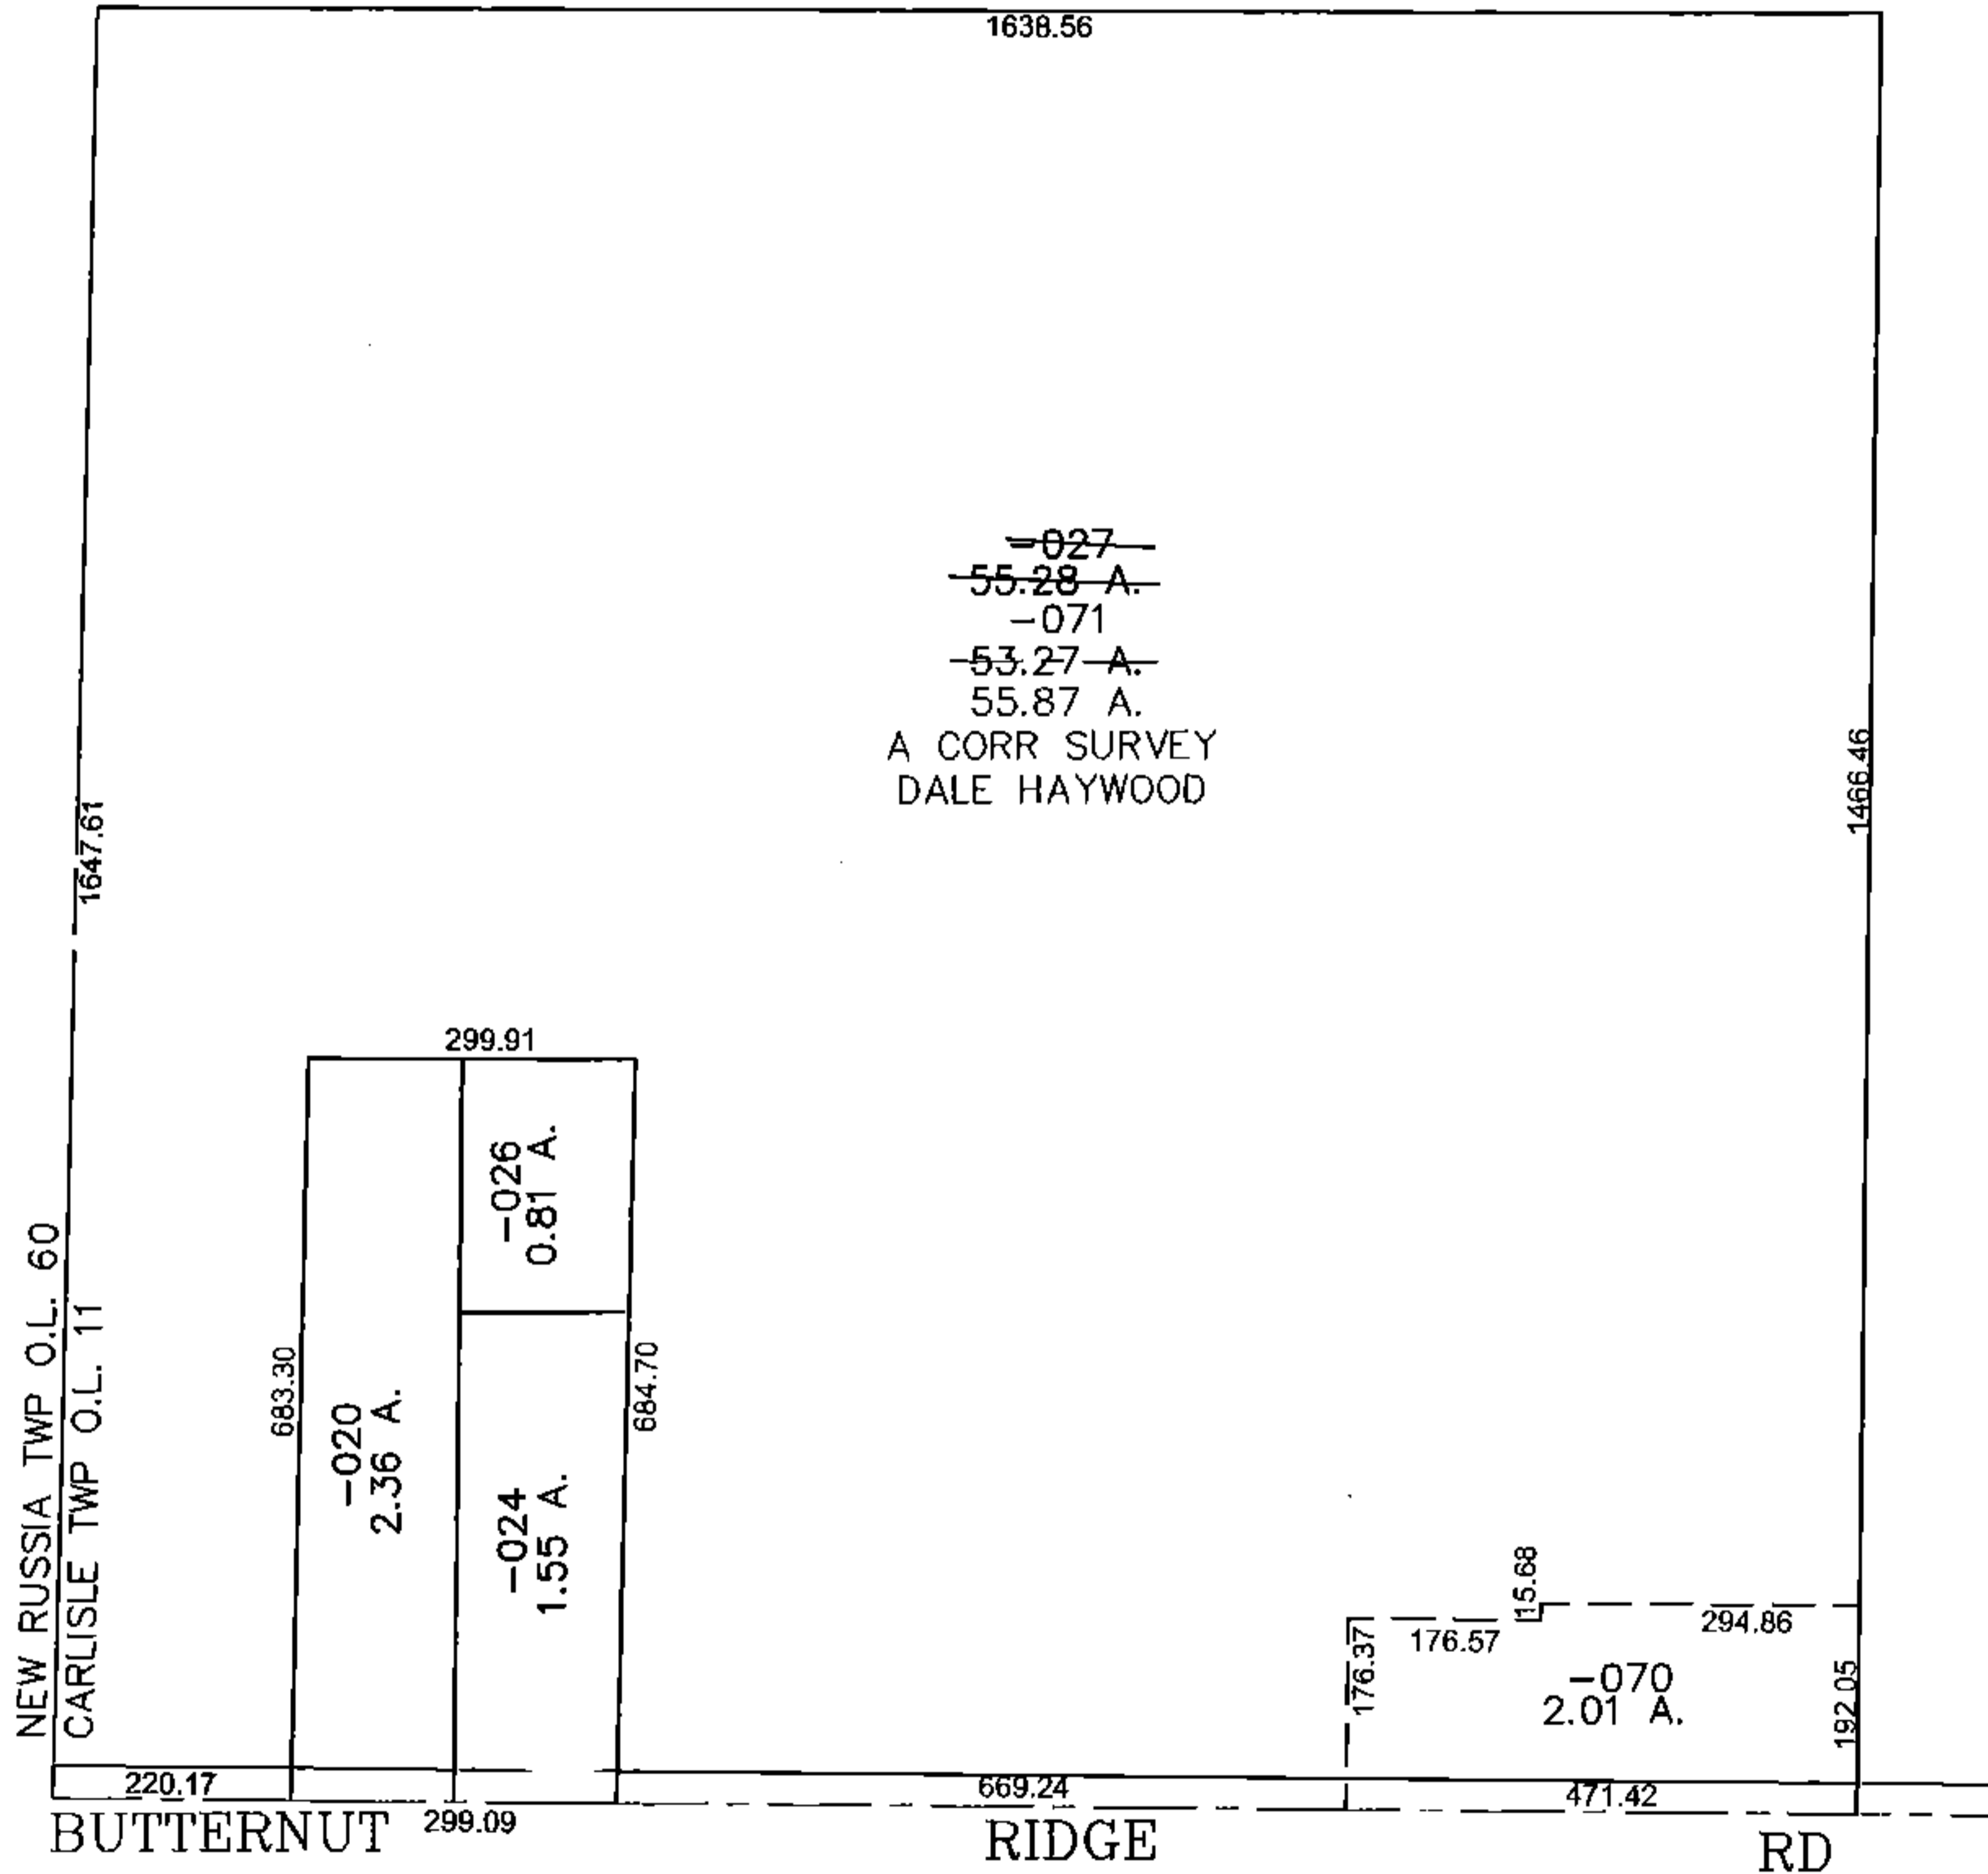


PARENT PARCEL: 10-00-011-101-027

CHILD PARCEL: 10-00-011-101-070, -071

STARTING POINT: CENTERLINE OF BUTTERNUT RIDGE RD & O.L. 11

14-03281

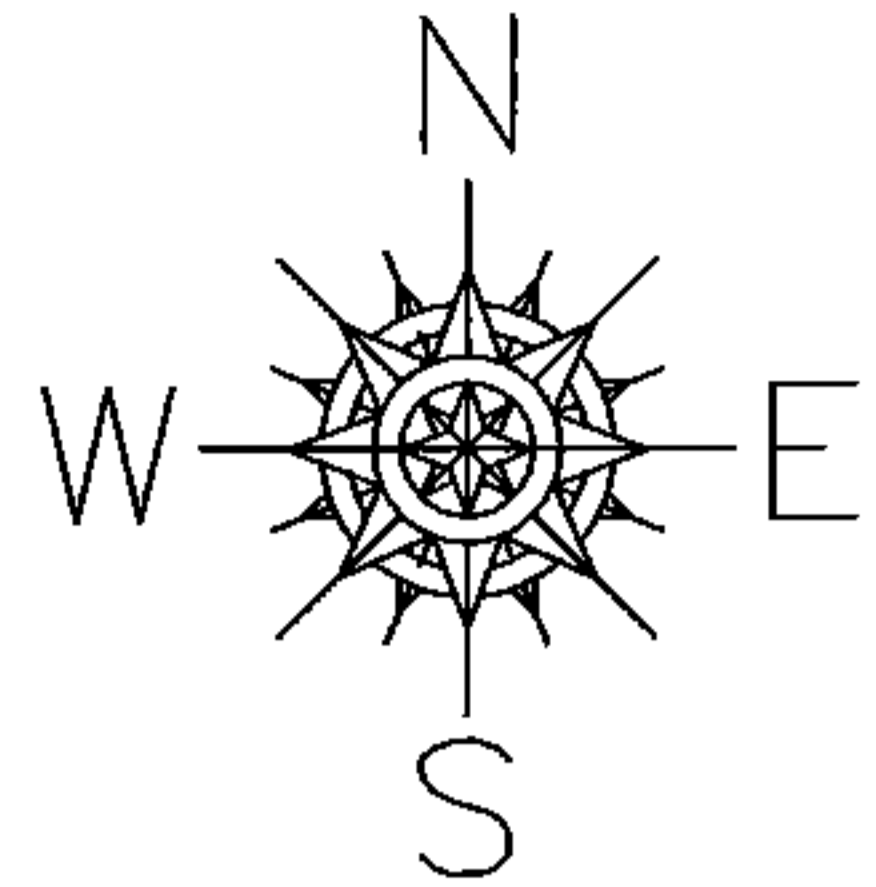

**SPLITS/DEEDS PROCESSED**  
 LORAIN COUNTY TAX MAP DEPARTMENT  
 226 MIDDLE AVE. ELYRIA, OHIO

SURVEYED BY: DALE HAYWOOD  
 CLOSURE: 0.00 : 10.000  
 MAP PAGE(S): 10-A  
 APPROVED BY: JAH DATE: 9/3/2014  
 SCALE: 1" = 300 PRIOR INSTRUMENT: 20050060696