
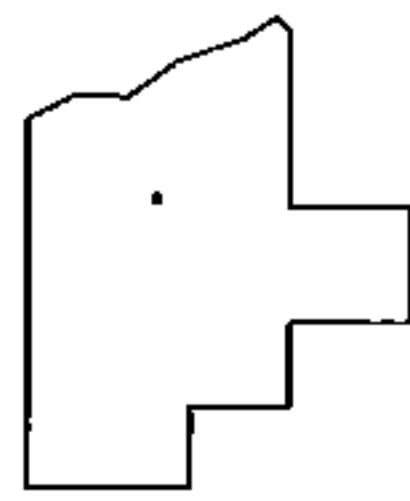
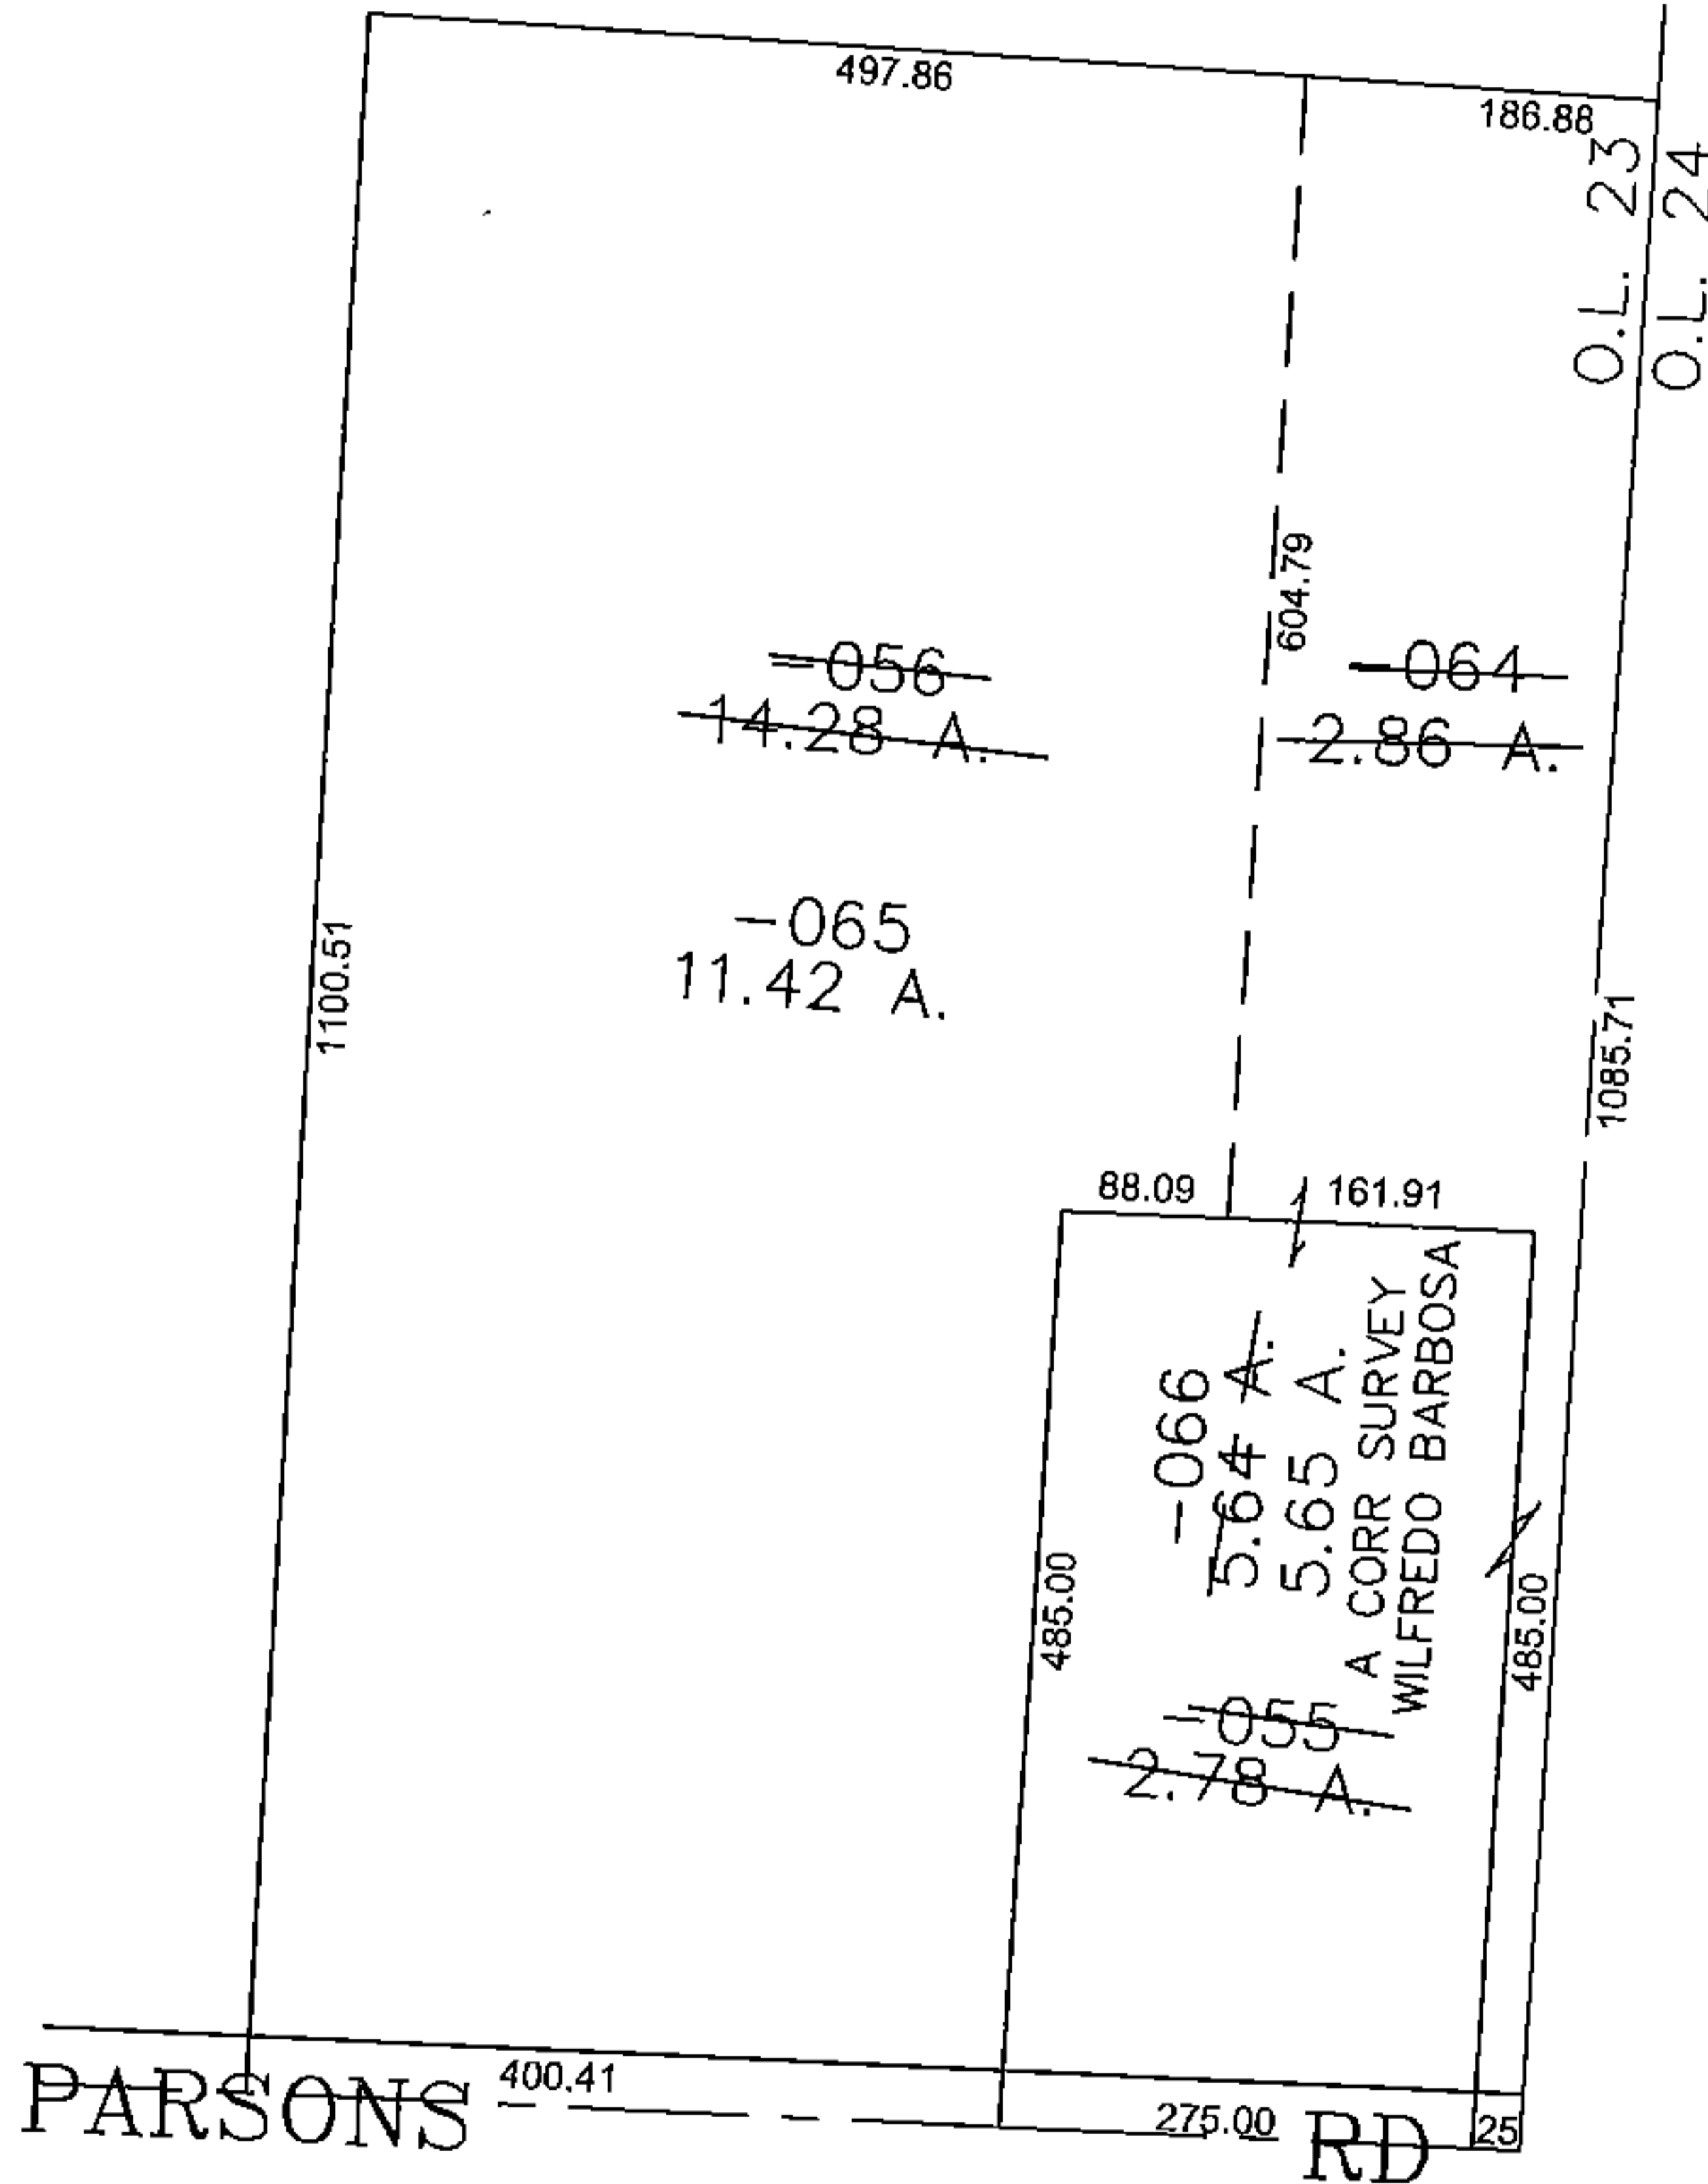


PARENT PARCEL: 10-00-023-102-056

CHILD PARCEL: 10-00-023-102-064, -065, -066

STARTING POINT: CENTERLINE OF PARSONS RD & O.L. 23

14-03282

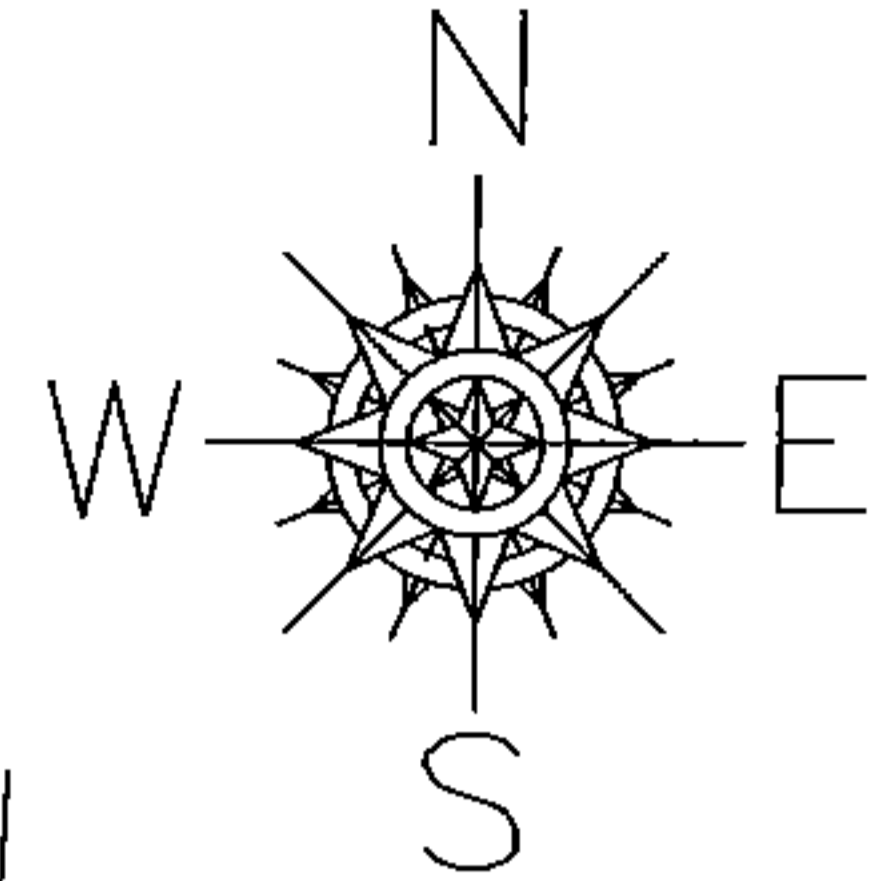

**SPLITS/DEEDS PROCESSED**  
 LORAIN COUNTY TAX MAP DEPARTMENT  
 226 MIDDLE AVE. ELYRIA, OHIO

SURVEYED BY: WILFREDO BARBOSA  
 CLOSURE: 0.00 : 10.000  
 MAP PAGE(S): 10-G  
 APPROVED BY: JAH DATE: 9/16/2014  
 SCALE: 1" = 200 PRIOR INSTRUMENT: 20010773490