
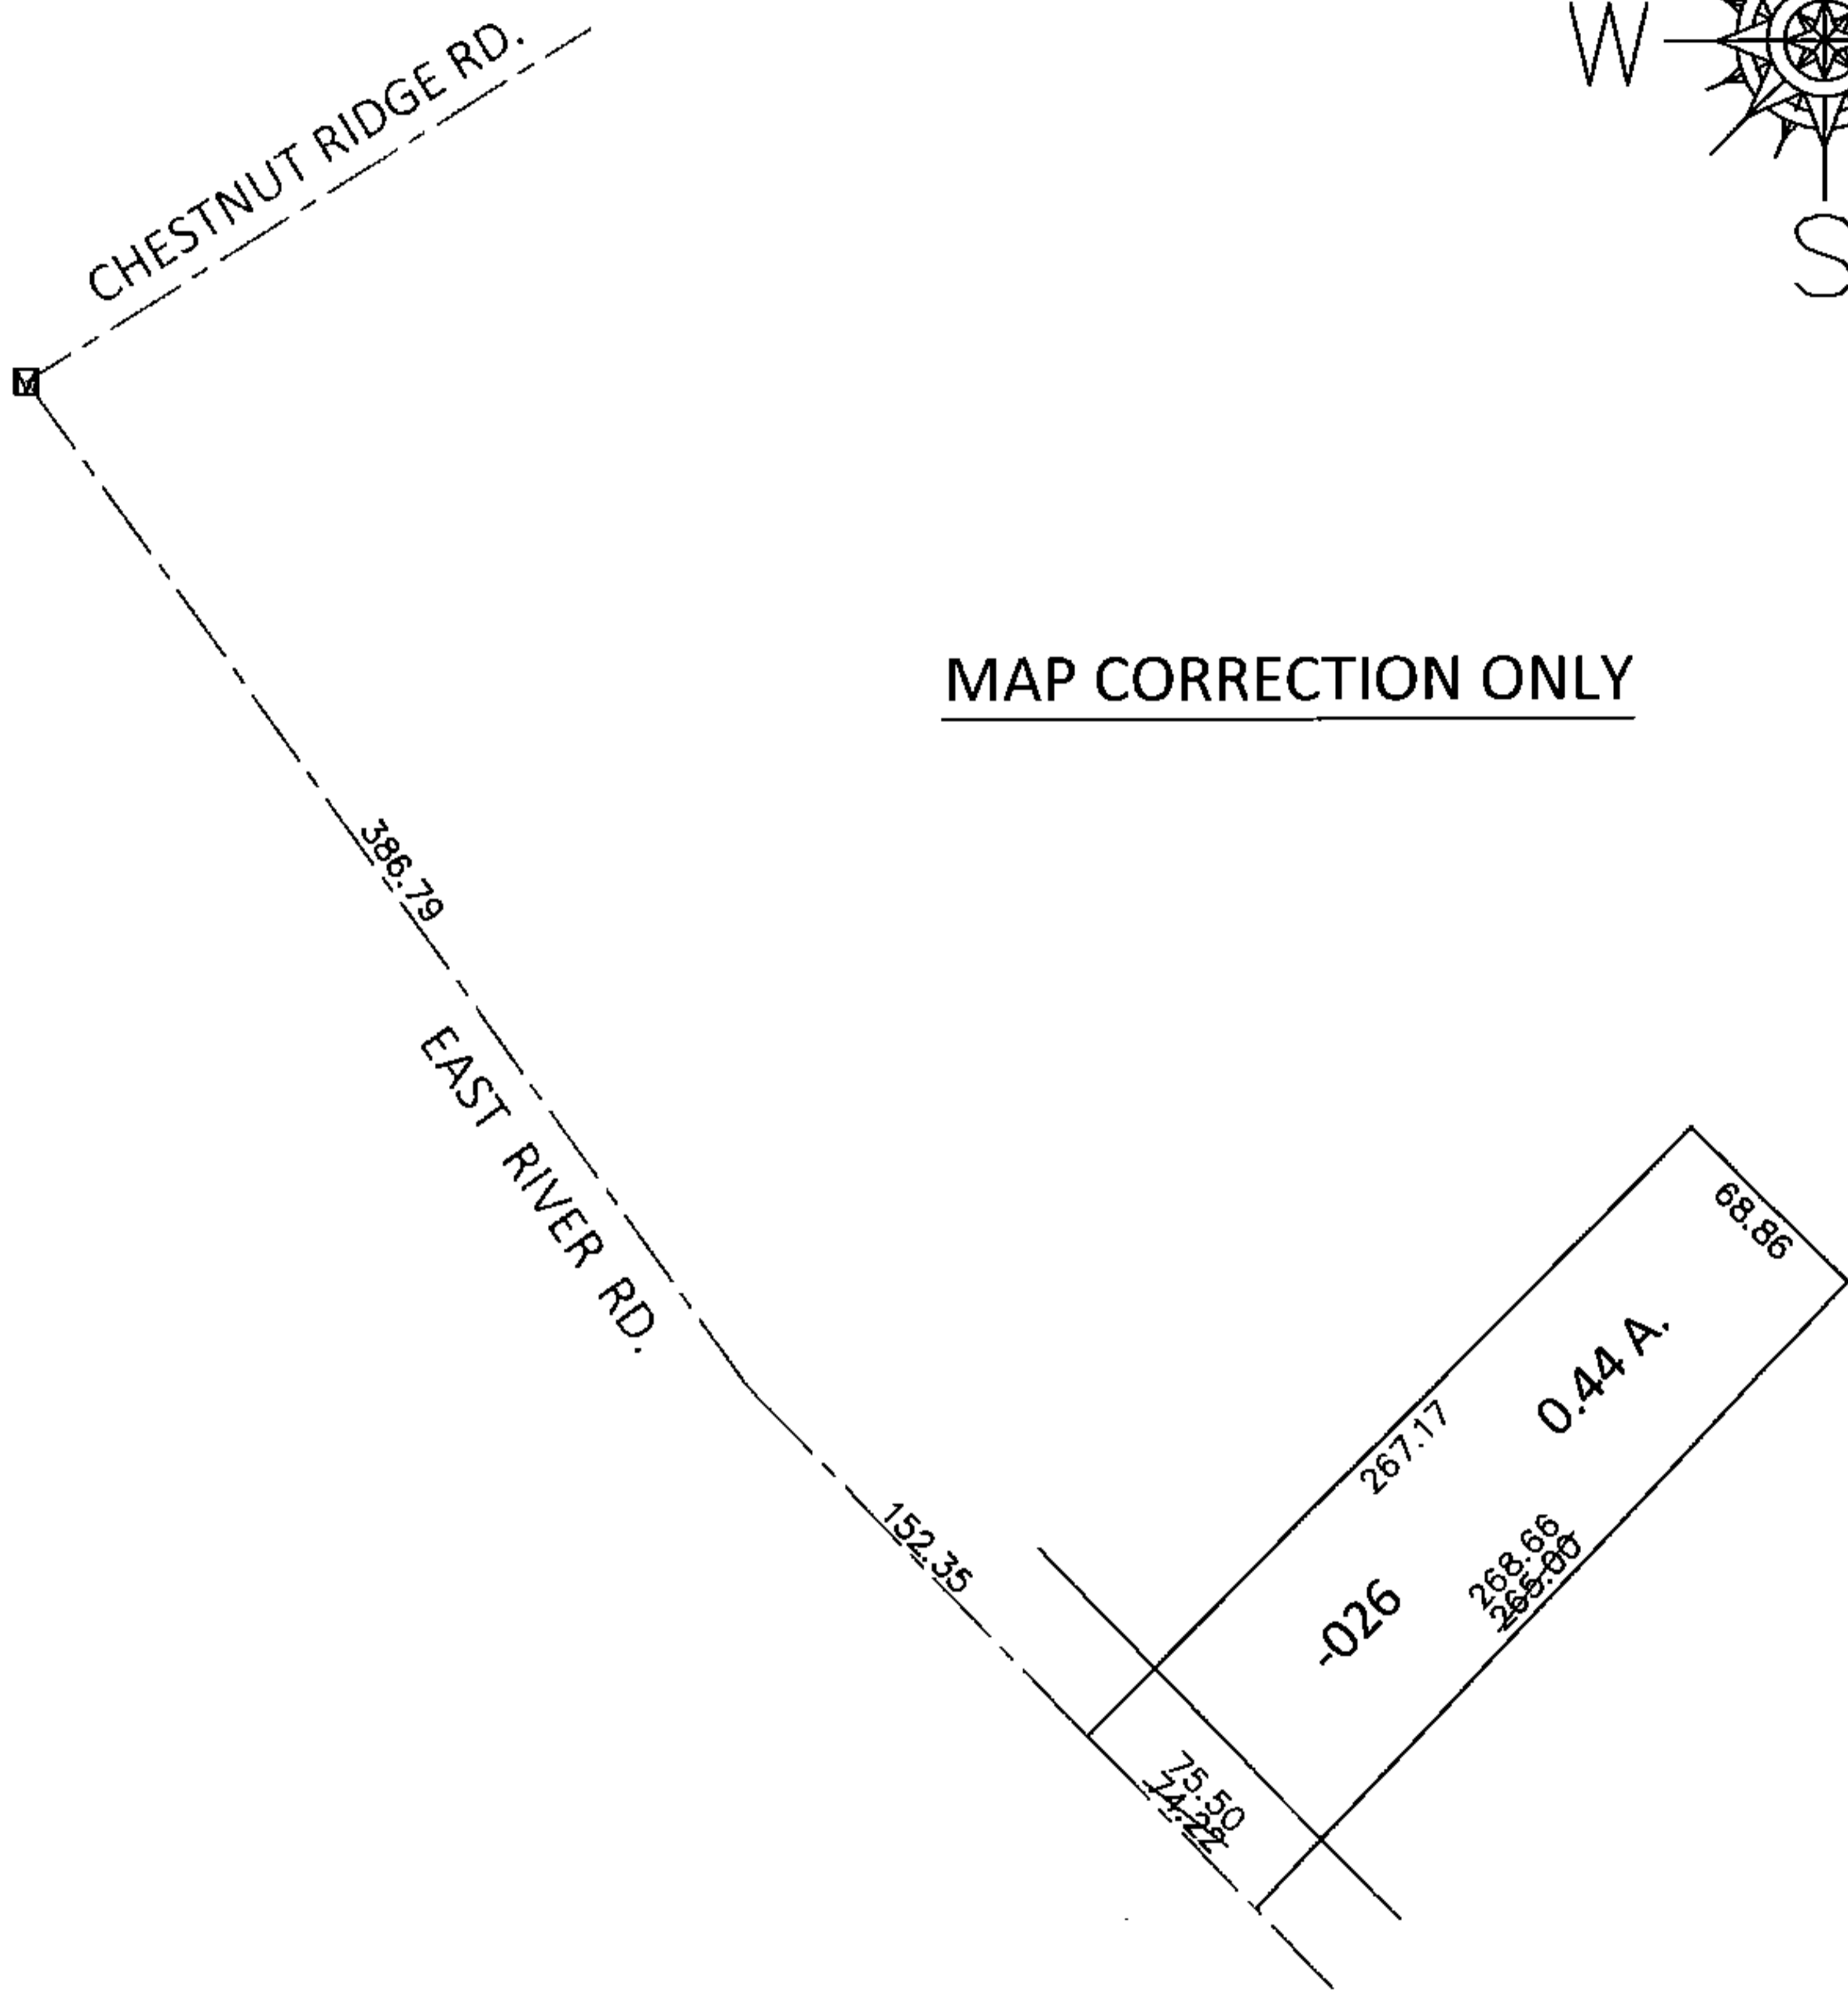


PARENT PARCEL: 10-00-005-107-026


CHILD PARCEL: _____

15-03283-A

STARTING POINT: AT A MON BOX AT THE INTERSECTION OF C/L OF CHESTNUT RIDGE RD. AND C/L OF EAST RIVER RD.

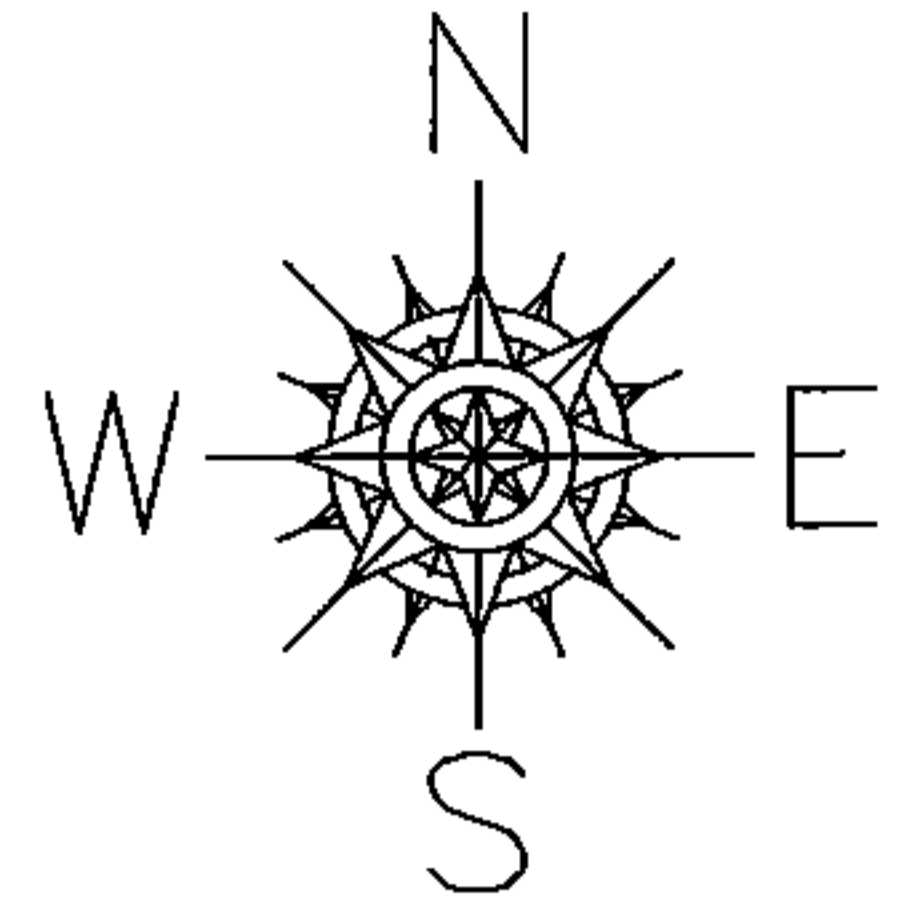

MAP CORRECTION ONLY

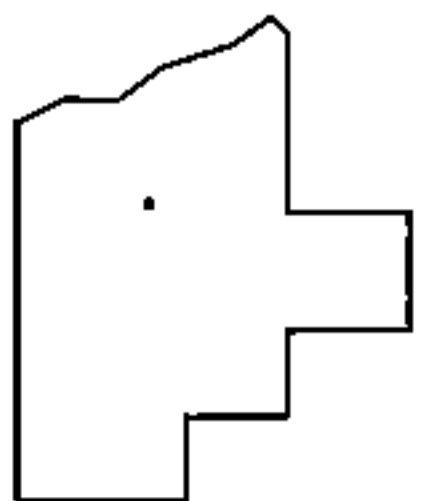

SPLITS/DEEDS PROCESSED

LORAIN COUNTY TAX MAP DEPARTMENT
226 MIDDLE AVE. ELYRIA, OHIO

SURVEYED BY: DALE R. HAYWOOD

CLOSURE: .01:10,000

MAP PAGE(S): 10-00-005-A

APPROVED BY: RRM DATE: 8-28-15

SCALE: 1"= 100 PRIOR INST.: 20140517896