

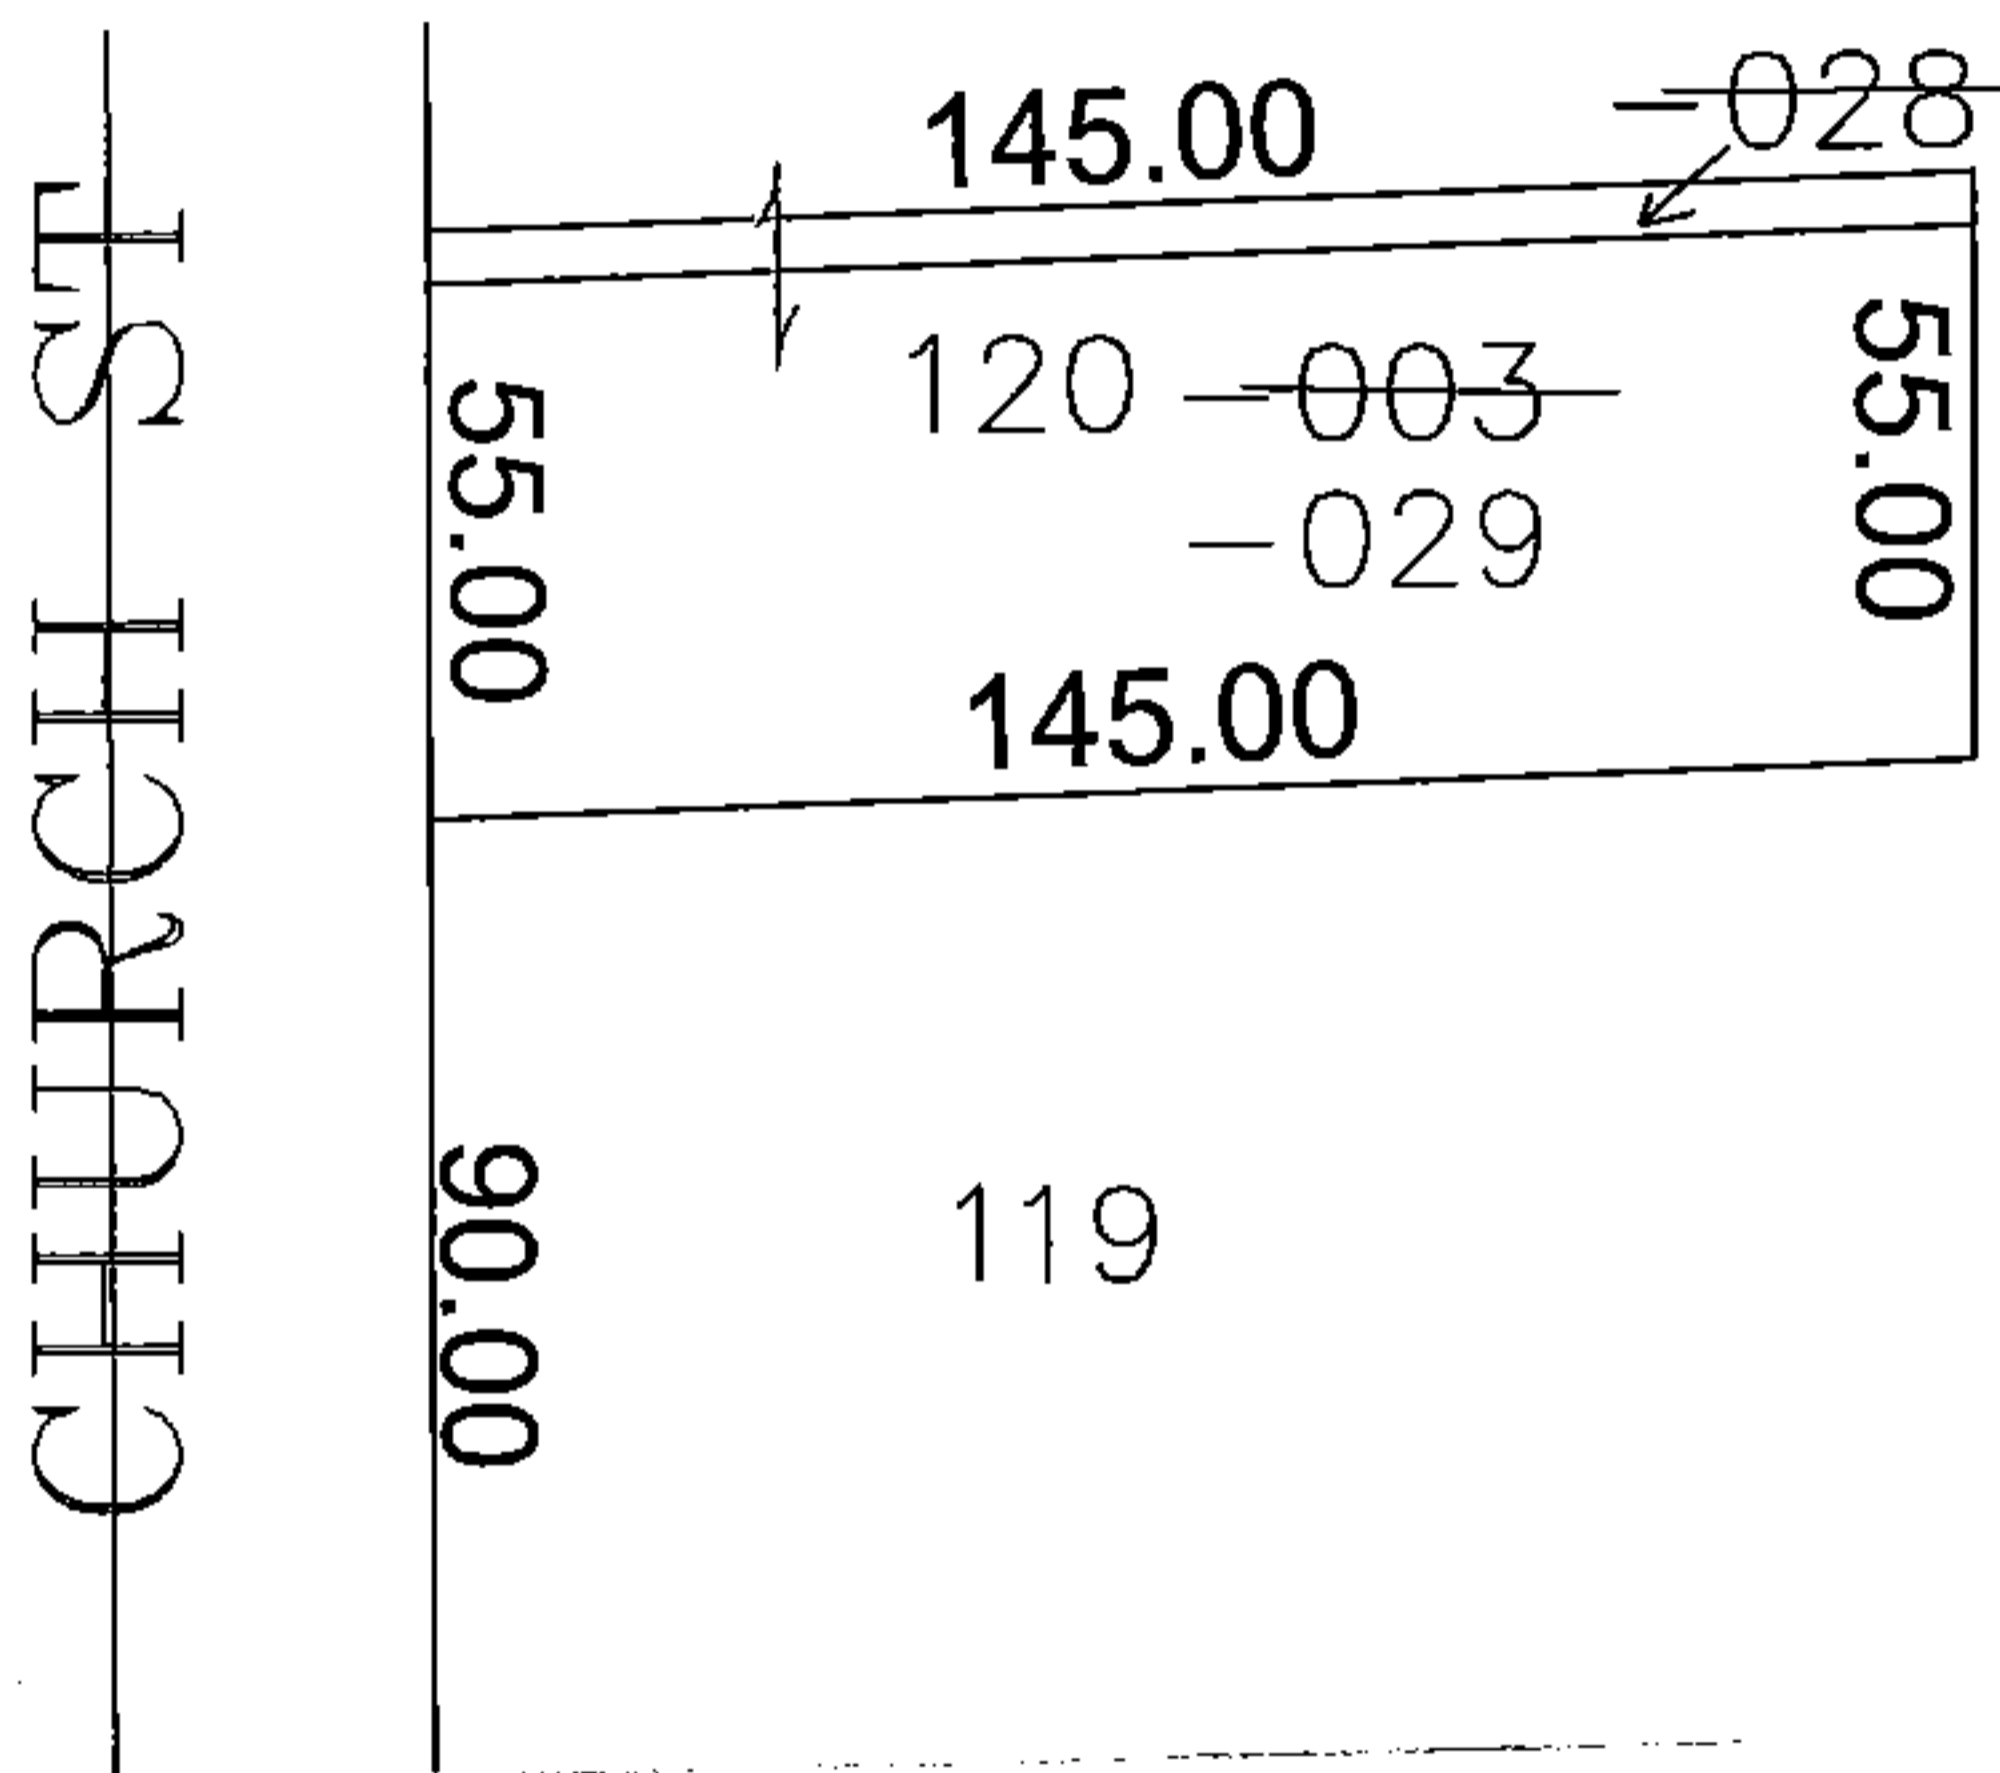


PARENT PARCEL: 05-00-024-112-03, -028  
CHILD PARCEL: 05-00-024-112-029  
STARTING POINT: SIDELINE OF CHURCH ST & SOUTHWEST CORNER OF SUBLOT 119

14-03283

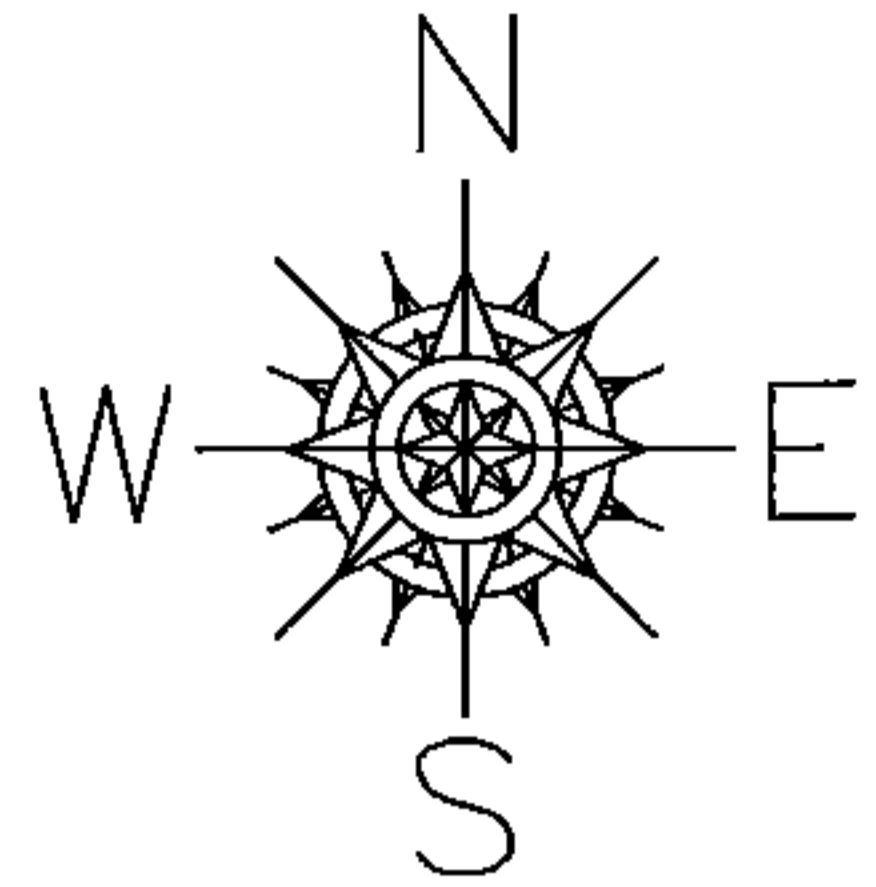

HARRIS' ADDITION  
VOL 1 PG 14

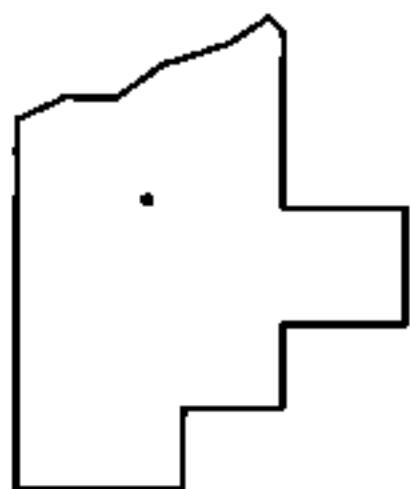

SPLITS/DEEDS PROCESSED  
LORAIN COUNTY TAX MAP DEPARTMENT  
226 MIDDLE AVE. ELYRIA, OHIO

SURVEYED BY: DALEY HAYWOOD  
CLOSURE: 0.00 : 10,000  
MAP PAGE(S): 05-00-024-B  
APPROVED BY: JAH DATE: 9/10/2014  
SCALE: 1" = 50' PRIOR INST.: 20140509401