
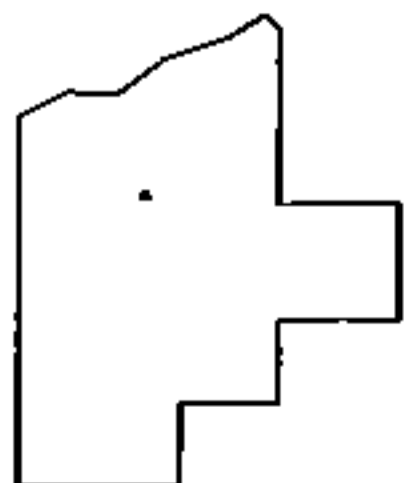
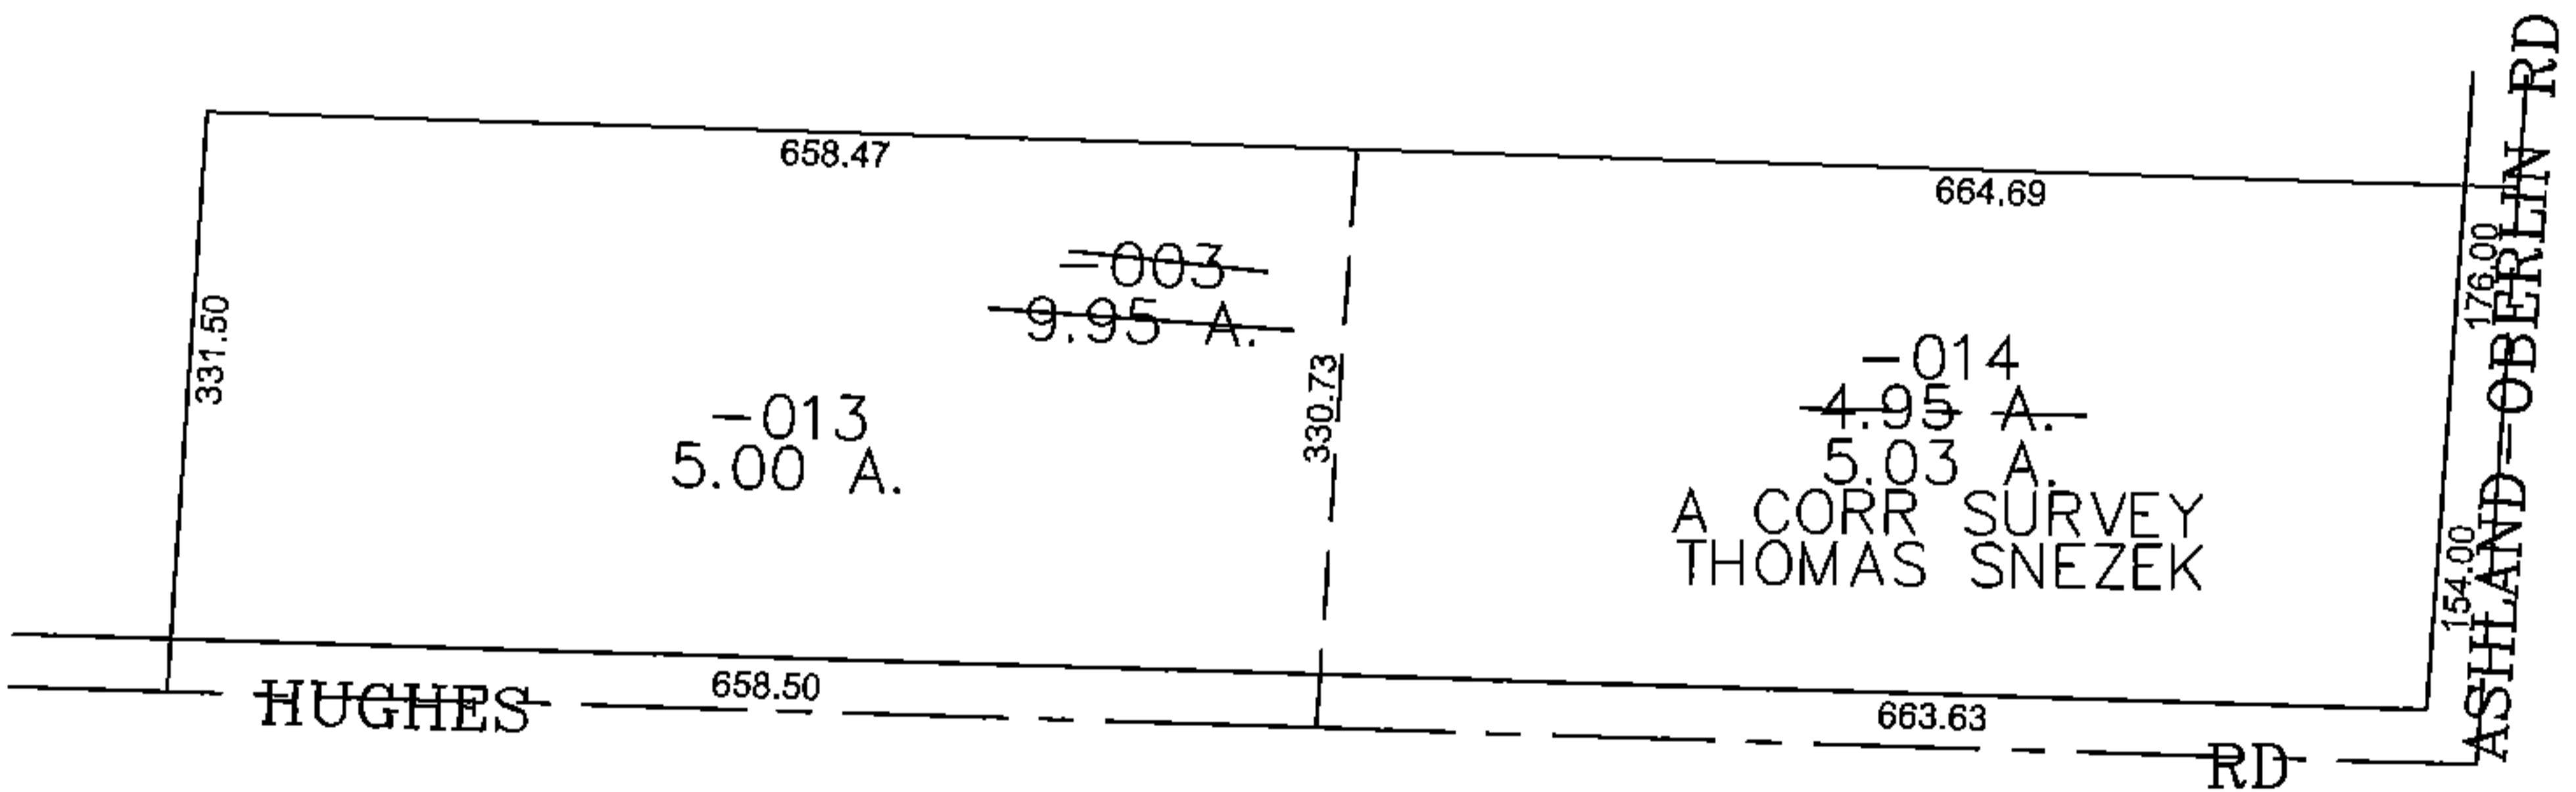


PARENT PARCEL: 14-00-046-000-003

CHILD PARCEL: 14-00-046-000-013, -014

STARTING POINT: CENTERLINE OF HUGHES RD & ASHLAND-OBERLIN RD

14-03284

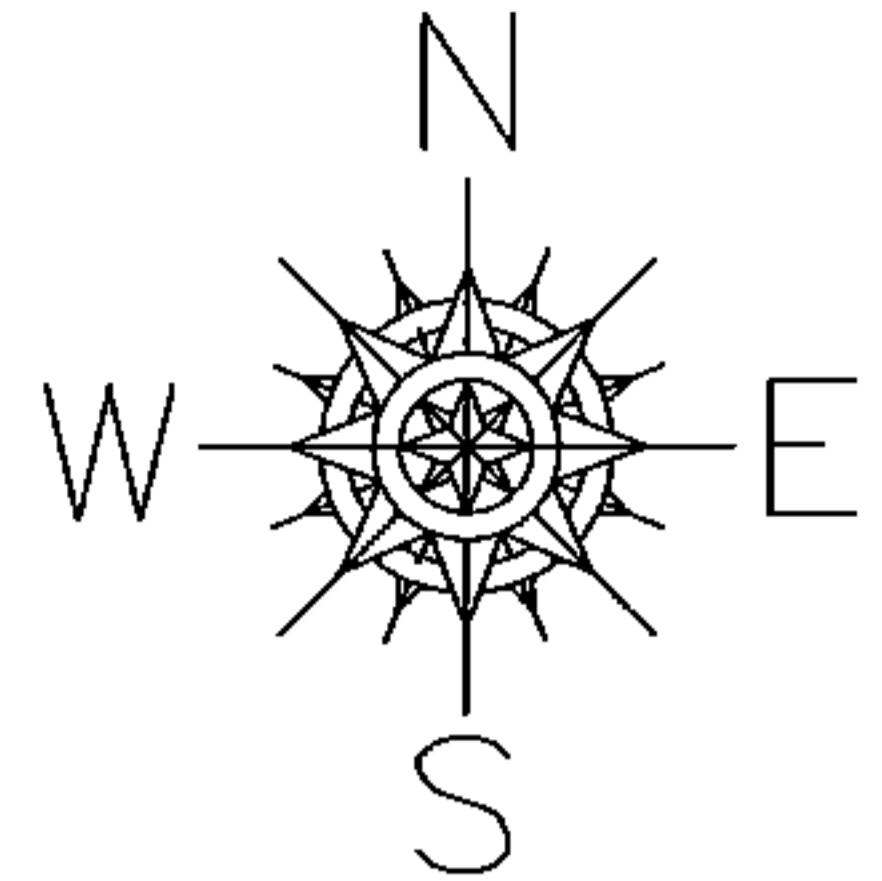

SPLITS/DEEDS PROCESSED
 LORAIN COUNTY TAX MAP DEPARTMENT
 226 MIDDLE AVE. ELYRIA, OHIO

SURVEYED BY: THOMAS SNEZEK
 CLOSURE: 0.00 : 10,000
 MAP PAGE(S): 14-B
 APPROVED BY: JAH DATE: 9/11/2014
 SCALE: 1" = 200' PRIOR INSTRUMENT: 20120430937