


PARENT PARCEL: 11-00-049-000-016


CHILD PARCEL:

15-03285-X

STARTING POINT: SOUTHWEST CORNER OF LAND CONVEYED TO FRANK J. & ANNA SCHUSTER (DV 228/88)

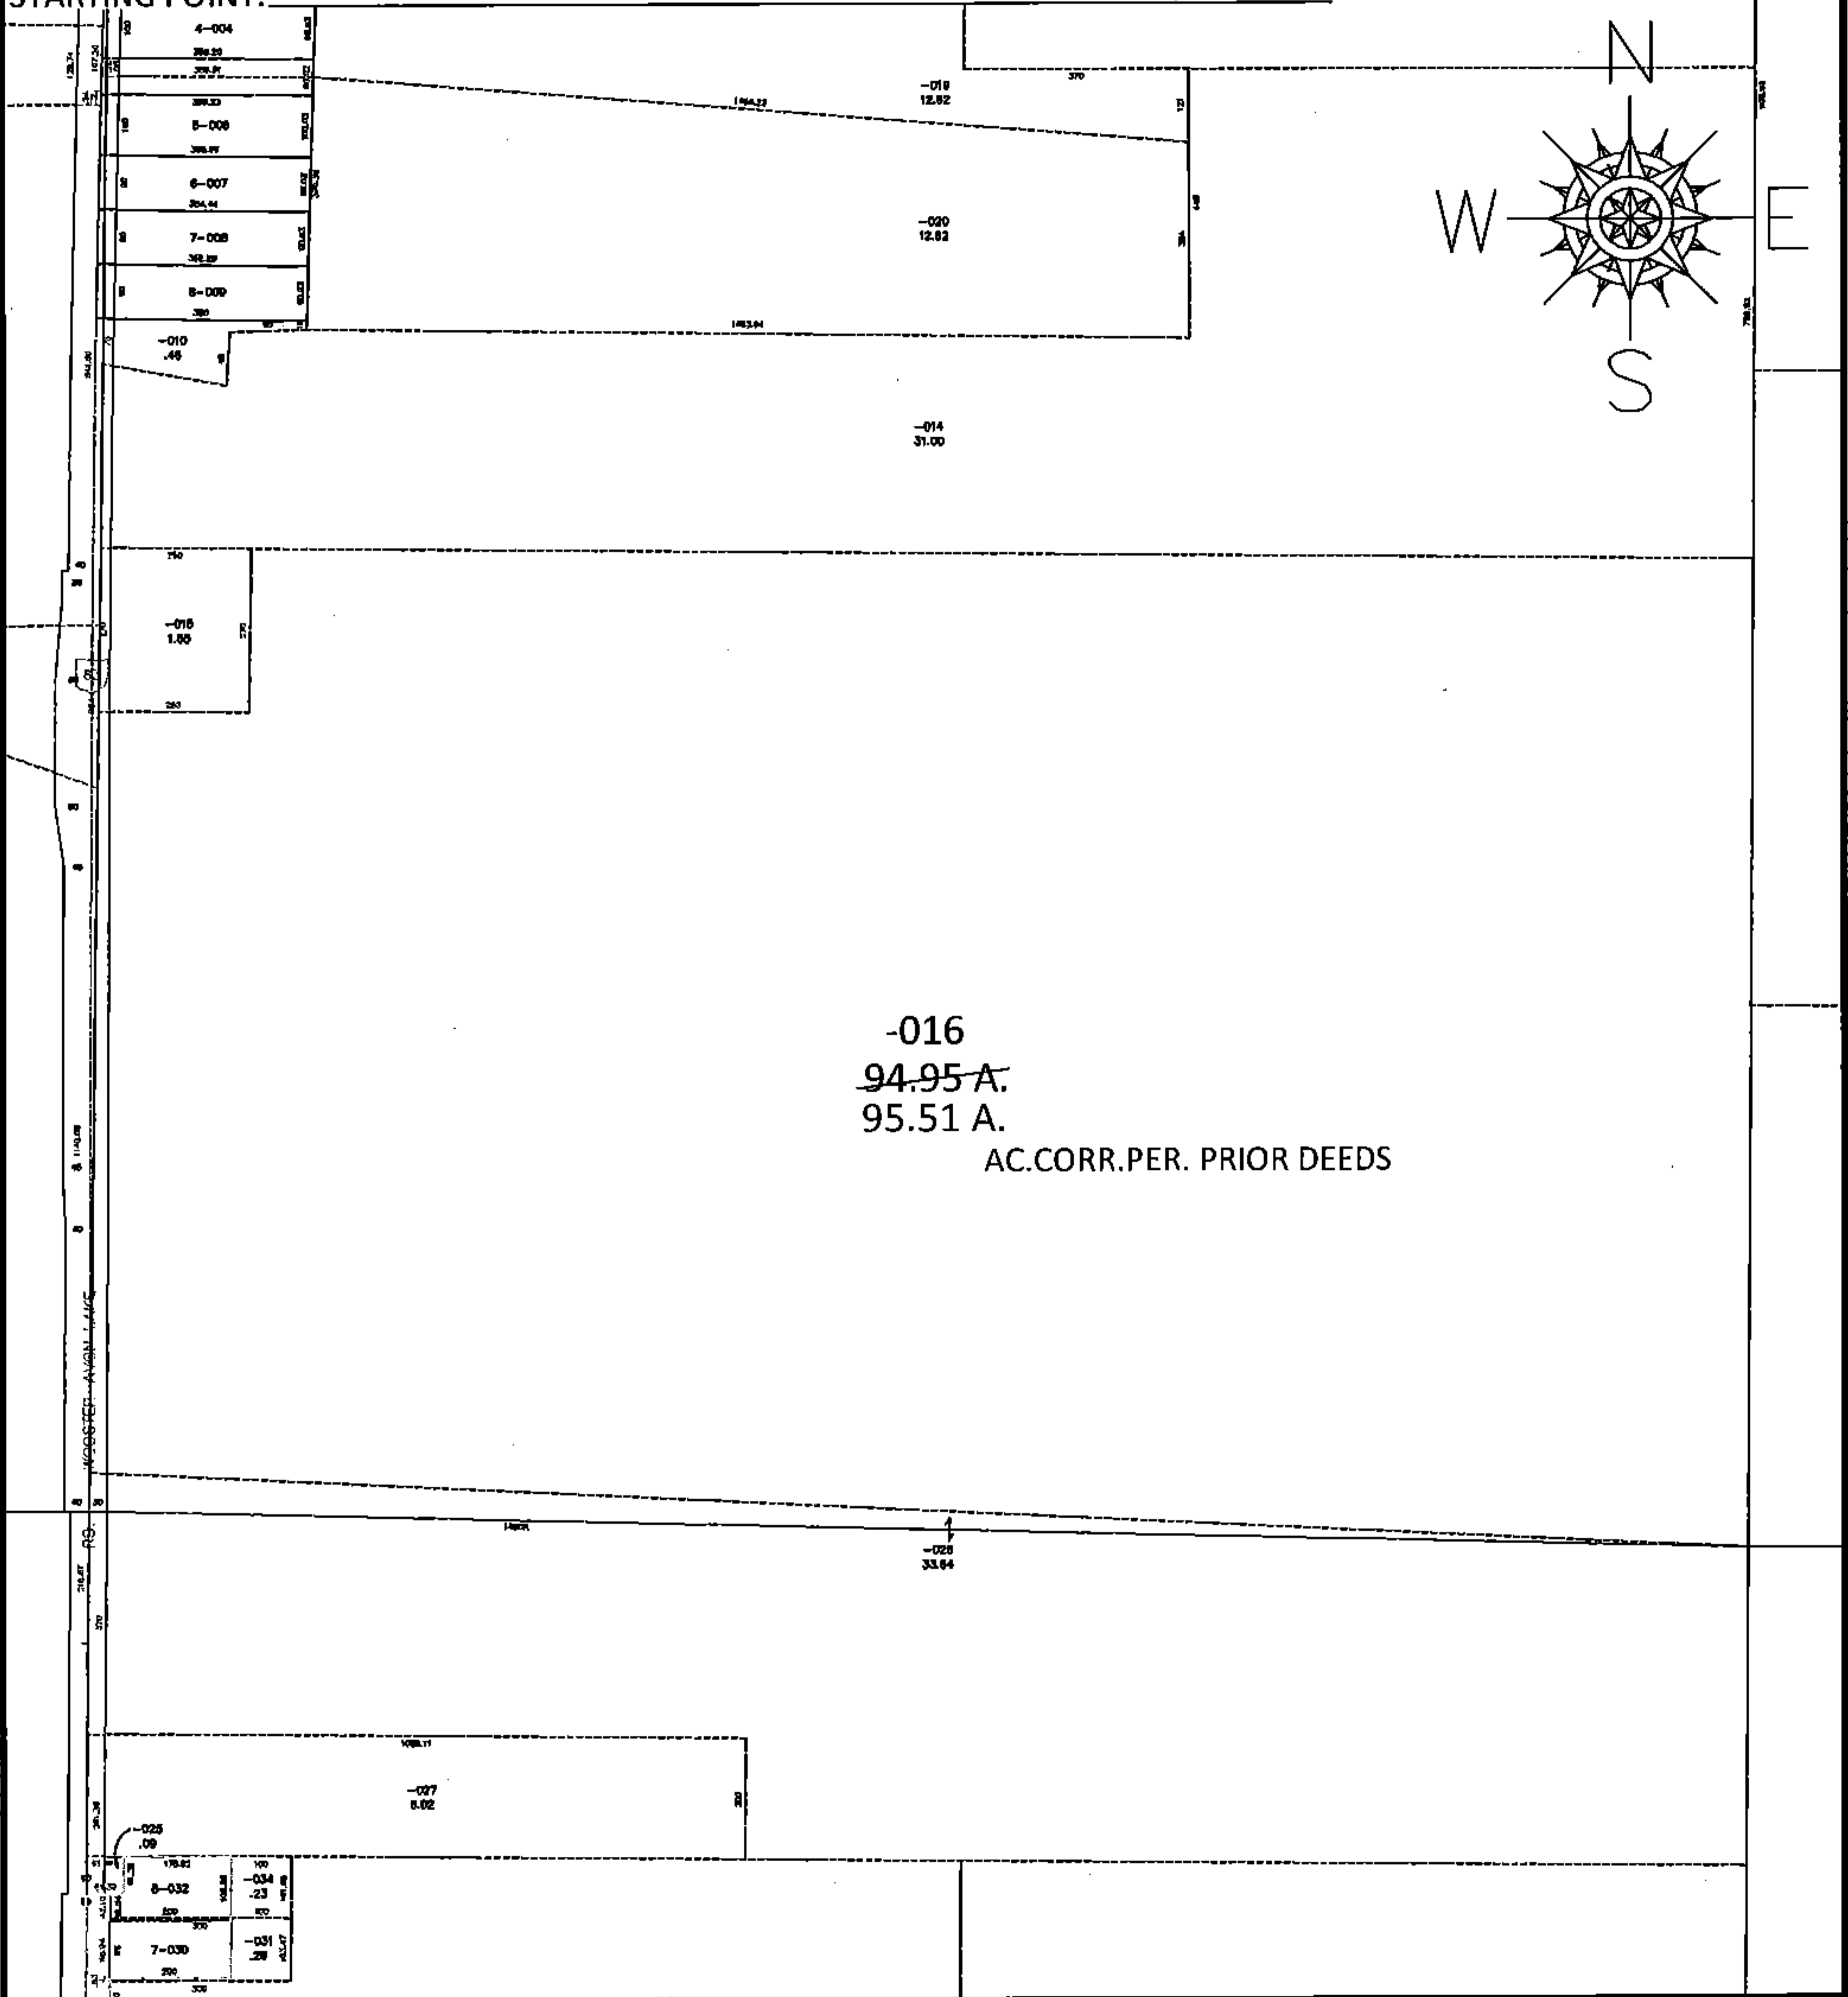

-016
~~94.95 A.~~
 95.51 A.
 AC.CORR.PER. PRIOR DEEDS

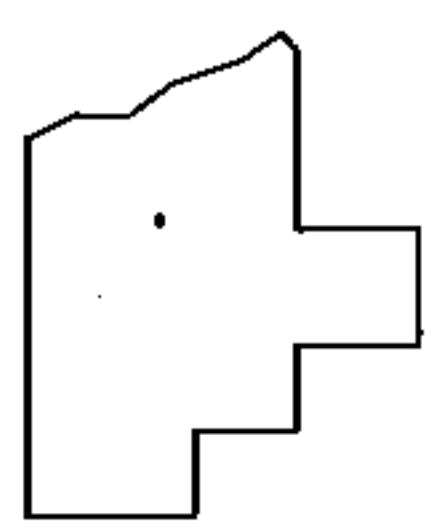

SPLITS/DEEDS PROCESSED

LORAIN COUNTY TAX MAP DEPARTMENT
 226 MIDDLE AVE. ELYRIA, OHIO

SURVEYED BY: N/A
 CLOSURE: N/A
 MAP PAGE(S): 11-00-049-A
 APPROVED BY: RRM DATE: 9-2-15
 SCALE: 1"= 400 PRIOR INST.: 20030899687