


PARENT PARCEL: 06-25-007-000-033



CHILD PARCEL: 06-25-007-000-261, -262

STARTING POINT: CENTERLINE OF EAST BROAD ST & SUGAR LANE

14-03286

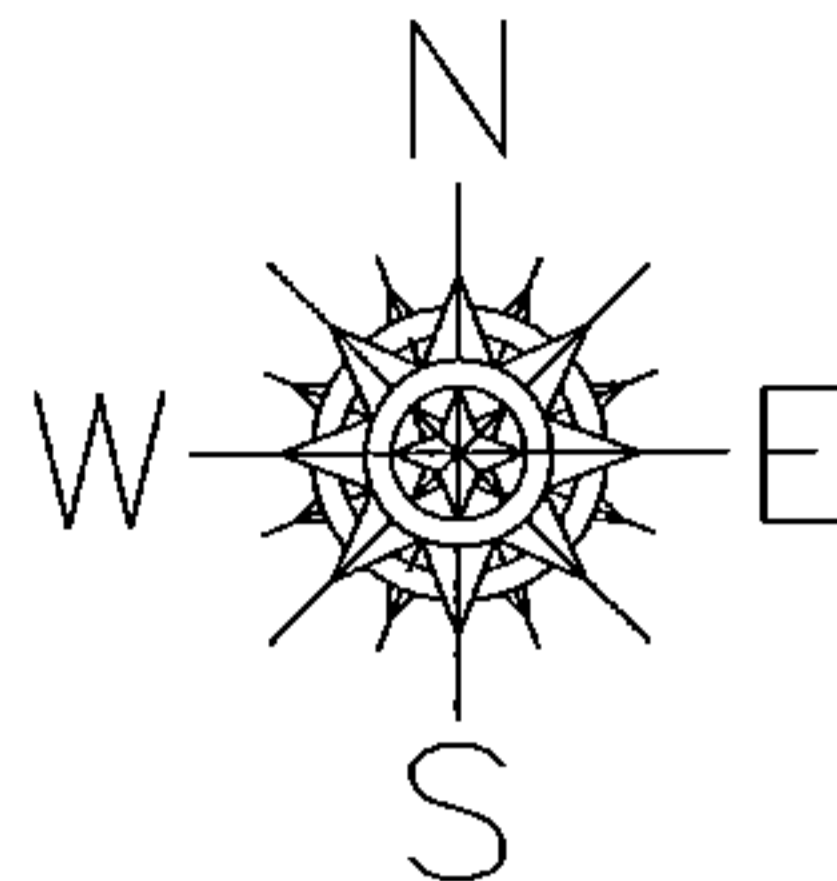

EAST BROAD ST

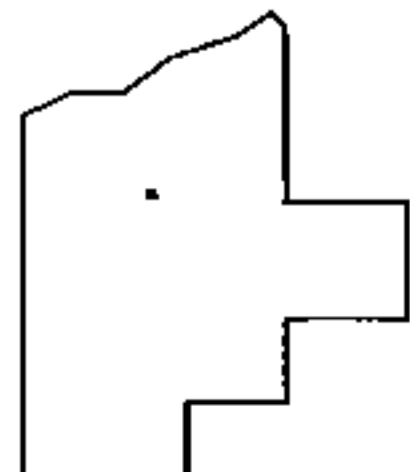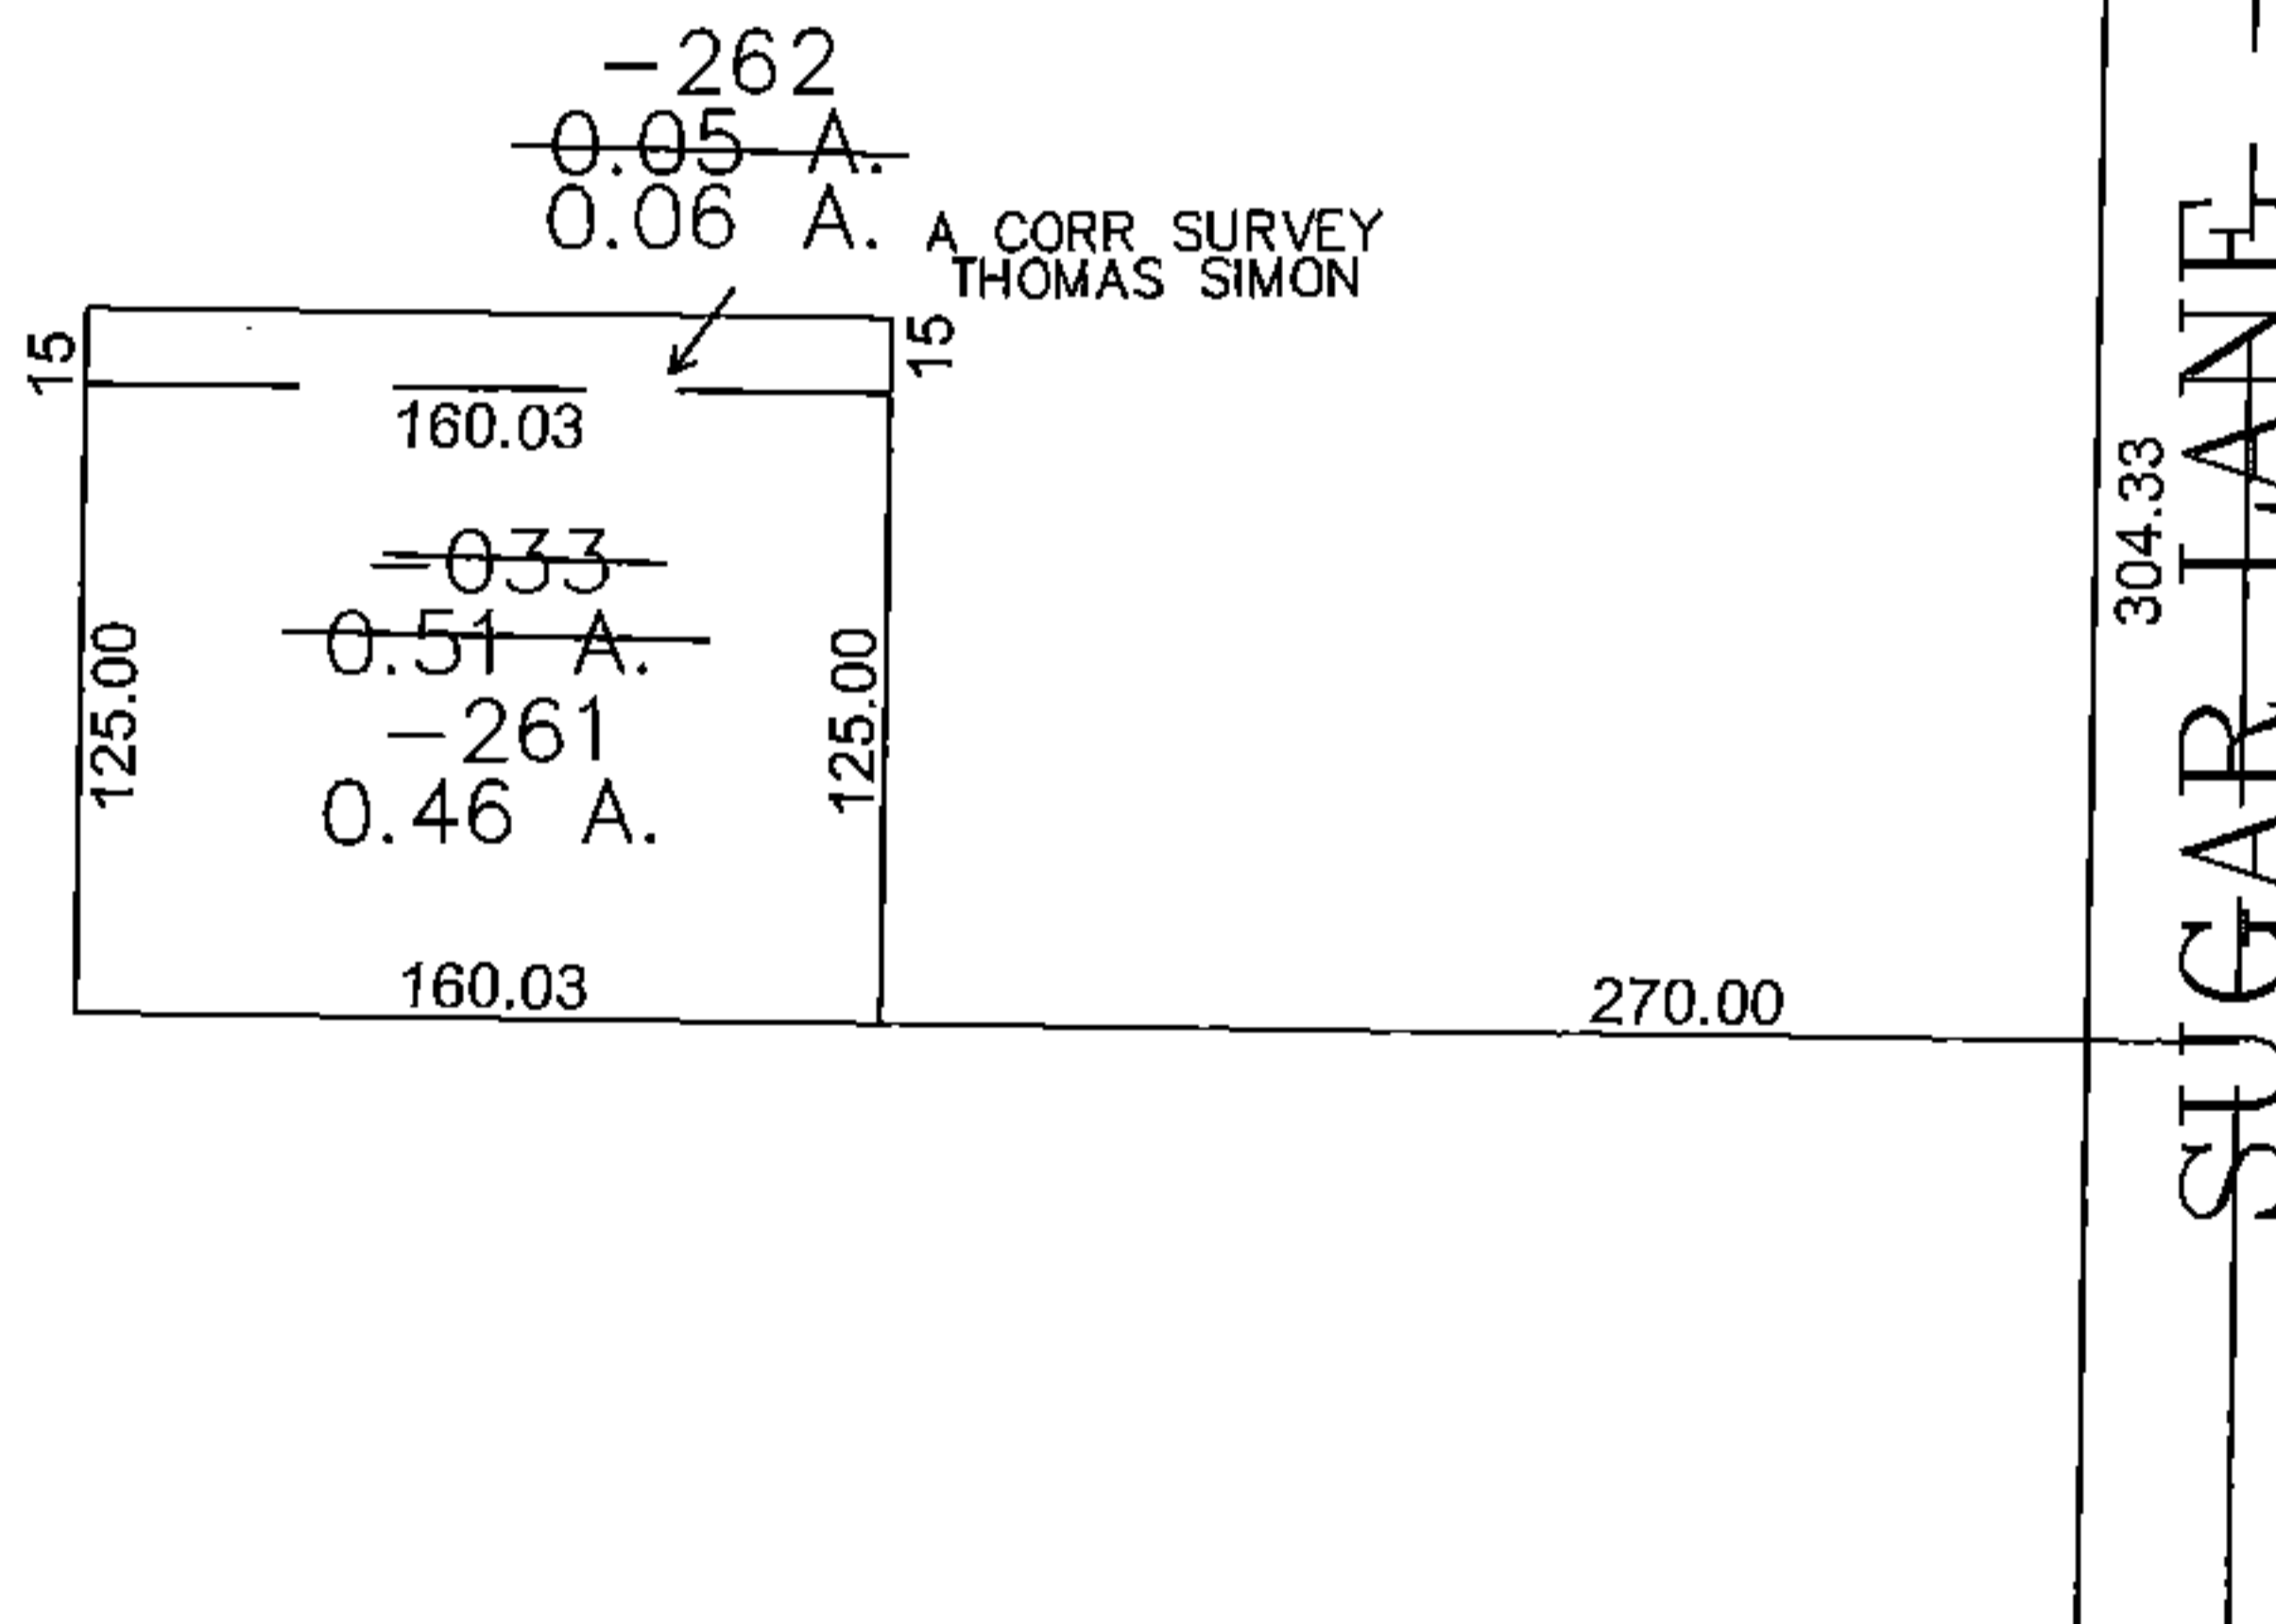

SPLITS/DEEDS PROCESSED

LORAIN COUNTY TAX MAP DEPARTMENT
226 MIDDLE AVE. ELYRIA, OHIO

SURVEYED BY: THOMAS SIMON

CLOSURE: 0.00 : 10,000

MAP PAGE(S): 6-125

APPROVED BY: JAH DATE: 9/11/2014

SCALE: 1" = 100 PRIOR INSTRUMENT: DV 951/74