
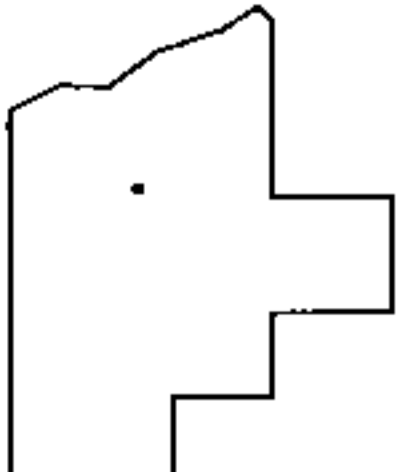


PARENT PARCEL: 14-00-122-000-013

CHILD PARCEL: 14-00-122-000-014, -015

STARTING POINT: CENTERLINE OF WEST RD & O.L. 122

14-03291

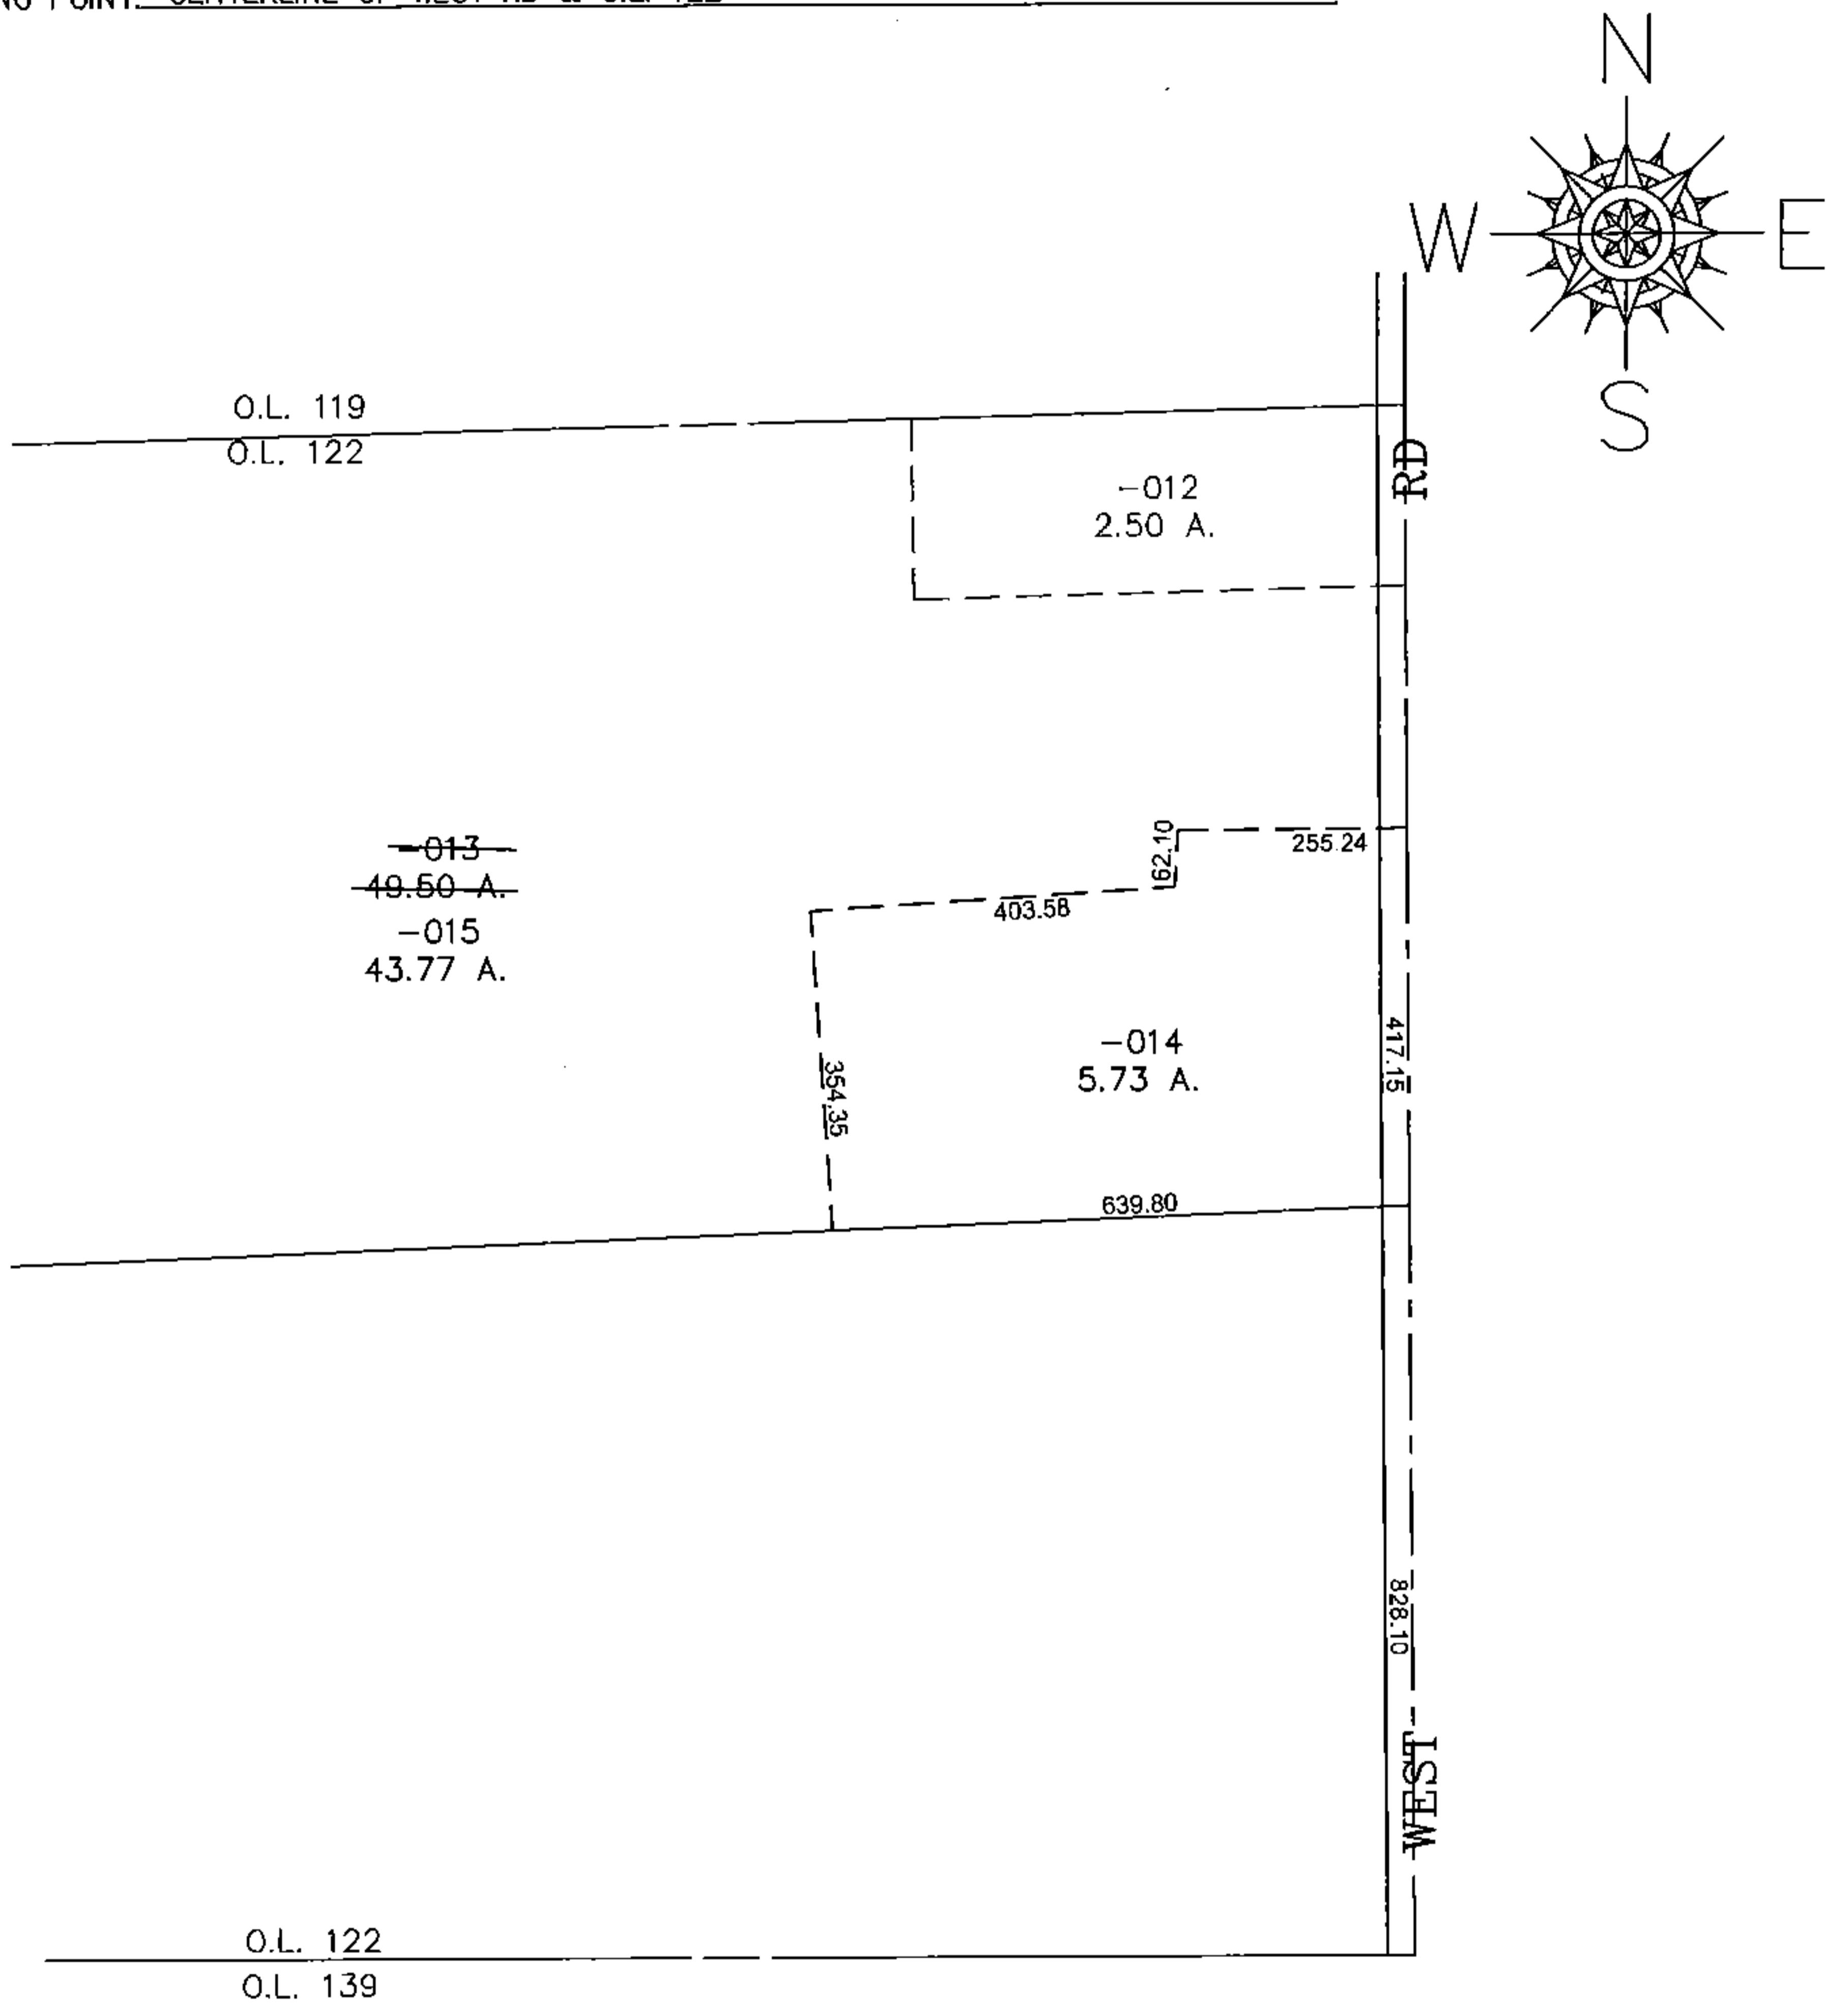

**SPLITS/DEEDS PROCESSED**  
 LORAIN COUNTY TAX MAP DEPARTMENT  
 226 MIDDLE AVE. ELYRIA, OHIO

SURVEYED BY: RICHARD CARLSON  
 CLOSURE: 0.00 : 10.000  
 MAP PAGE(S): 14-H  
 APPROVED BY: JAH DATE: 9/25/2014  
 SCALE: 1" = 300' PRIOR INSTRUMENT: 20140491321