
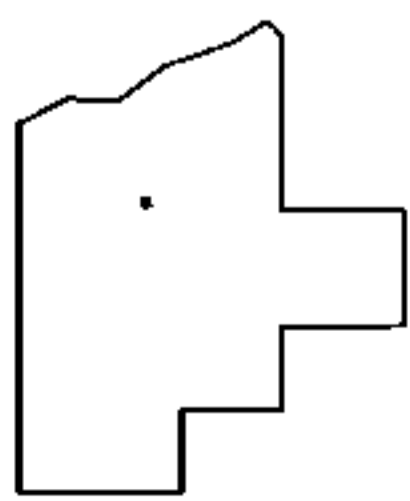
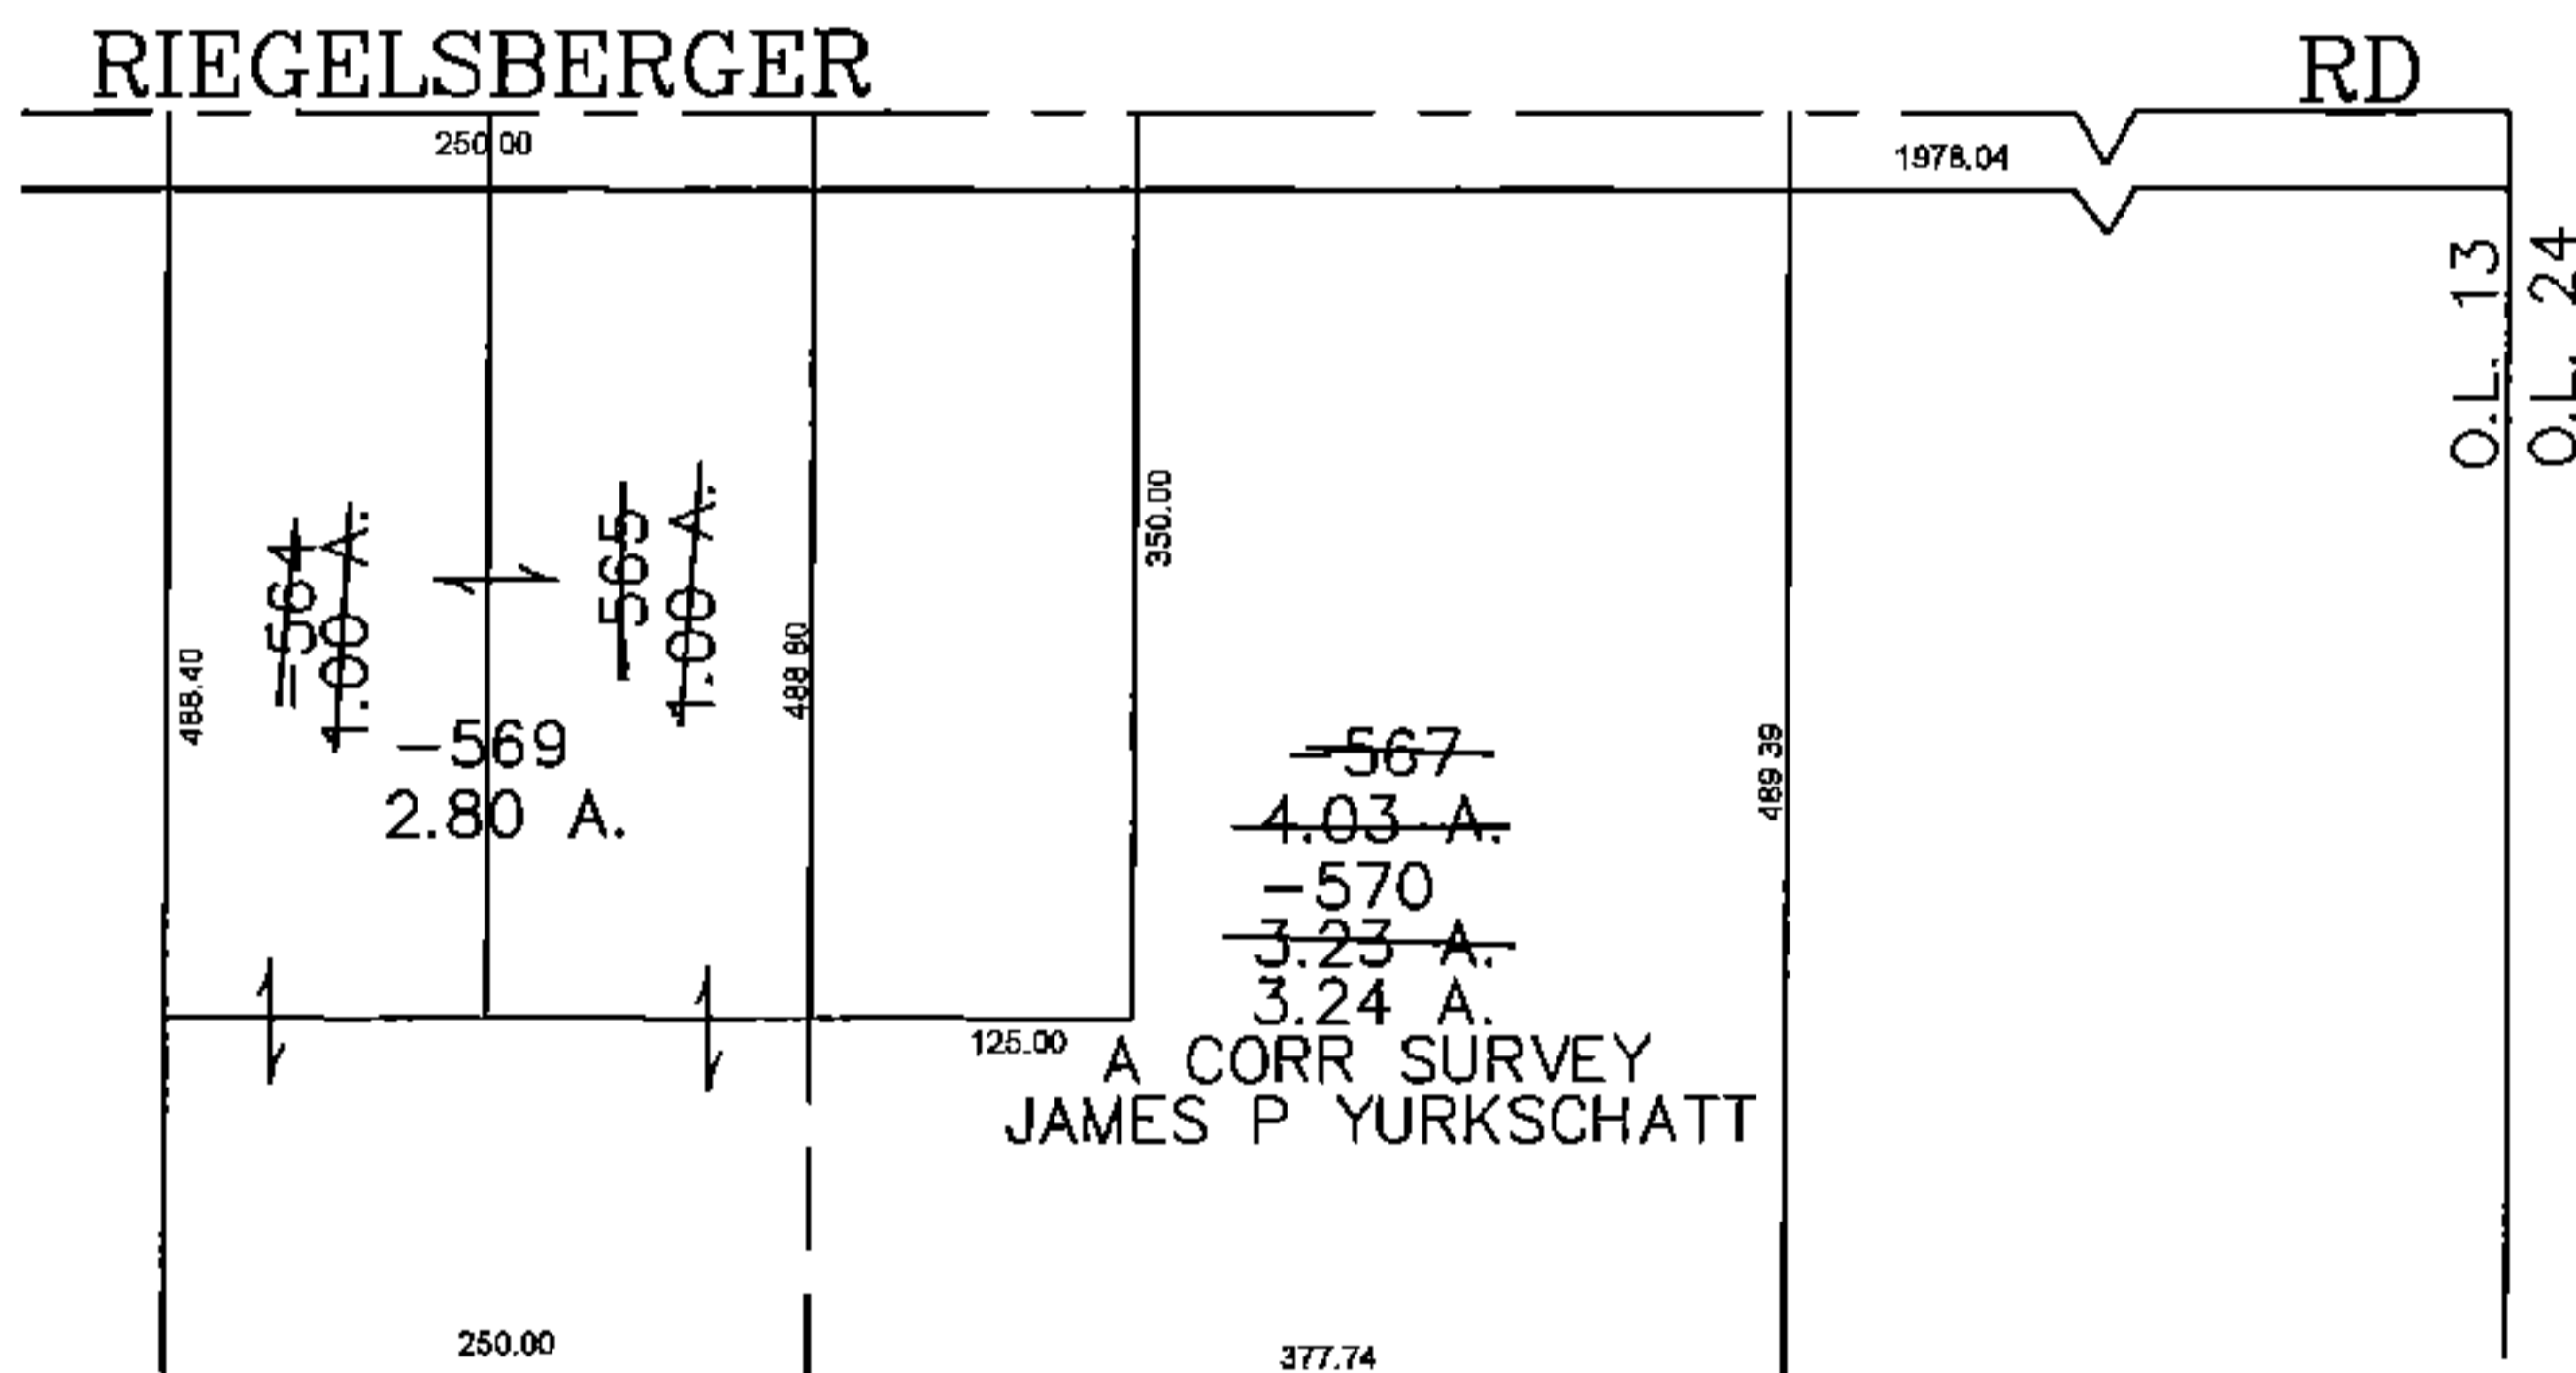


PARENT PARCEL: 04-00-013-000-564, -565, -567

CHILD PARCEL: 04-00-013-000-569, -570

STARTING POINT: CENTERLINE OF RIEGELSBERGER RD & O.L. 13

14-03292

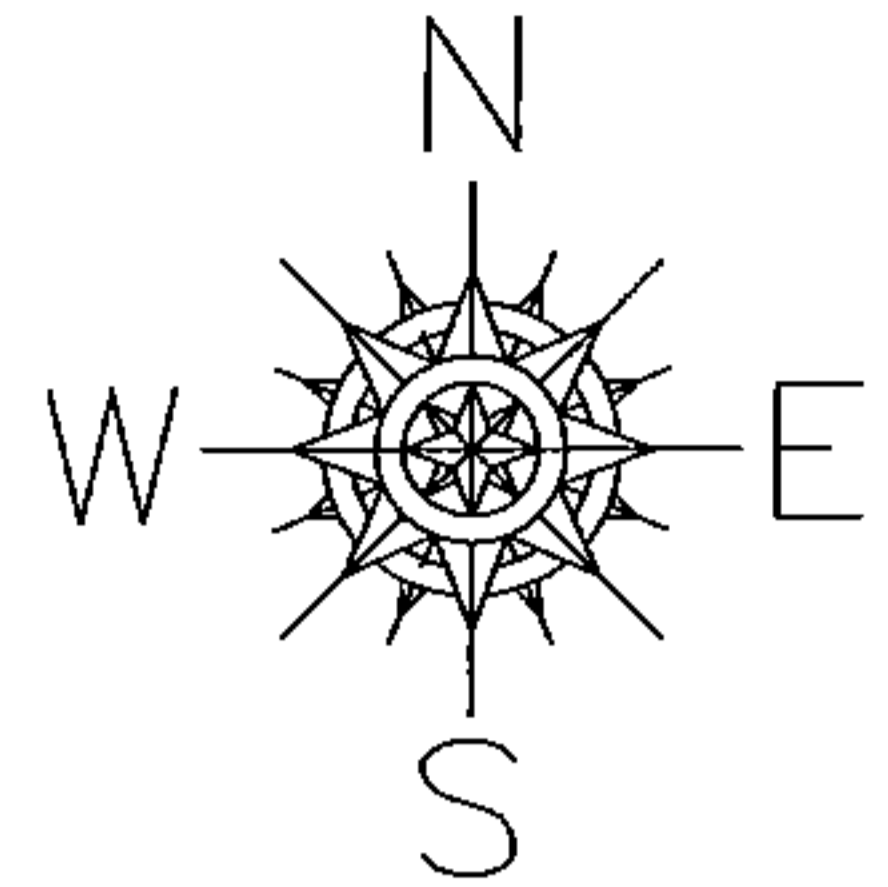

SPLITS/DEEDS PROCESSED
 LORAIN COUNTY TAX MAP DEPARTMENT
 226 MIDDLE AVE. ELYRIA, OHIO

SURVEYED BY: JAMES P YURKSCHATT
 CLOSURE: 0.00 : 10,000
 MAP PAGE(S): 04-00-013-C
 APPROVED BY: JAH DATE: 10/8/2014
 SCALE: 1" = 200 PRIOR INSTRUMENT: 20080250991