
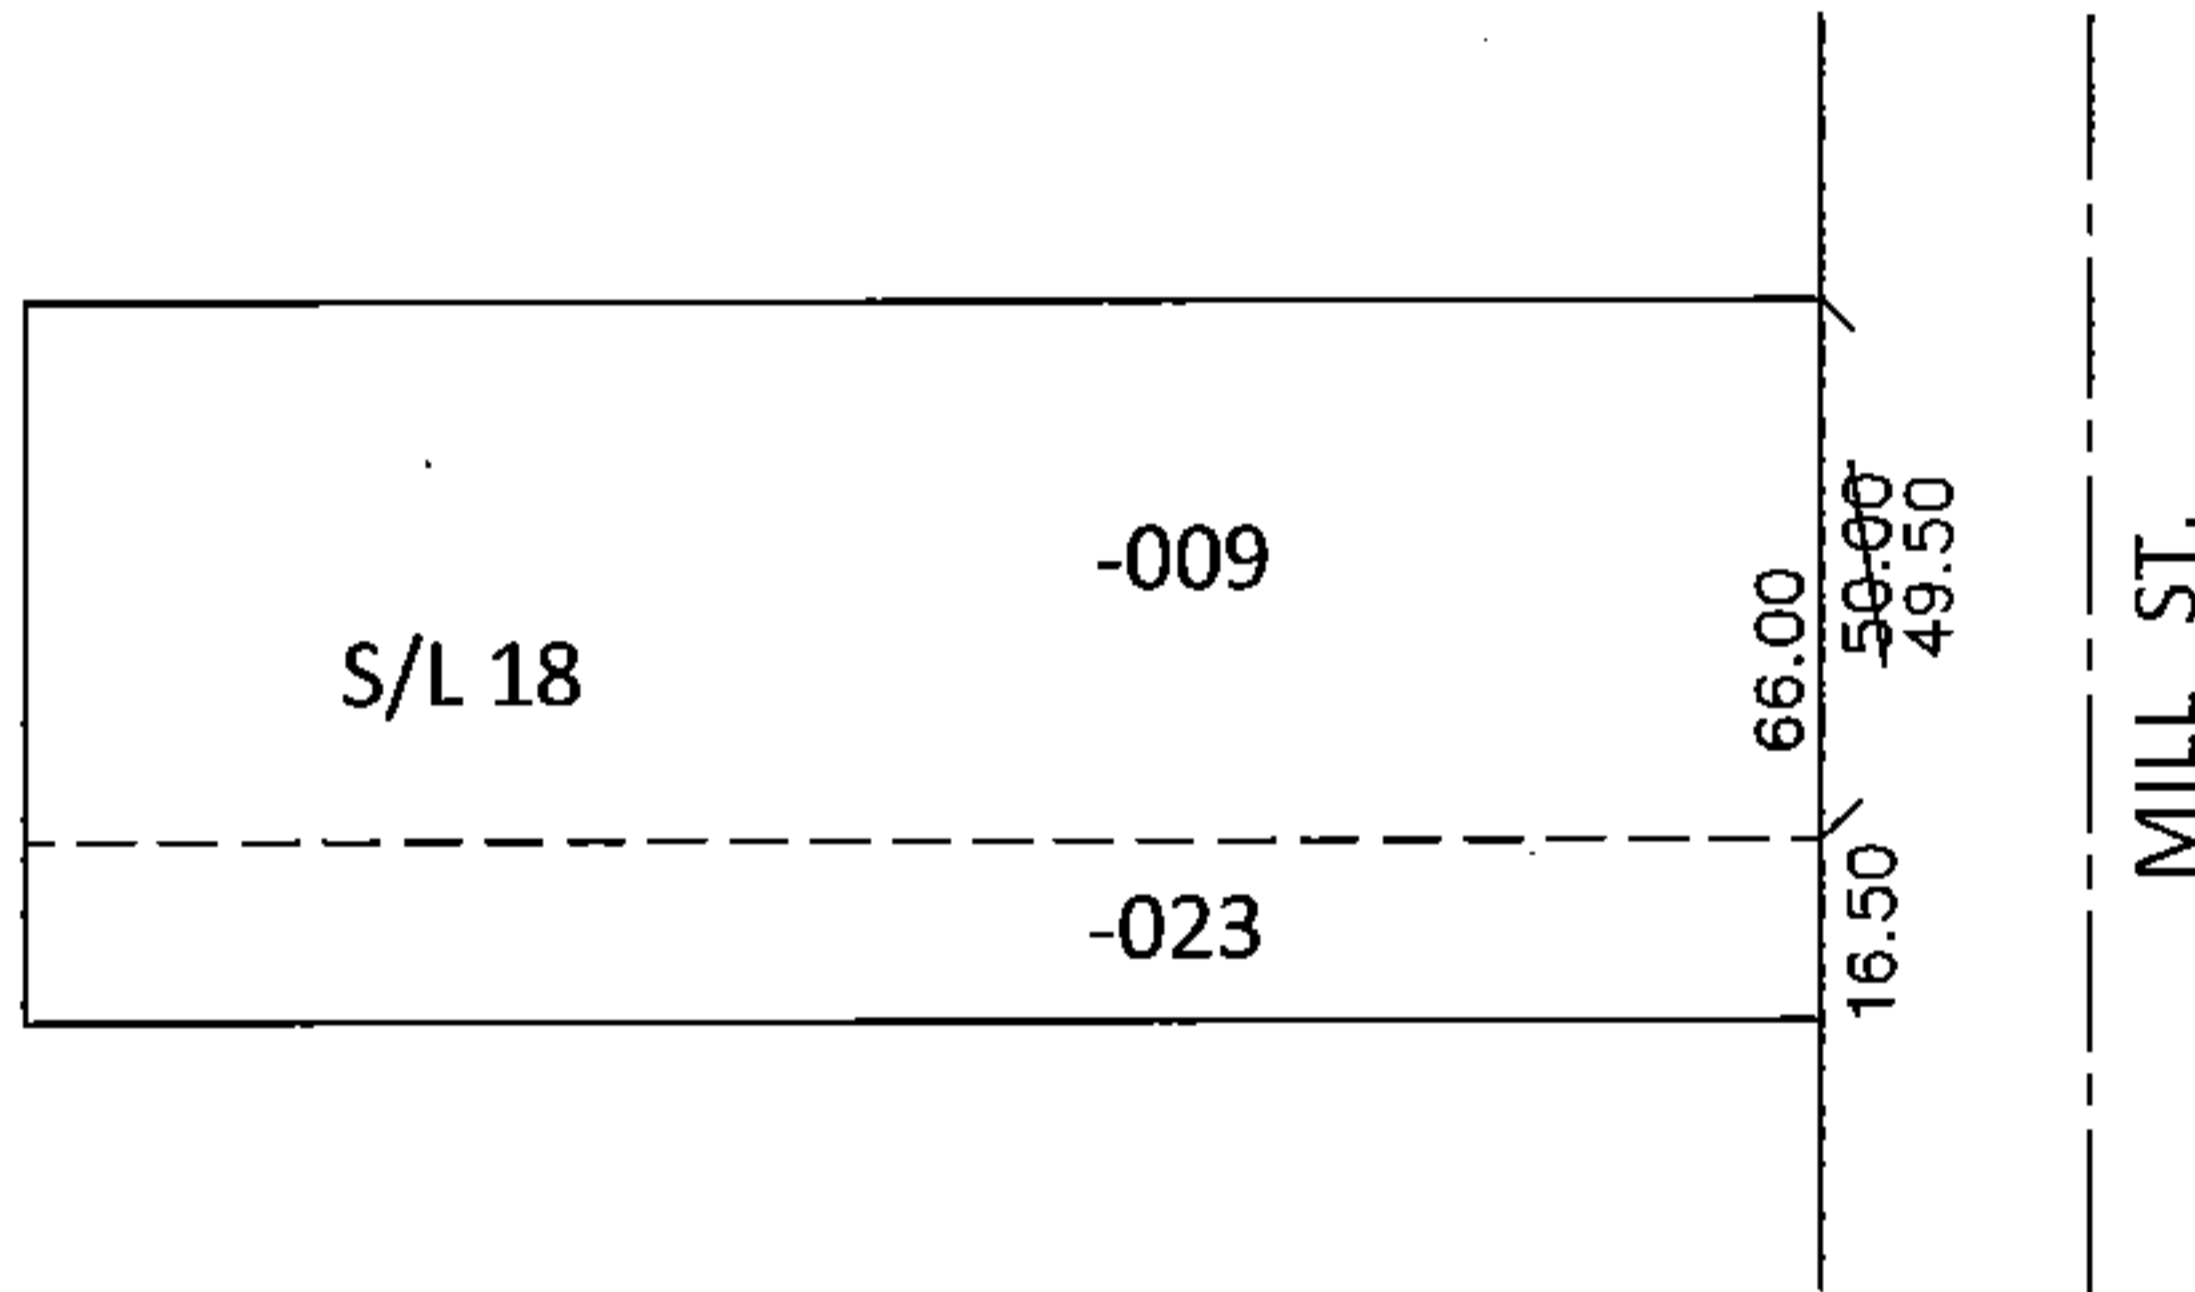


PARENT PARCEL: 18-00-027-102-009

CHILD PARCEL: _____

STARTING POINT: _____

15-03293-C

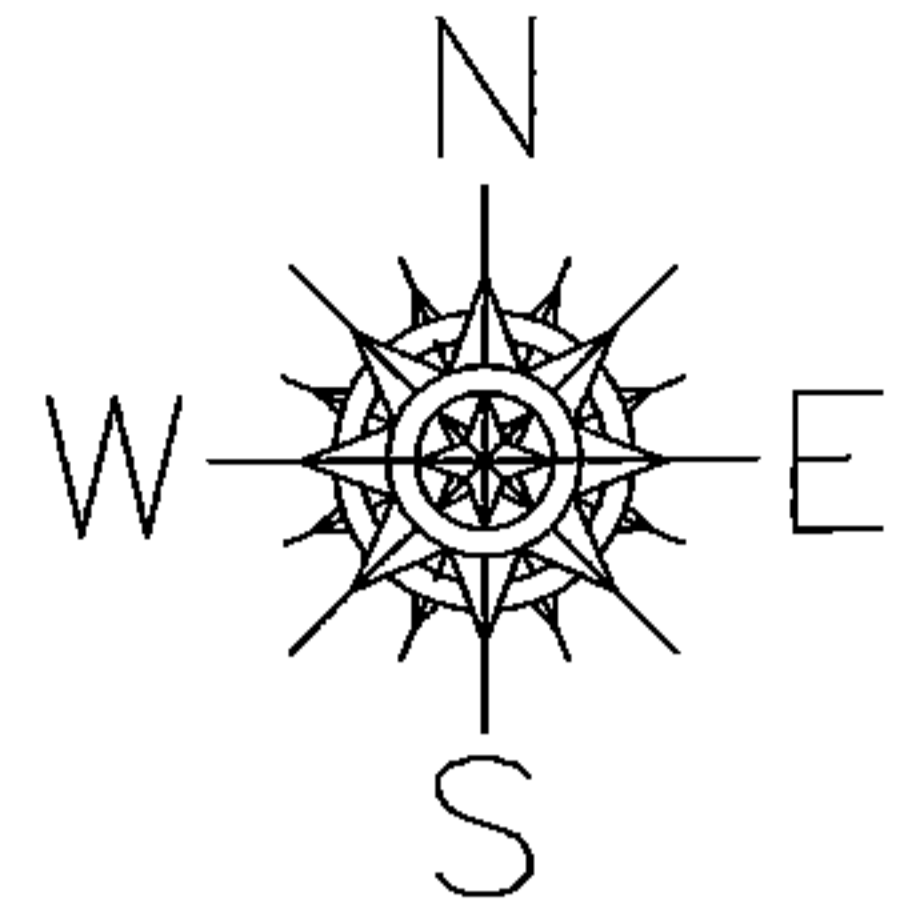


FRONTAGE CORRECTION

18-00-027-102-009

49.50

50 X 165

PER PRIOR DEEDS

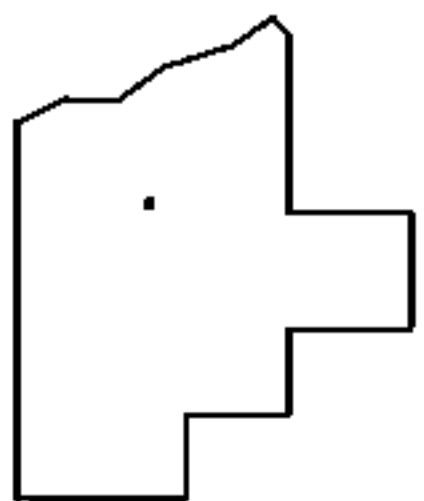

SPLITS/DEEDS PROCESSED

LORAIN COUNTY TAX MAP DEPARTMENT
226 MIDDLE AVE. ELYRIA, OHIO

SURVEYED BY: N/A

CLOSURE: N/A

MAP PAGE(S): 18-00-027-A

APPROVED BY: RRM DATE: 9-10-15

SCALE: 1"= 50' PRIOR INST.: 20150540609