
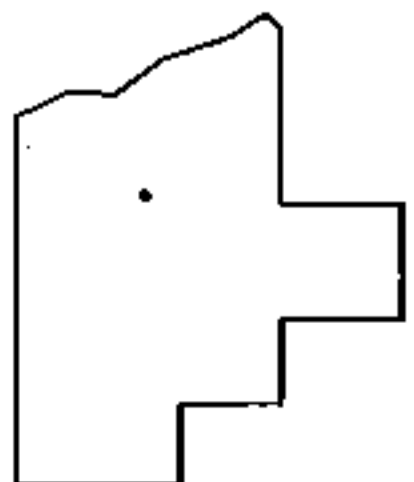
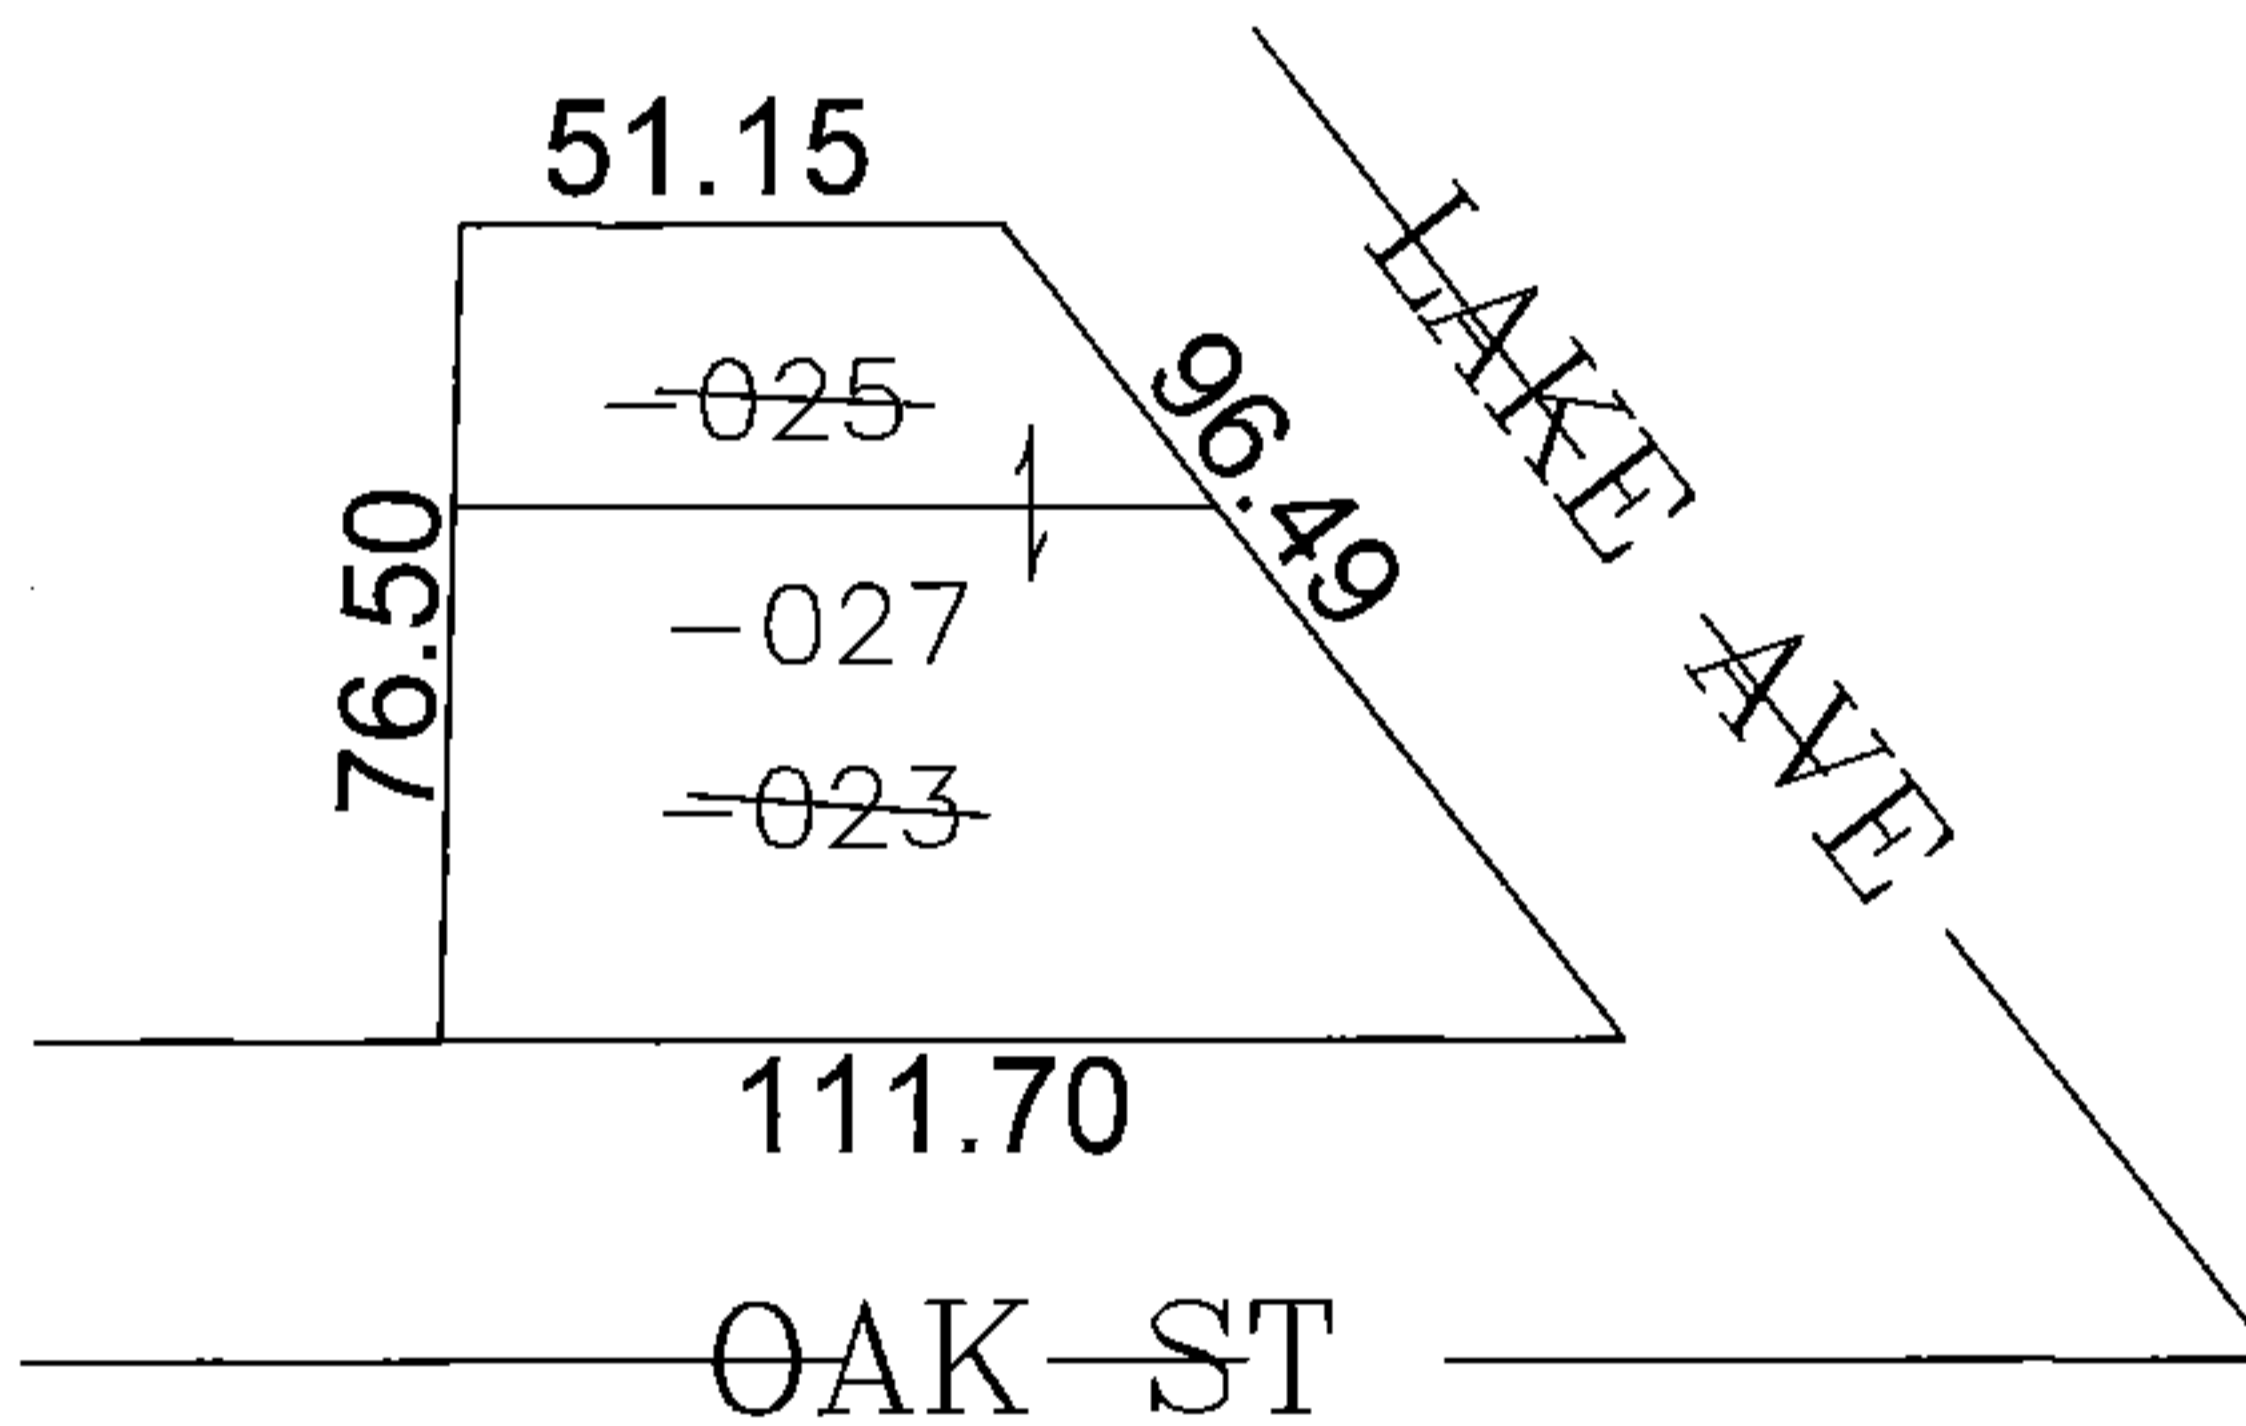


PARENT PARCEL: 06-24-083-101-023, -025

CHILD PARCEL: 06-24-083-101-027

STARTING POINT: SIDELINE OF OAK ST & LAKE AVE

14-03296

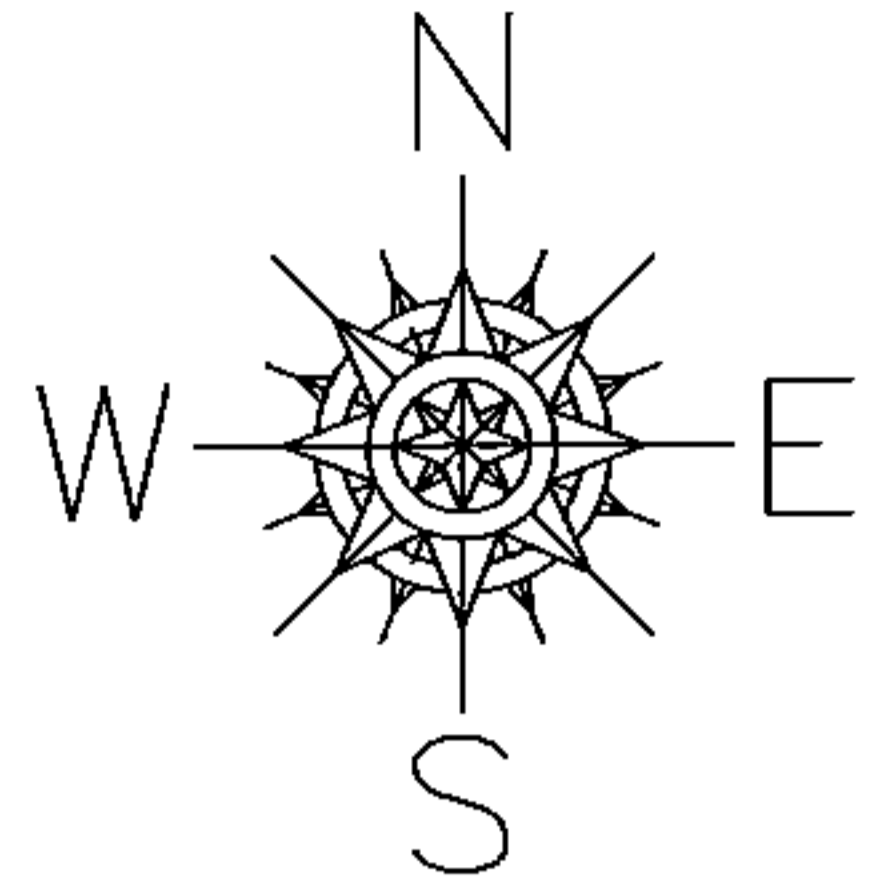

SPLITS/DEEDS PROCESSED

LORAIN COUNTY TAX MAP DEPARTMENT
226 MIDDLE AVE. ELYRIA, OHIO

SURVEYED BY: DANE HAPONEK

CLOSURE: 0.00 : 10,000

MAP PAGE(S): 6-80

APPROVED BY: JAH DATE: 10/20/2014

SCALE: 1" = 50' PRIOR INST.: 20130483653