
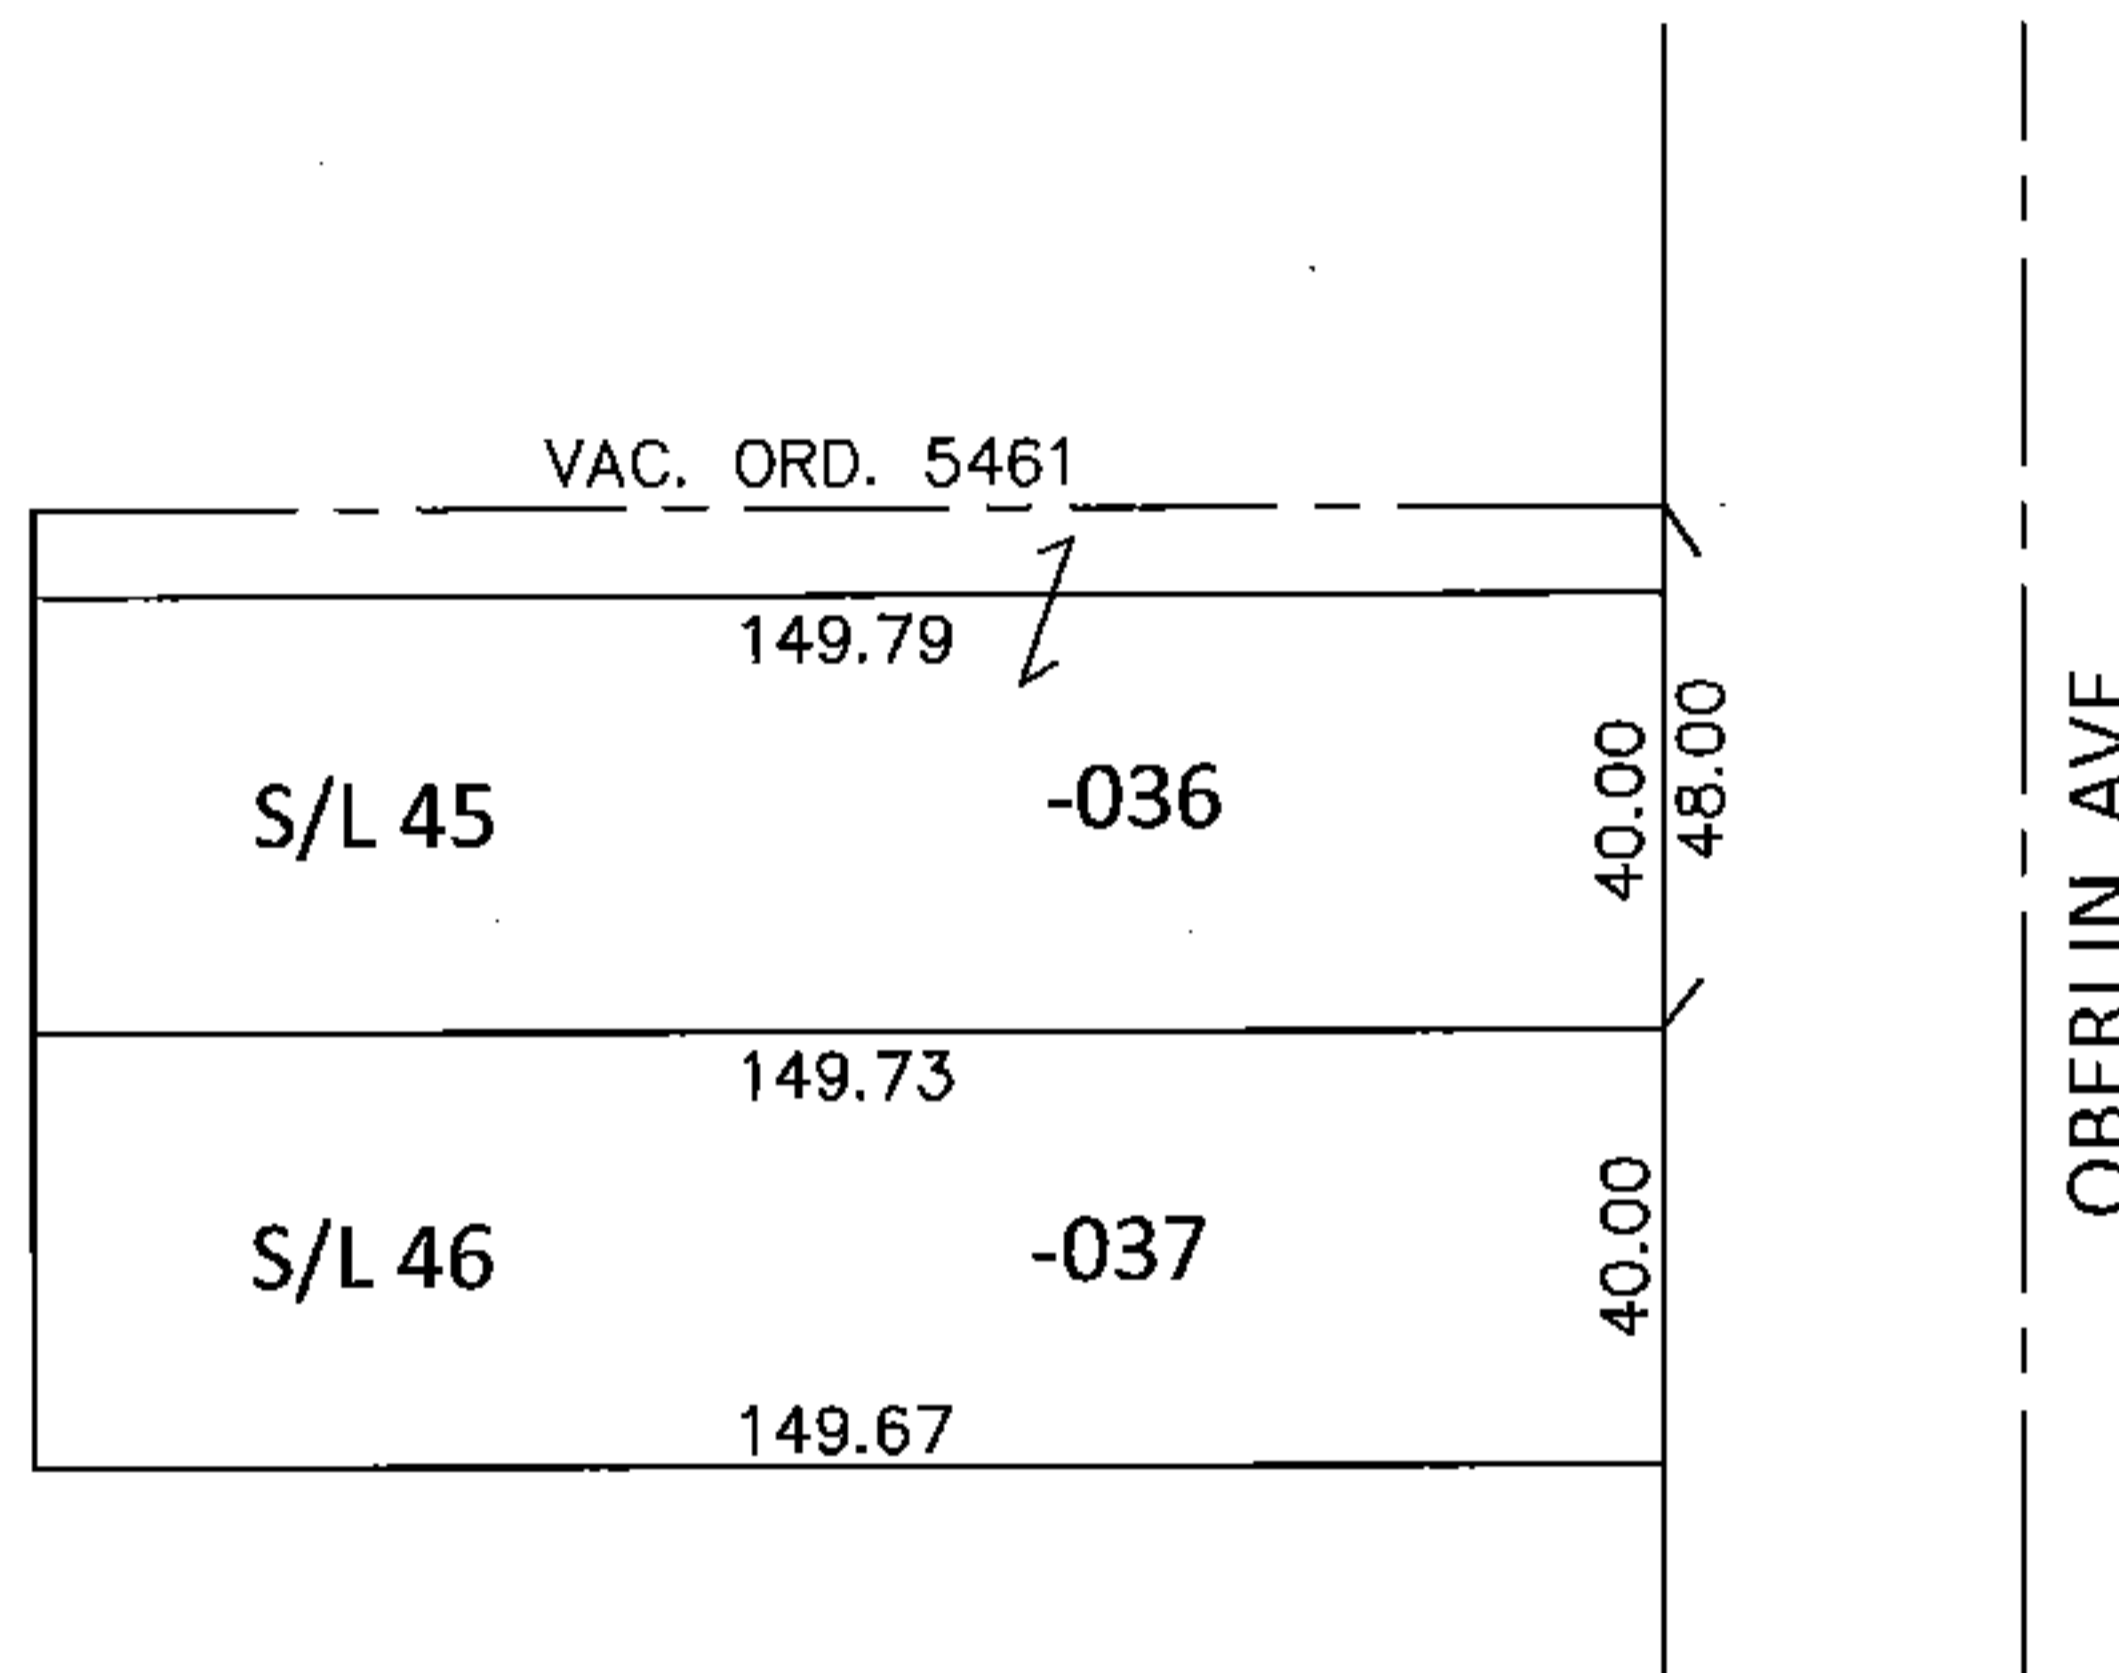


PARENT PARCEL: 02-02-016-106-036, -037

CHILD PARCEL: _____

STARTING POINT: _____

15-03297-C

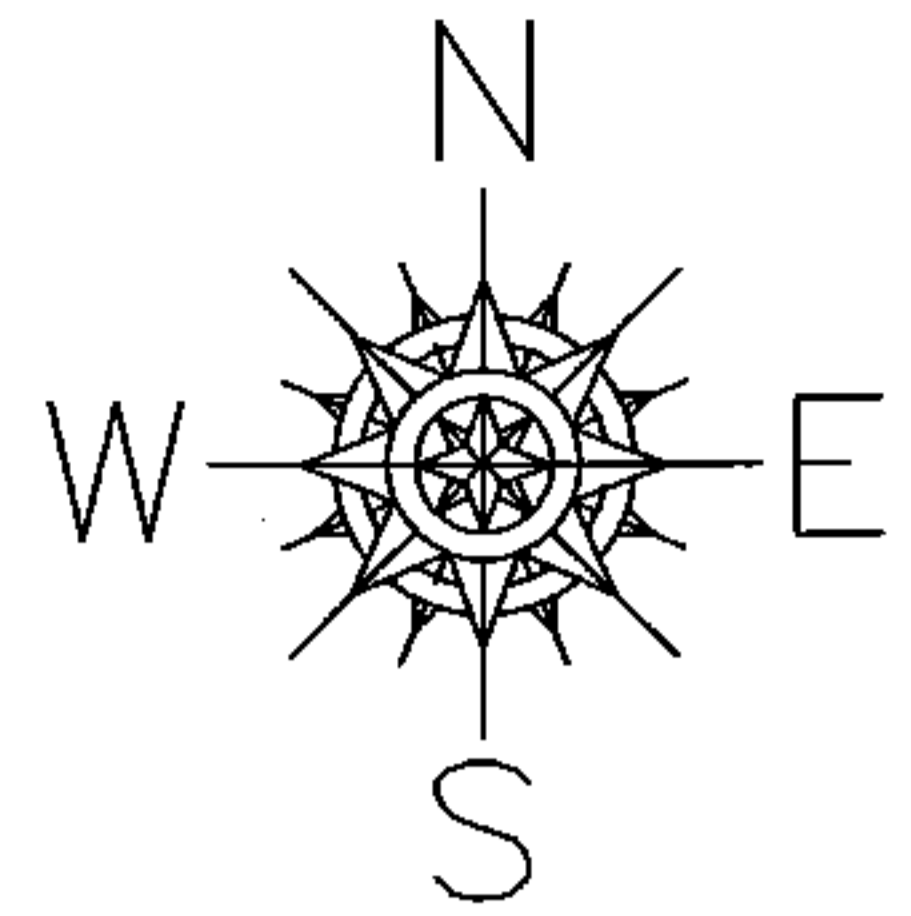


FRONTAGE & DEPTH CORRECTION

02-02-016-106-036
48 X 149.73
~~40 X 150~~

DEPTH CORRECTION

02-02-016-106-037
149.73
~~40 X 150~~

PER PRIOR DEEDS & ORD.NO. 5461

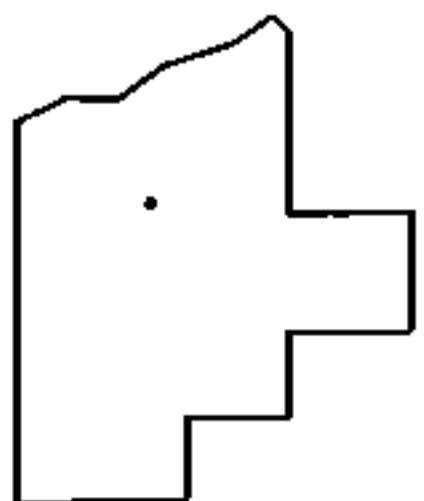

SPLITS/DEEDS PROCESSED

LORAIN COUNTY TAX MAP DEPARTMENT
226 MIDDLE AVE. ELYRIA, OHIO

SURVEYED BY: N/A

CLOSURE: N/A

MAP PAGE(S): 2-02-016-B

APPROVED BY: RRM DATE: 9-17-15

SCALE: 1"= 50' PRIOR INST.: 20140517019