
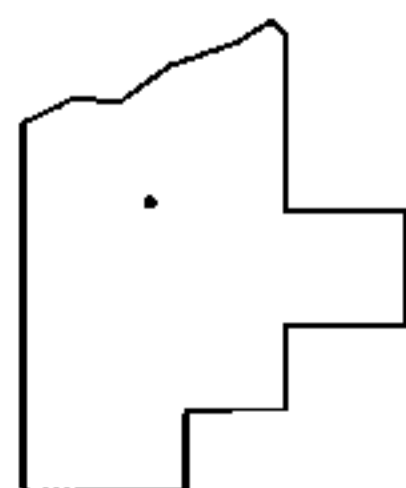
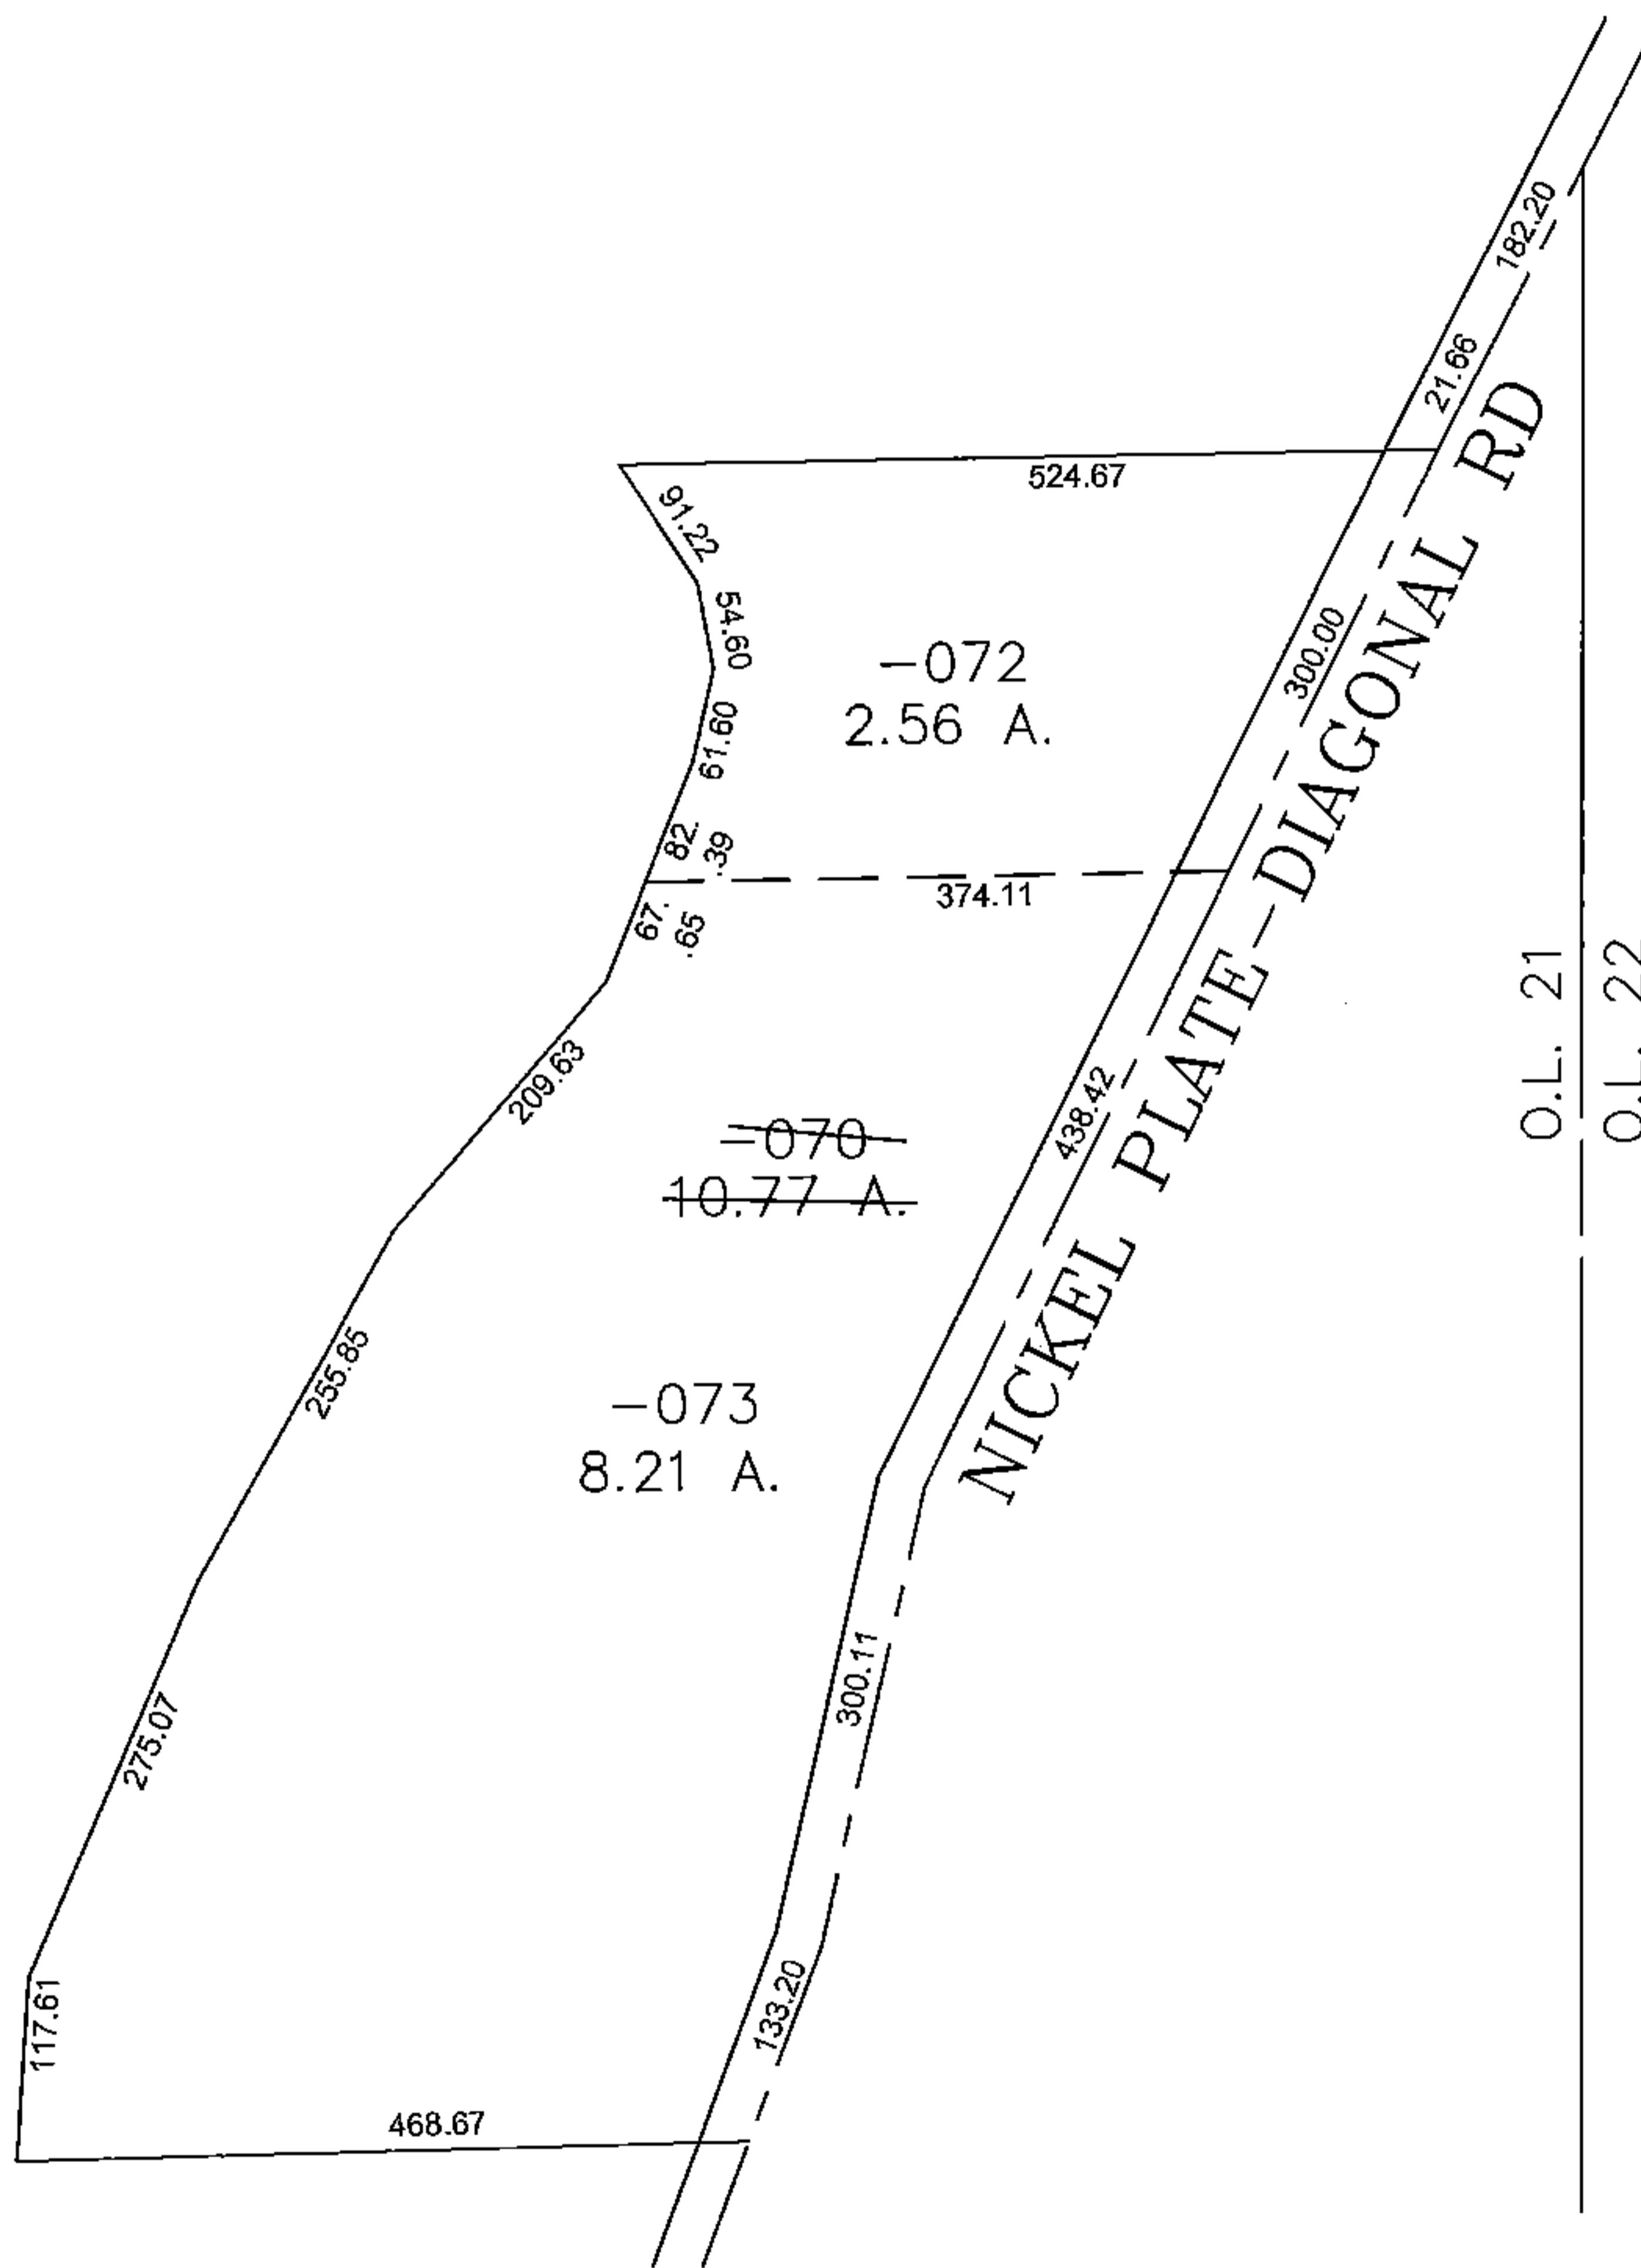


PARENT PARCEL: 10-00-021-000-070

CHILD PARCEL: 10-00-021-000-072, -073

STARTING POINT: CENTERLINE OF NICKEL PLATE-DIAGONAL RD & O.L. 21

14-03297

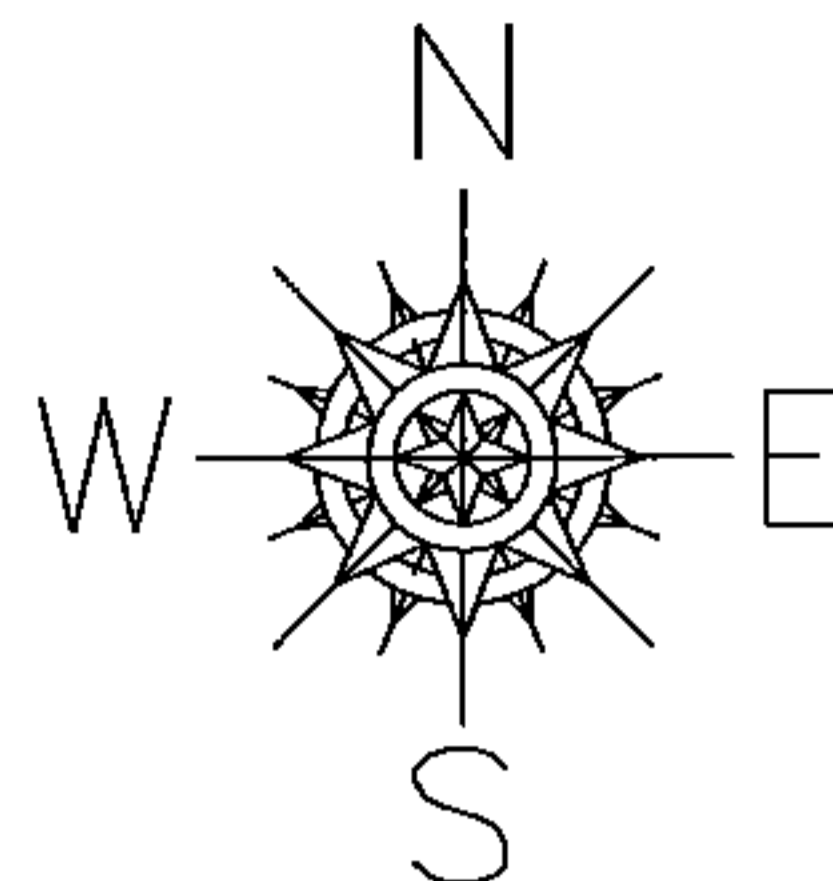

SPLITS/DEEDS PROCESSED

LORAIN COUNTY TAX MAP DEPARTMENT
226 MIDDLE AVE. ELYRIA, OHIO

SURVEYED BY: THOMAS SIMON

CLOSURE: 0.00 : 10.000

MAP PAGE(S): 10-00-021-A

APPROVED BY: JAH DATE: 10/20/2014

SCALE: 1" = 200 PRIOR INSTRUMENT: 20100337235