

PARENT PARCEL: 01-00-003-640-001




CHILD PARCEL: 01-00-003-640-010, -011

STARTING POINT: SOUTHEAST CORNER OF S/L 78 IN VERMILION ON THE LAKE SUB. NO.1(VOL.10 PG.18)

14-03298

**SUBMERGED LAND LEASE**

SUB-2099-LO

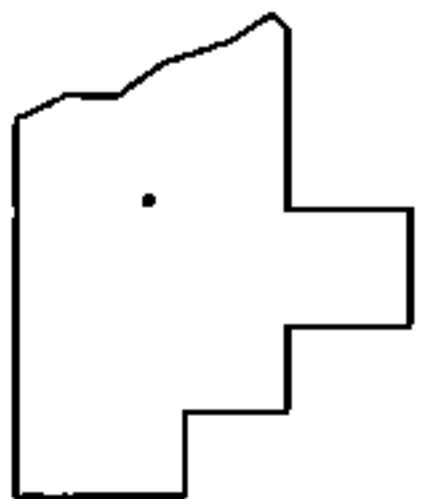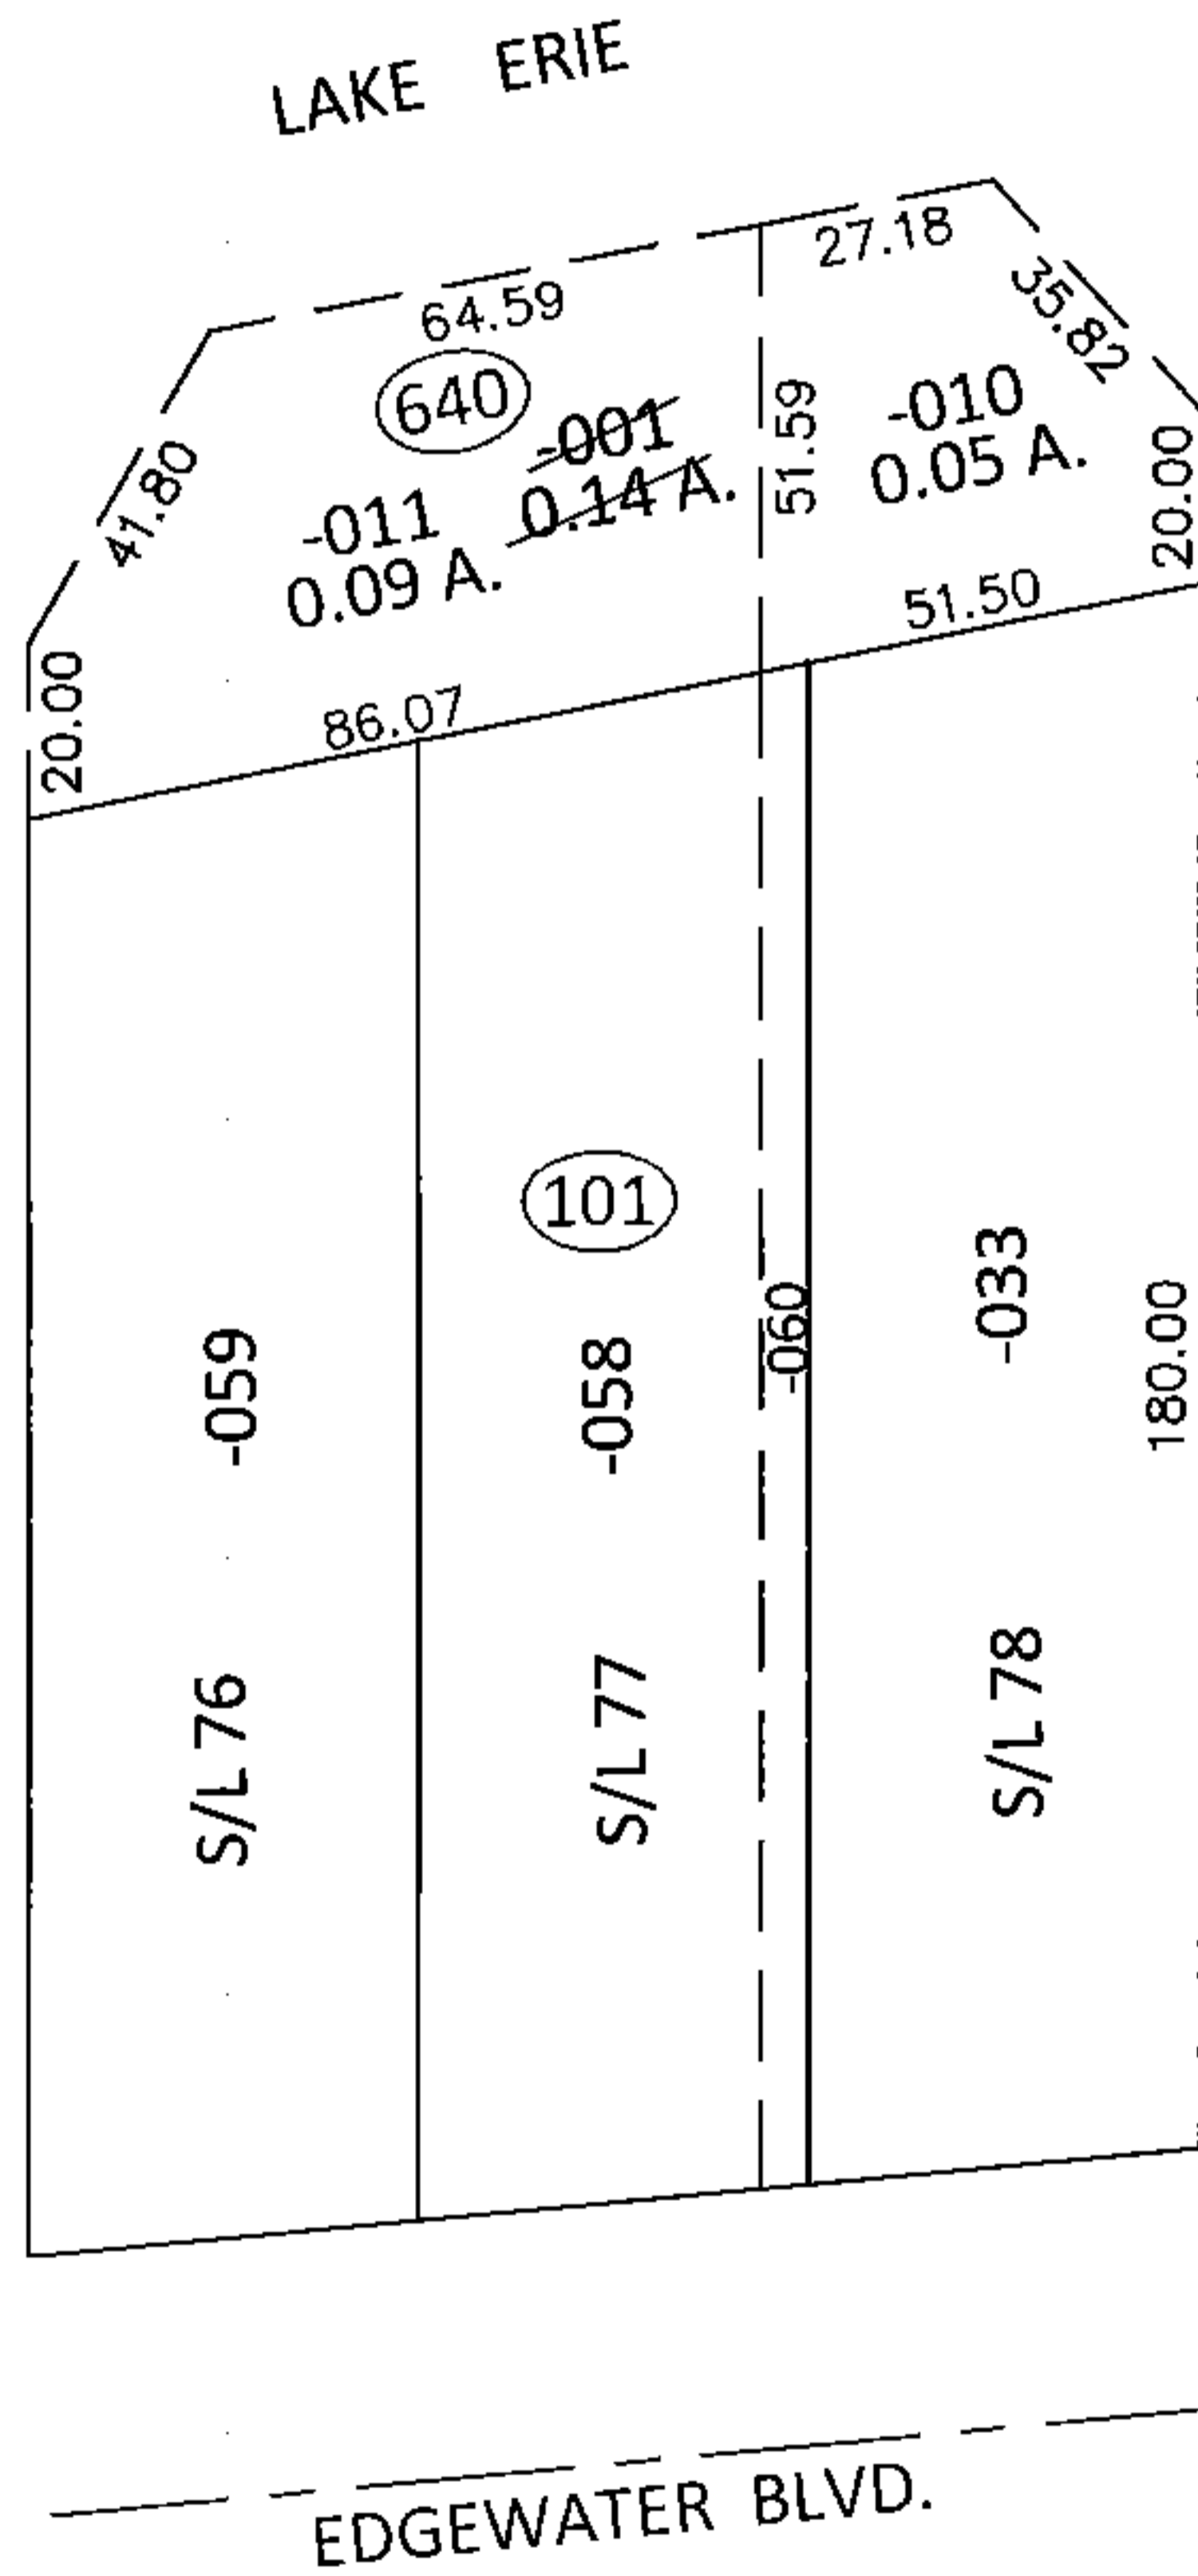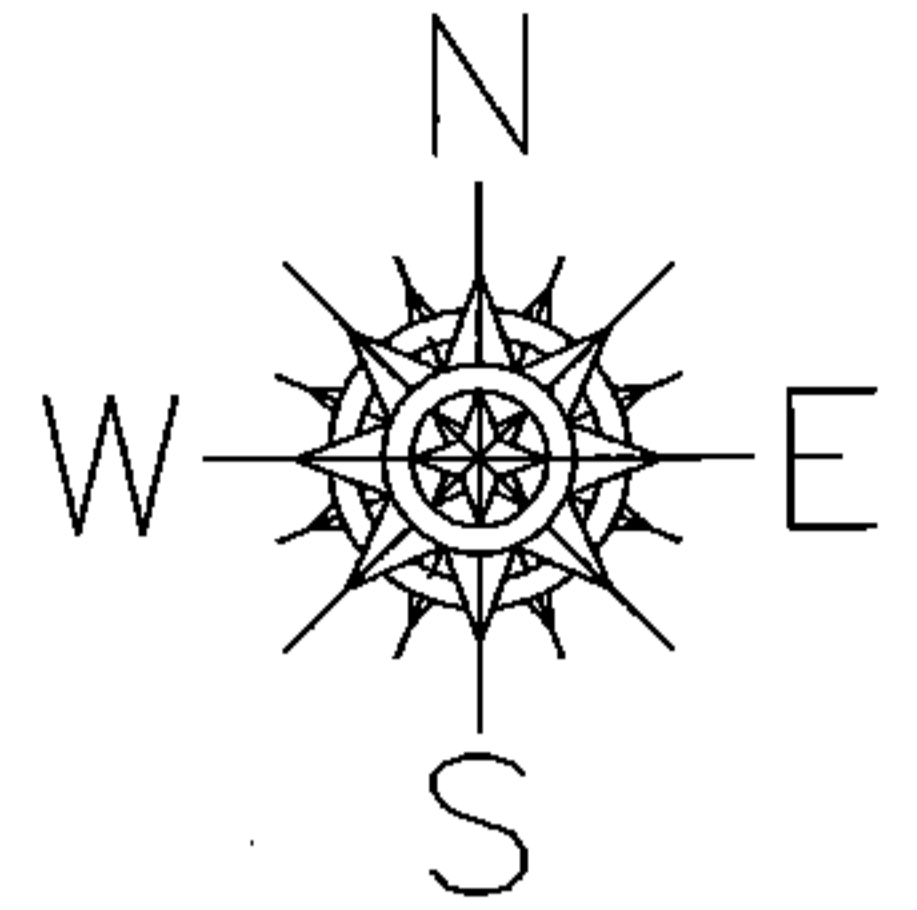

**SPLITS/DEEDS PROCESSED**

LORAIN COUNTY TAX MAP DEPARTMENT  
226 MIDDLE AVE. ELYRIA, OHIO

SURVEYED BY: M.G. HURA

CLOSURE: .01:10,000

MAP PAGE(S): 1-00-003-B

APPROVED BY: RRM DATE: 10-22-14

SCALE: 1"= 50' PRIOR INST.: 19990657179