
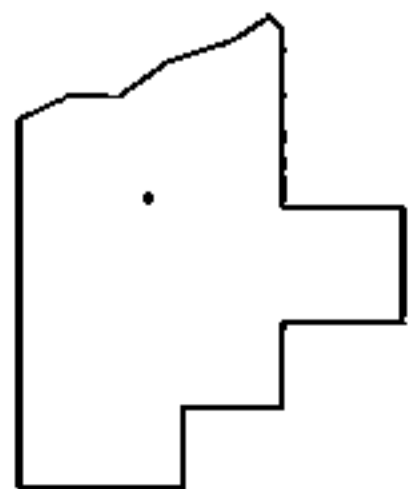
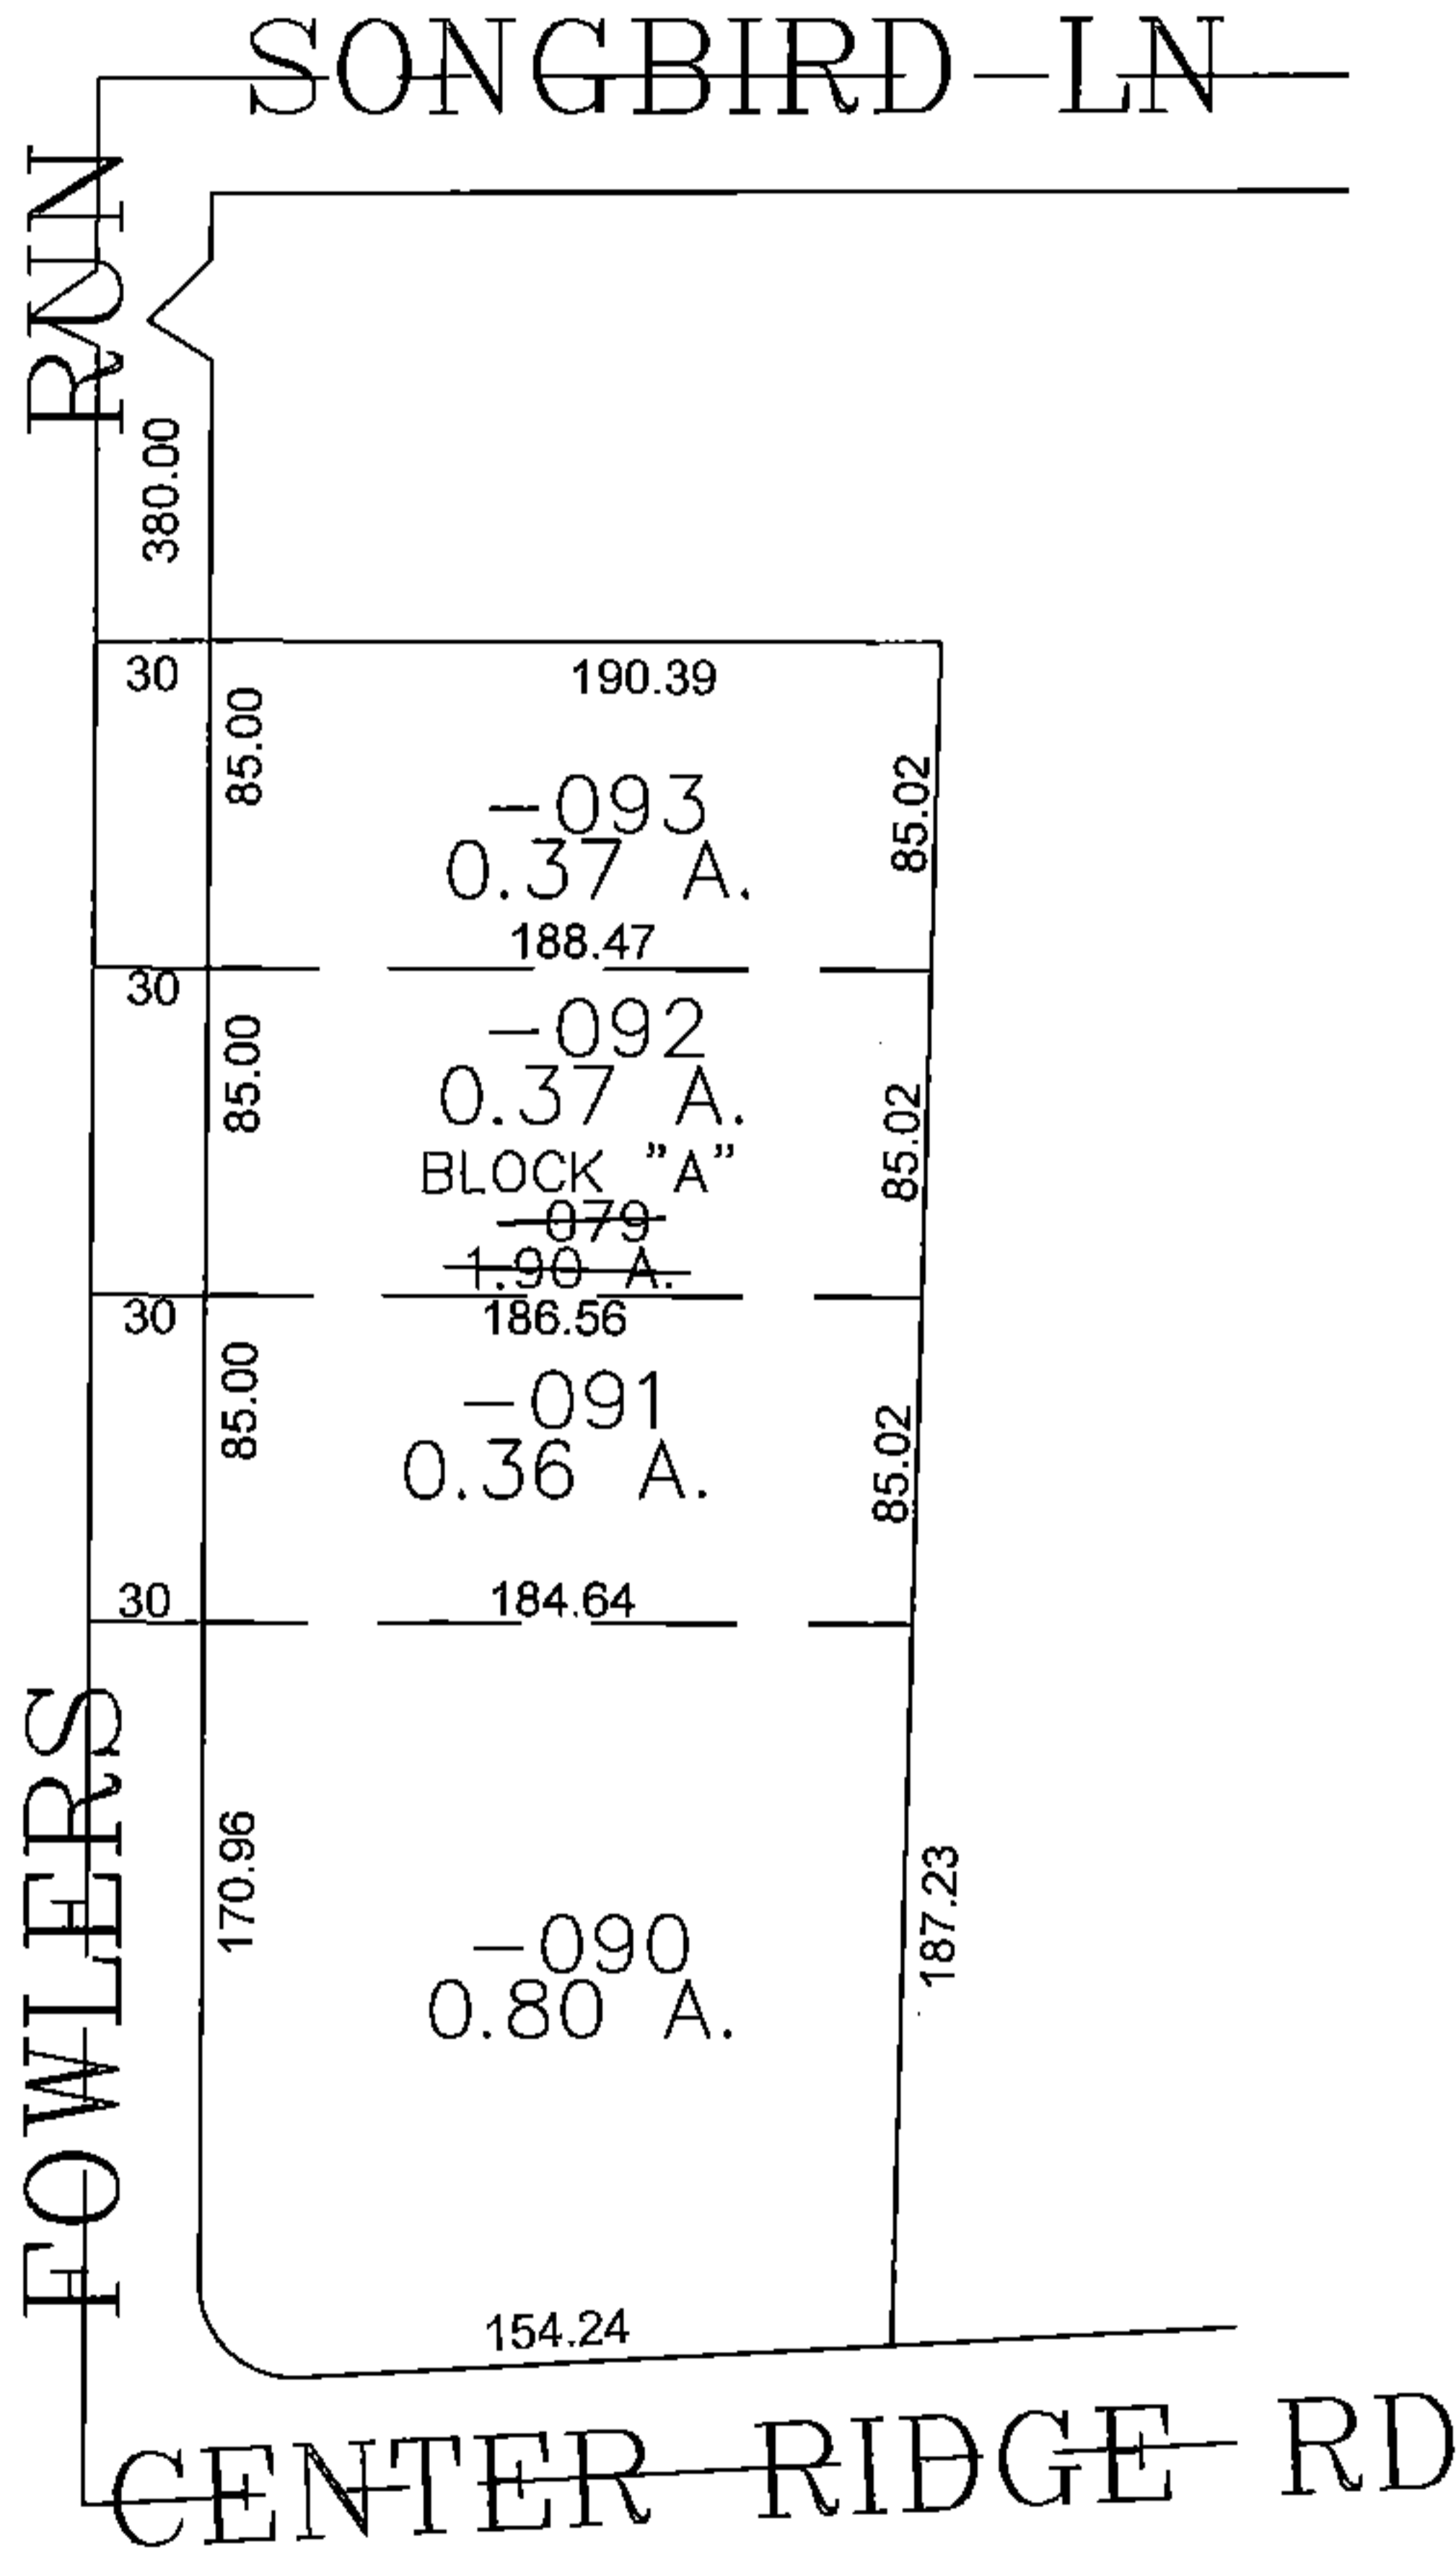


PARENT PARCEL: 07-00-039-000-079

CHILD PARCEL: 07-00-039-000-090 THRU -093

STARTING POINT: CENTERLINE OF SONGBIRD LN & FOWLERS RUN

14-03300

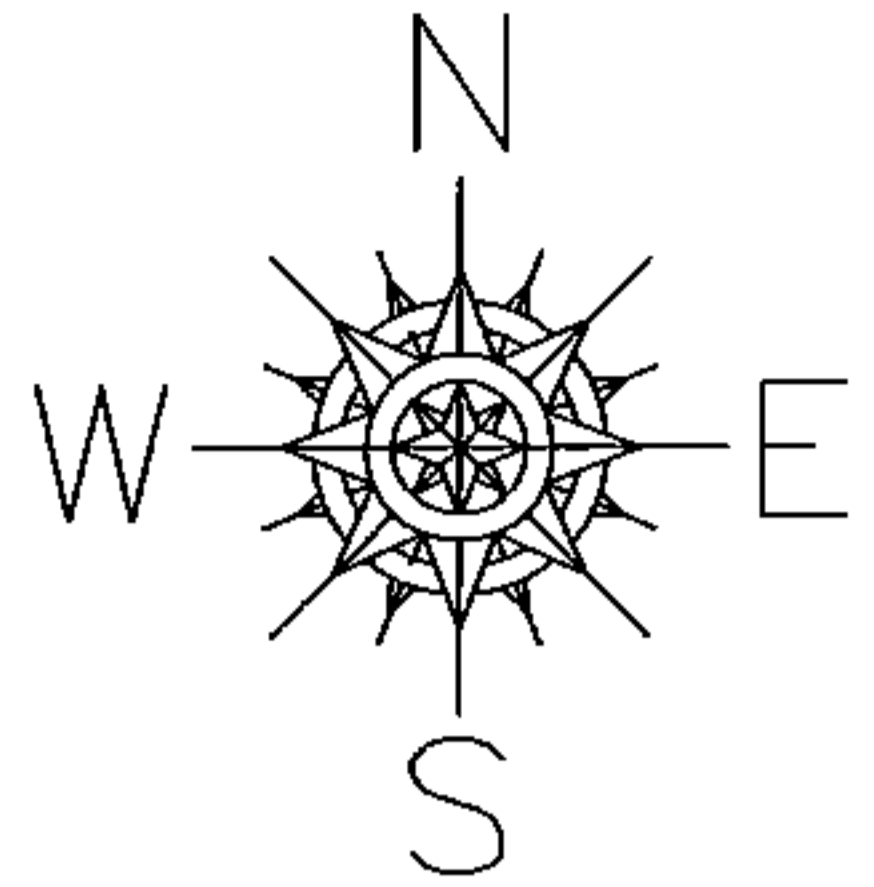

SPLITS/DEEDS PROCESSED

LORAIN COUNTY TAX MAP DEPARTMENT  
226 MIDDLE AVE. ELYRIA, OHIO

SURVEYED BY: THOMAS SIMON  
 CLOSURE: 0.00 : 10,000  
 MAP PAGE(S): 7-E  
 APPROVED BY: JAH DATE: 10/27/2014  
 SCALE: 1" = 100 PRIOR INSTRUMENT: PLT VL 87/1