
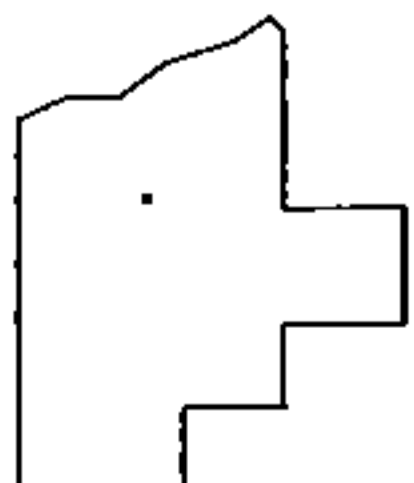
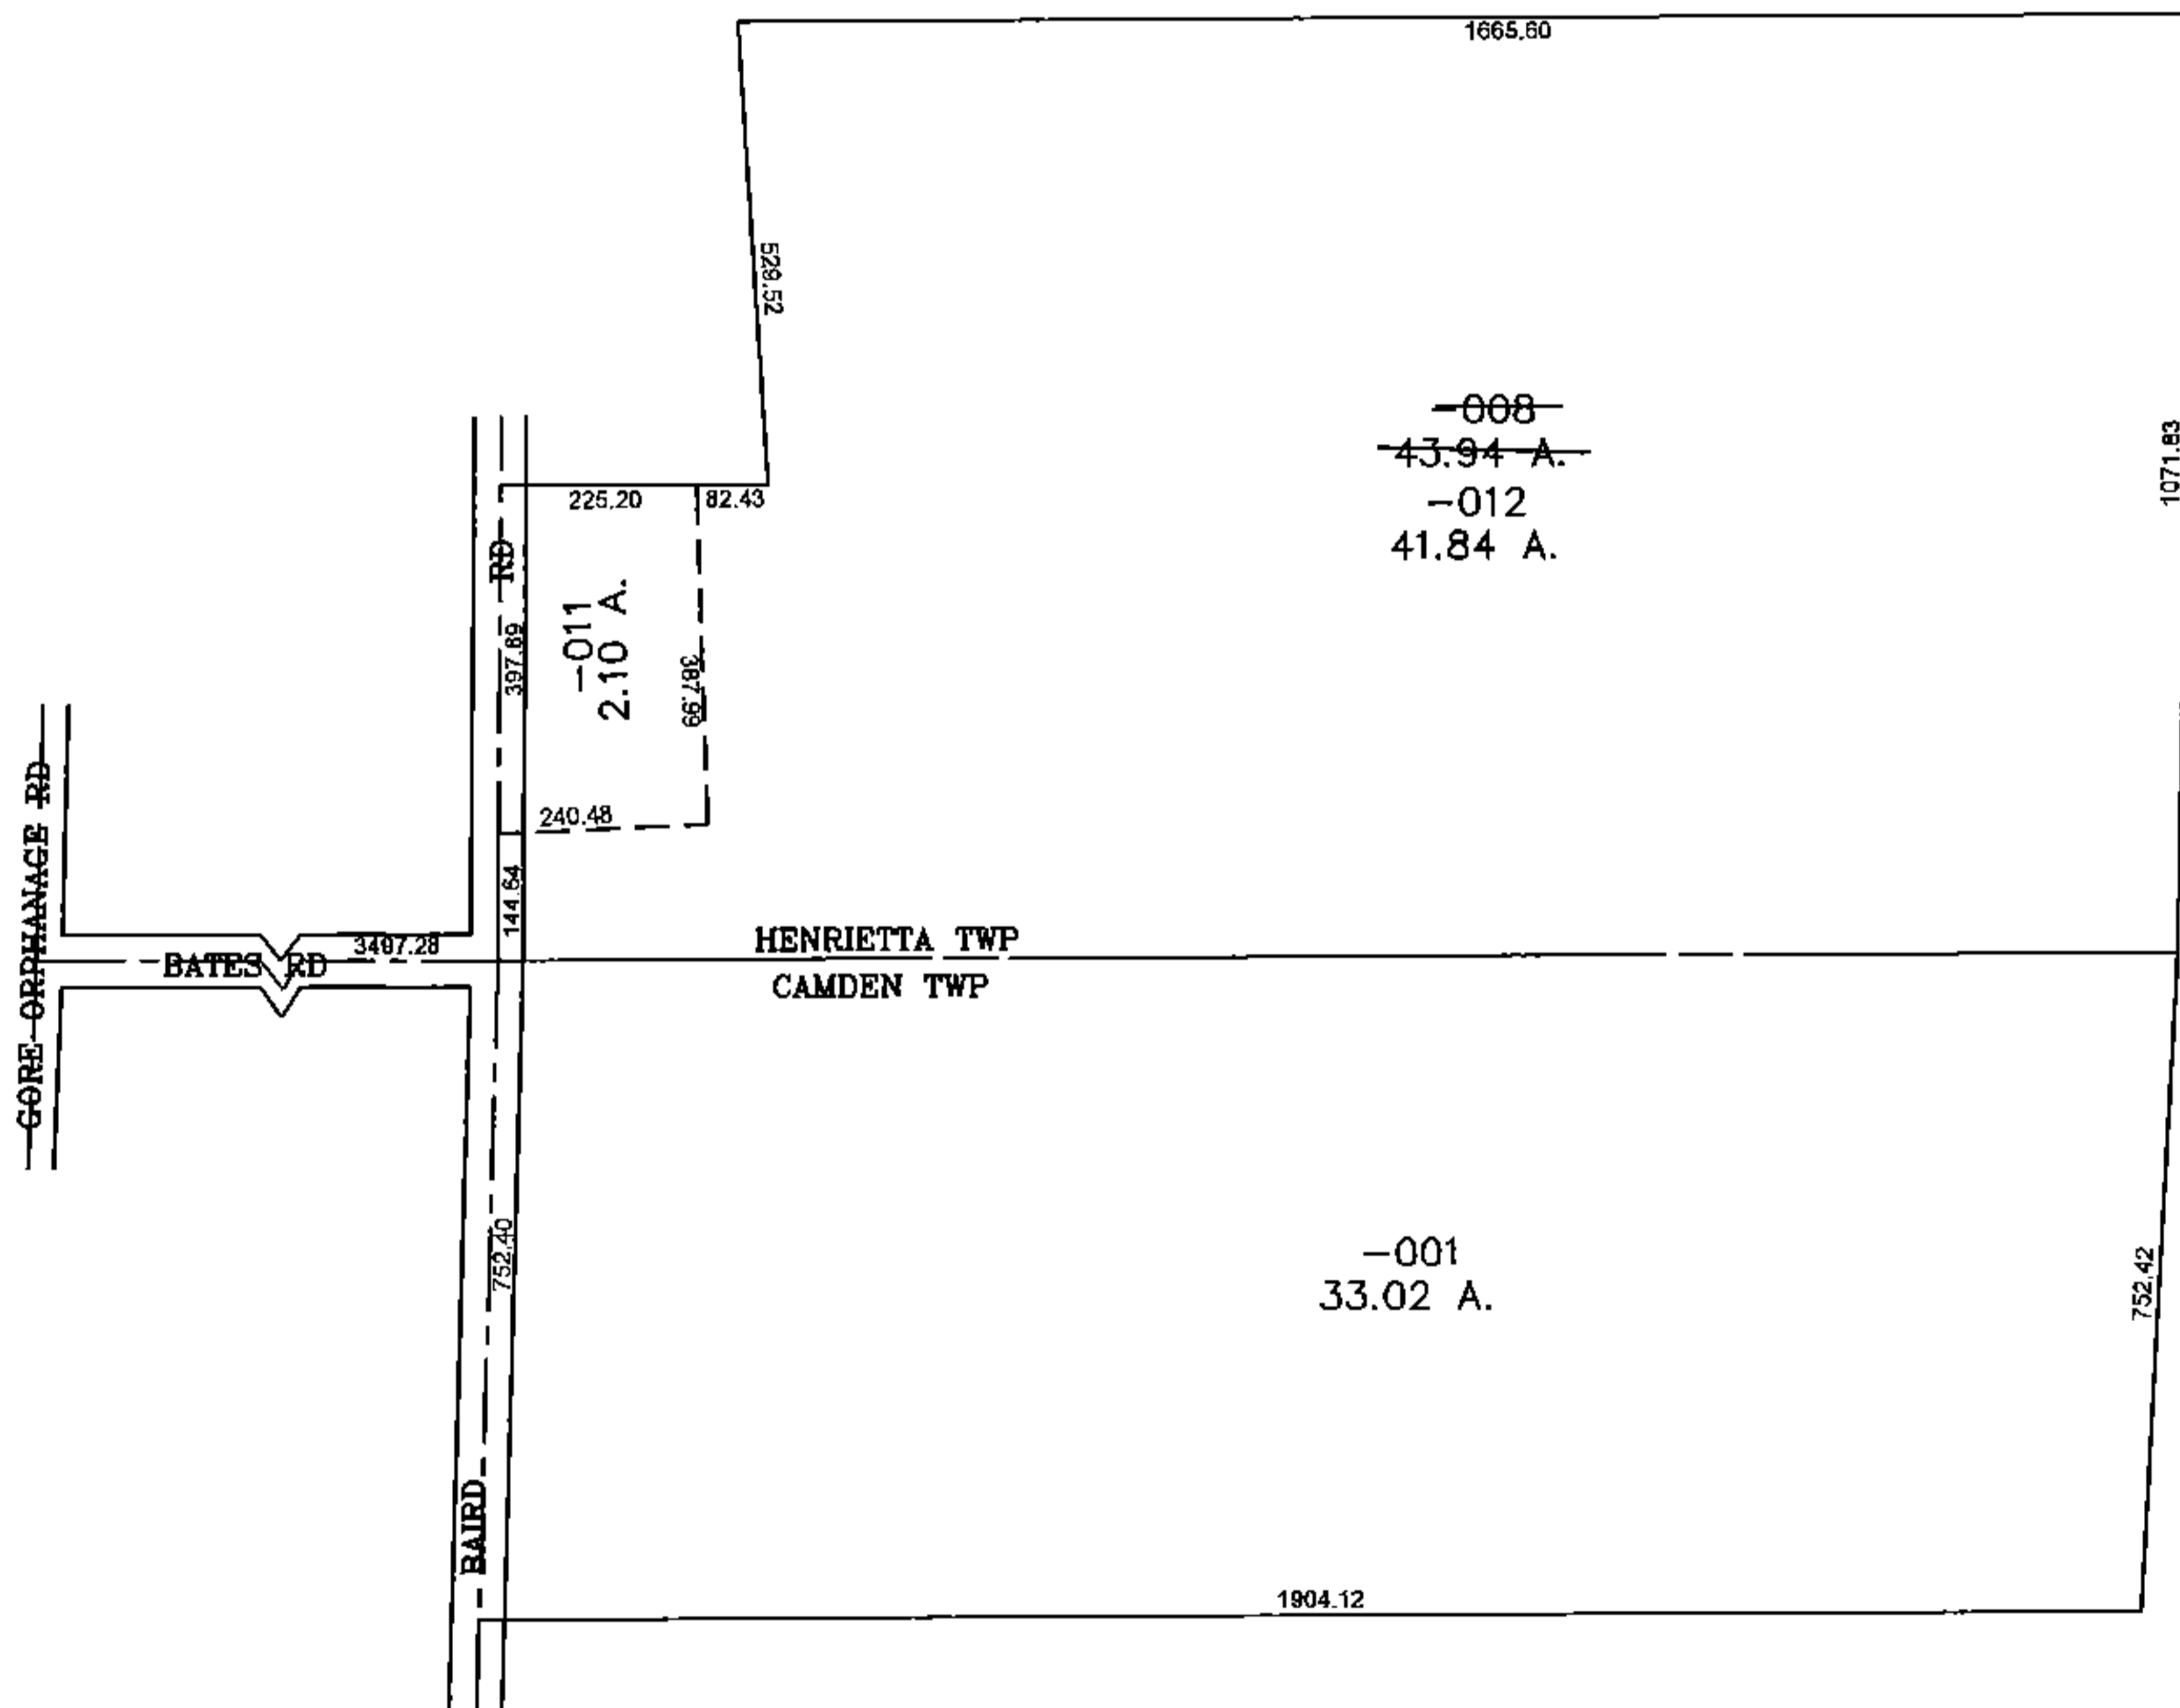


PARENT PARCEL: 08-12-014-000-008, 13-11-004-000-001

CHILD PARCEL: 08-12-014-000-011, -012

STARTING POINT: CENTERLINE OF GORE ORPHANAGE RD & BATES RD

14-03301

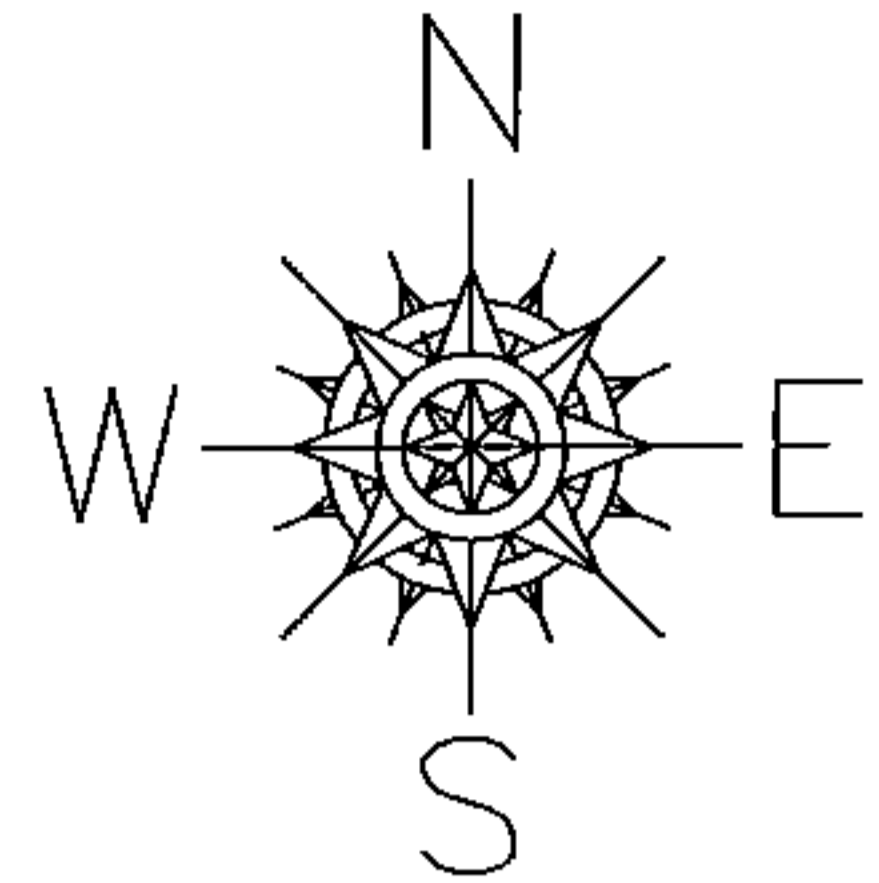

SPLITS/DEEDS PROCESSED

LORAIN COUNTY TAX MAP DEPARTMENT
226 MIDDLE AVE. ELYRIA, OHIO

SURVEYED BY: PATRICK MCGANNON

CLOSURE: 0.00 : 10,000

MAP PAGE(S): 8-F

APPROVED BY: JAH DATE: 10/30/2014

SCALE: 1" = 400 PRIOR INST.: 20140512927