
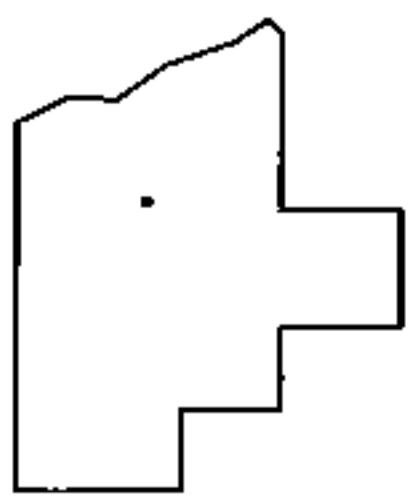
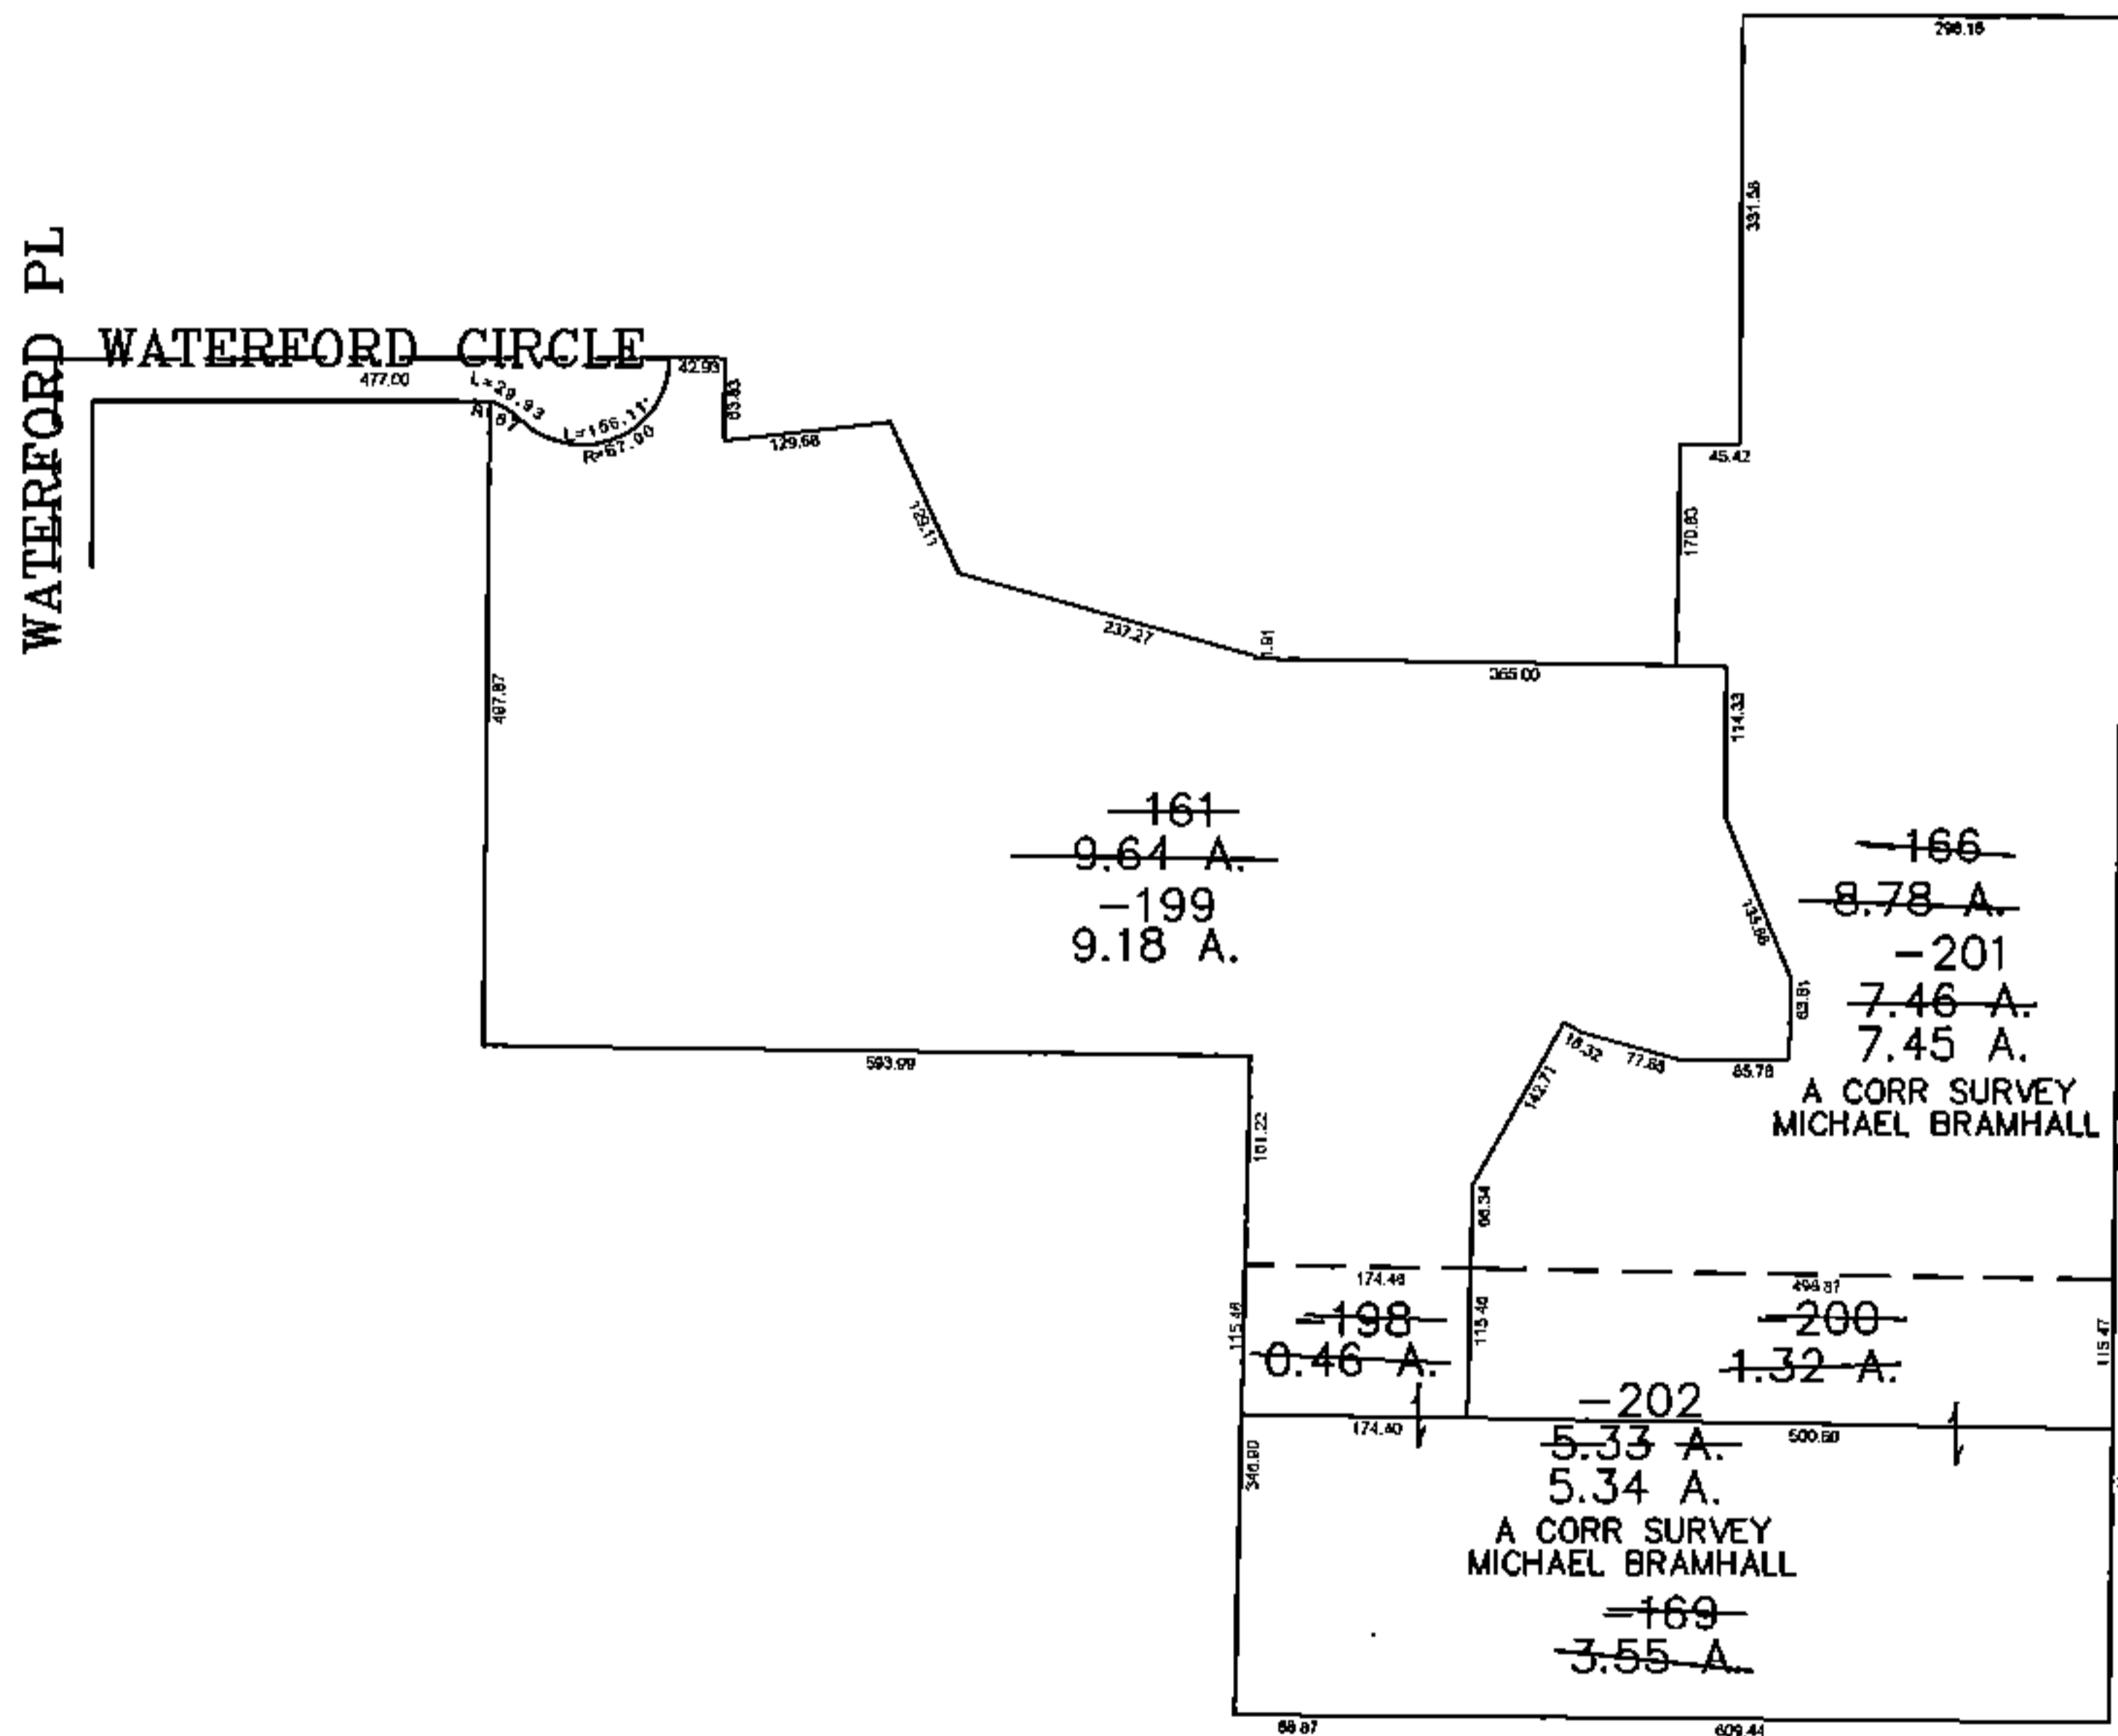


PARENT PARCEL: 03-00-001-000-161, -166, -169

CHILD PARCEL: 03-00-001-198 THRU -202

STARTING POINT: CENTERLINE OF WATERFORD PLACE & WATERFORD CIRCLE

14-03302

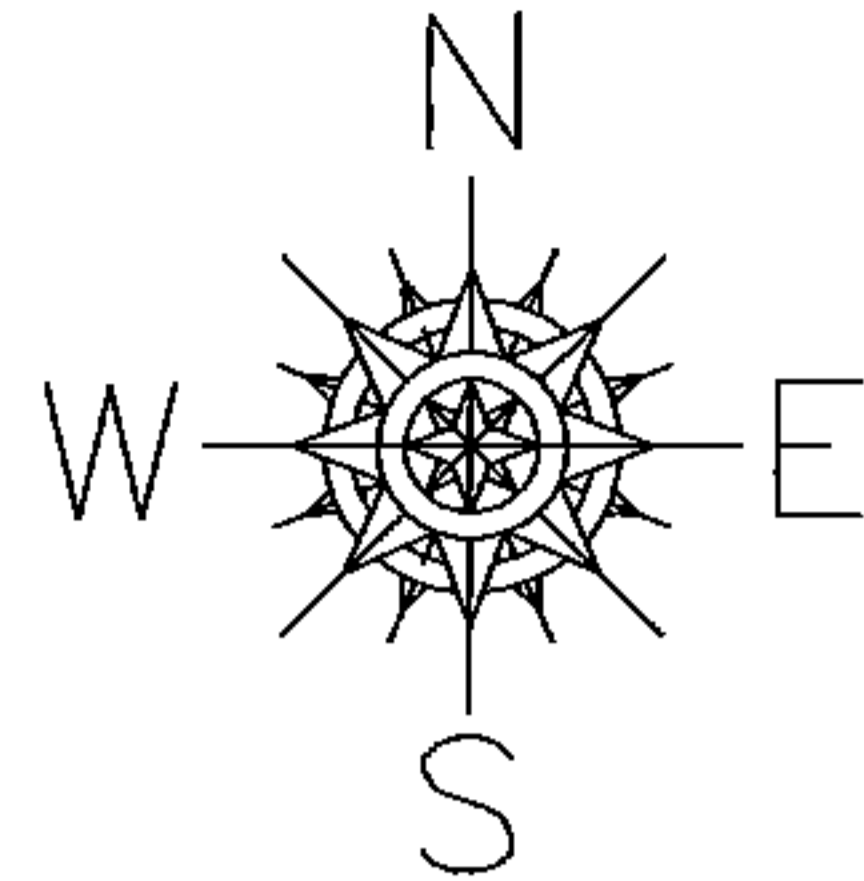

SPLITS/DEEDS PROCESSED
 LORAIN COUNTY TAX MAP DEPARTMENT
 226 MIDDLE AVE. ELYRIA, OHIO

SURVEYED BY: MICHAEL BRAMHALL
 CLOSURE: 0.00 : 10.000
 MAP PAGE(S): 03-00-001-B
 APPROVED BY: JAH DATE: 10-31-2014
 SCALE: 1" = 300 PRIOR INSTRUMENT: 20040018131