

PARENT PARCEL: 06-25-158-000-023 & -030

CHILD PARCEL: XX-XX-XXX-XXX-XXX


STARTING POINT: S.E. CORNER OF S/L 39

15-03303-C

FRONTAGE & MAP CORRECTION

06-25-158-000-023
~~34.70 X 125.07~~
27.70 X 125.07
CORR. PER DV 628/560

06-25-158-000-030
~~104.70 X 305.07~~
111.70 X 305.07
CORR. PER DV 628/560
CORR. PER DV 1090/353
CORR. PER DV 1400/687

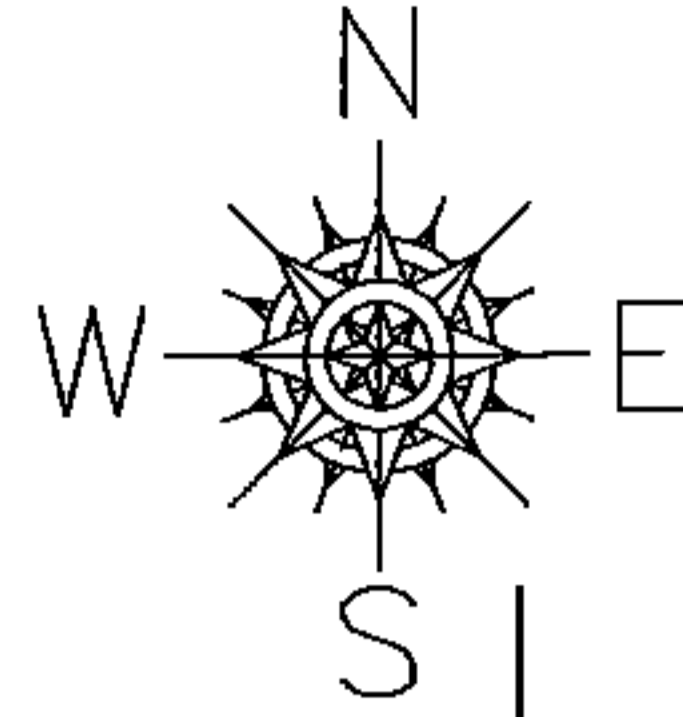

SPLITS/DEEDS PROCESSED

LORAIN COUNTY TAX MAP DEPARTMENT
226 MIDDLE AVE. ELYRIA, OHIO

SURVEYED BY: NA

CLOSURE: NA

MAP PAGE(S): 06-25-158

APPROVED BY: TJS DATE: 9/24/15

SCALE: 1"=50' PRIOR INST.: DV XXXX/XXX